


PARENT PARCEL: 15-00-055-900-003  
 CHILD PARCEL: XX-XX-XXX-XXX-XXX  
 STARTING POINT: XXXXXX

**11-02265-C**


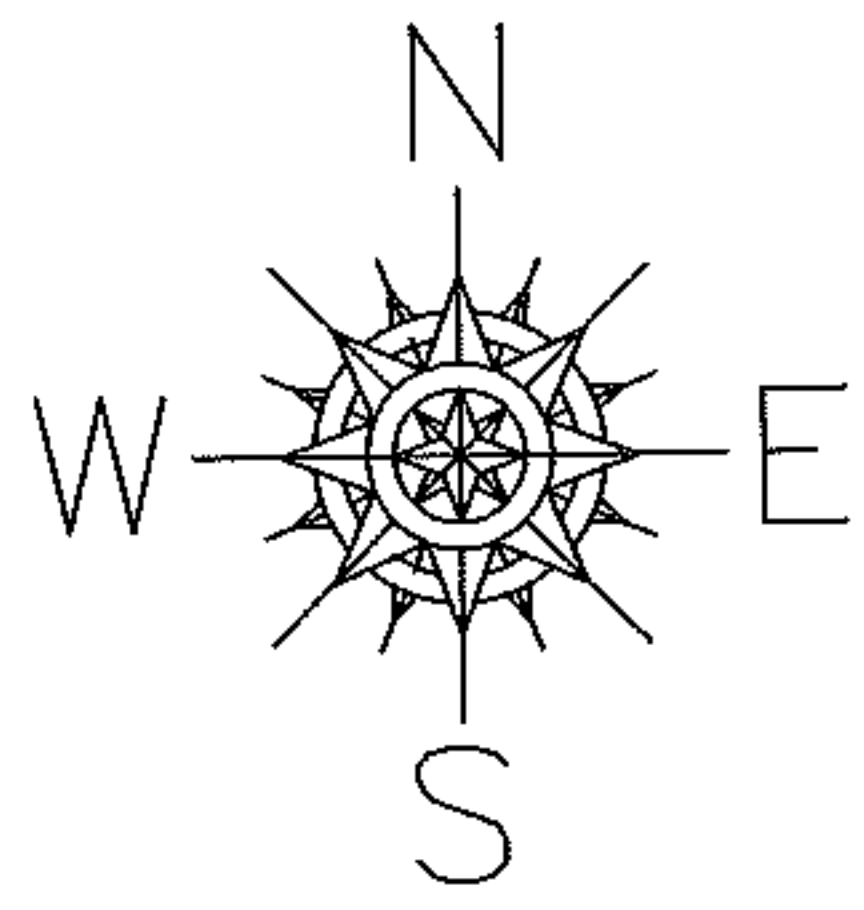


**CERTIFICATE OF CORRECTION**

OPPORTUNITY WAY STREET DEDICATION PLAT

VOL. 95 PG. 52-56

15-00-055-900-003

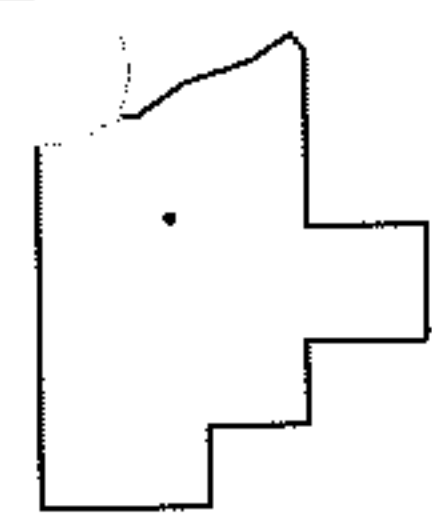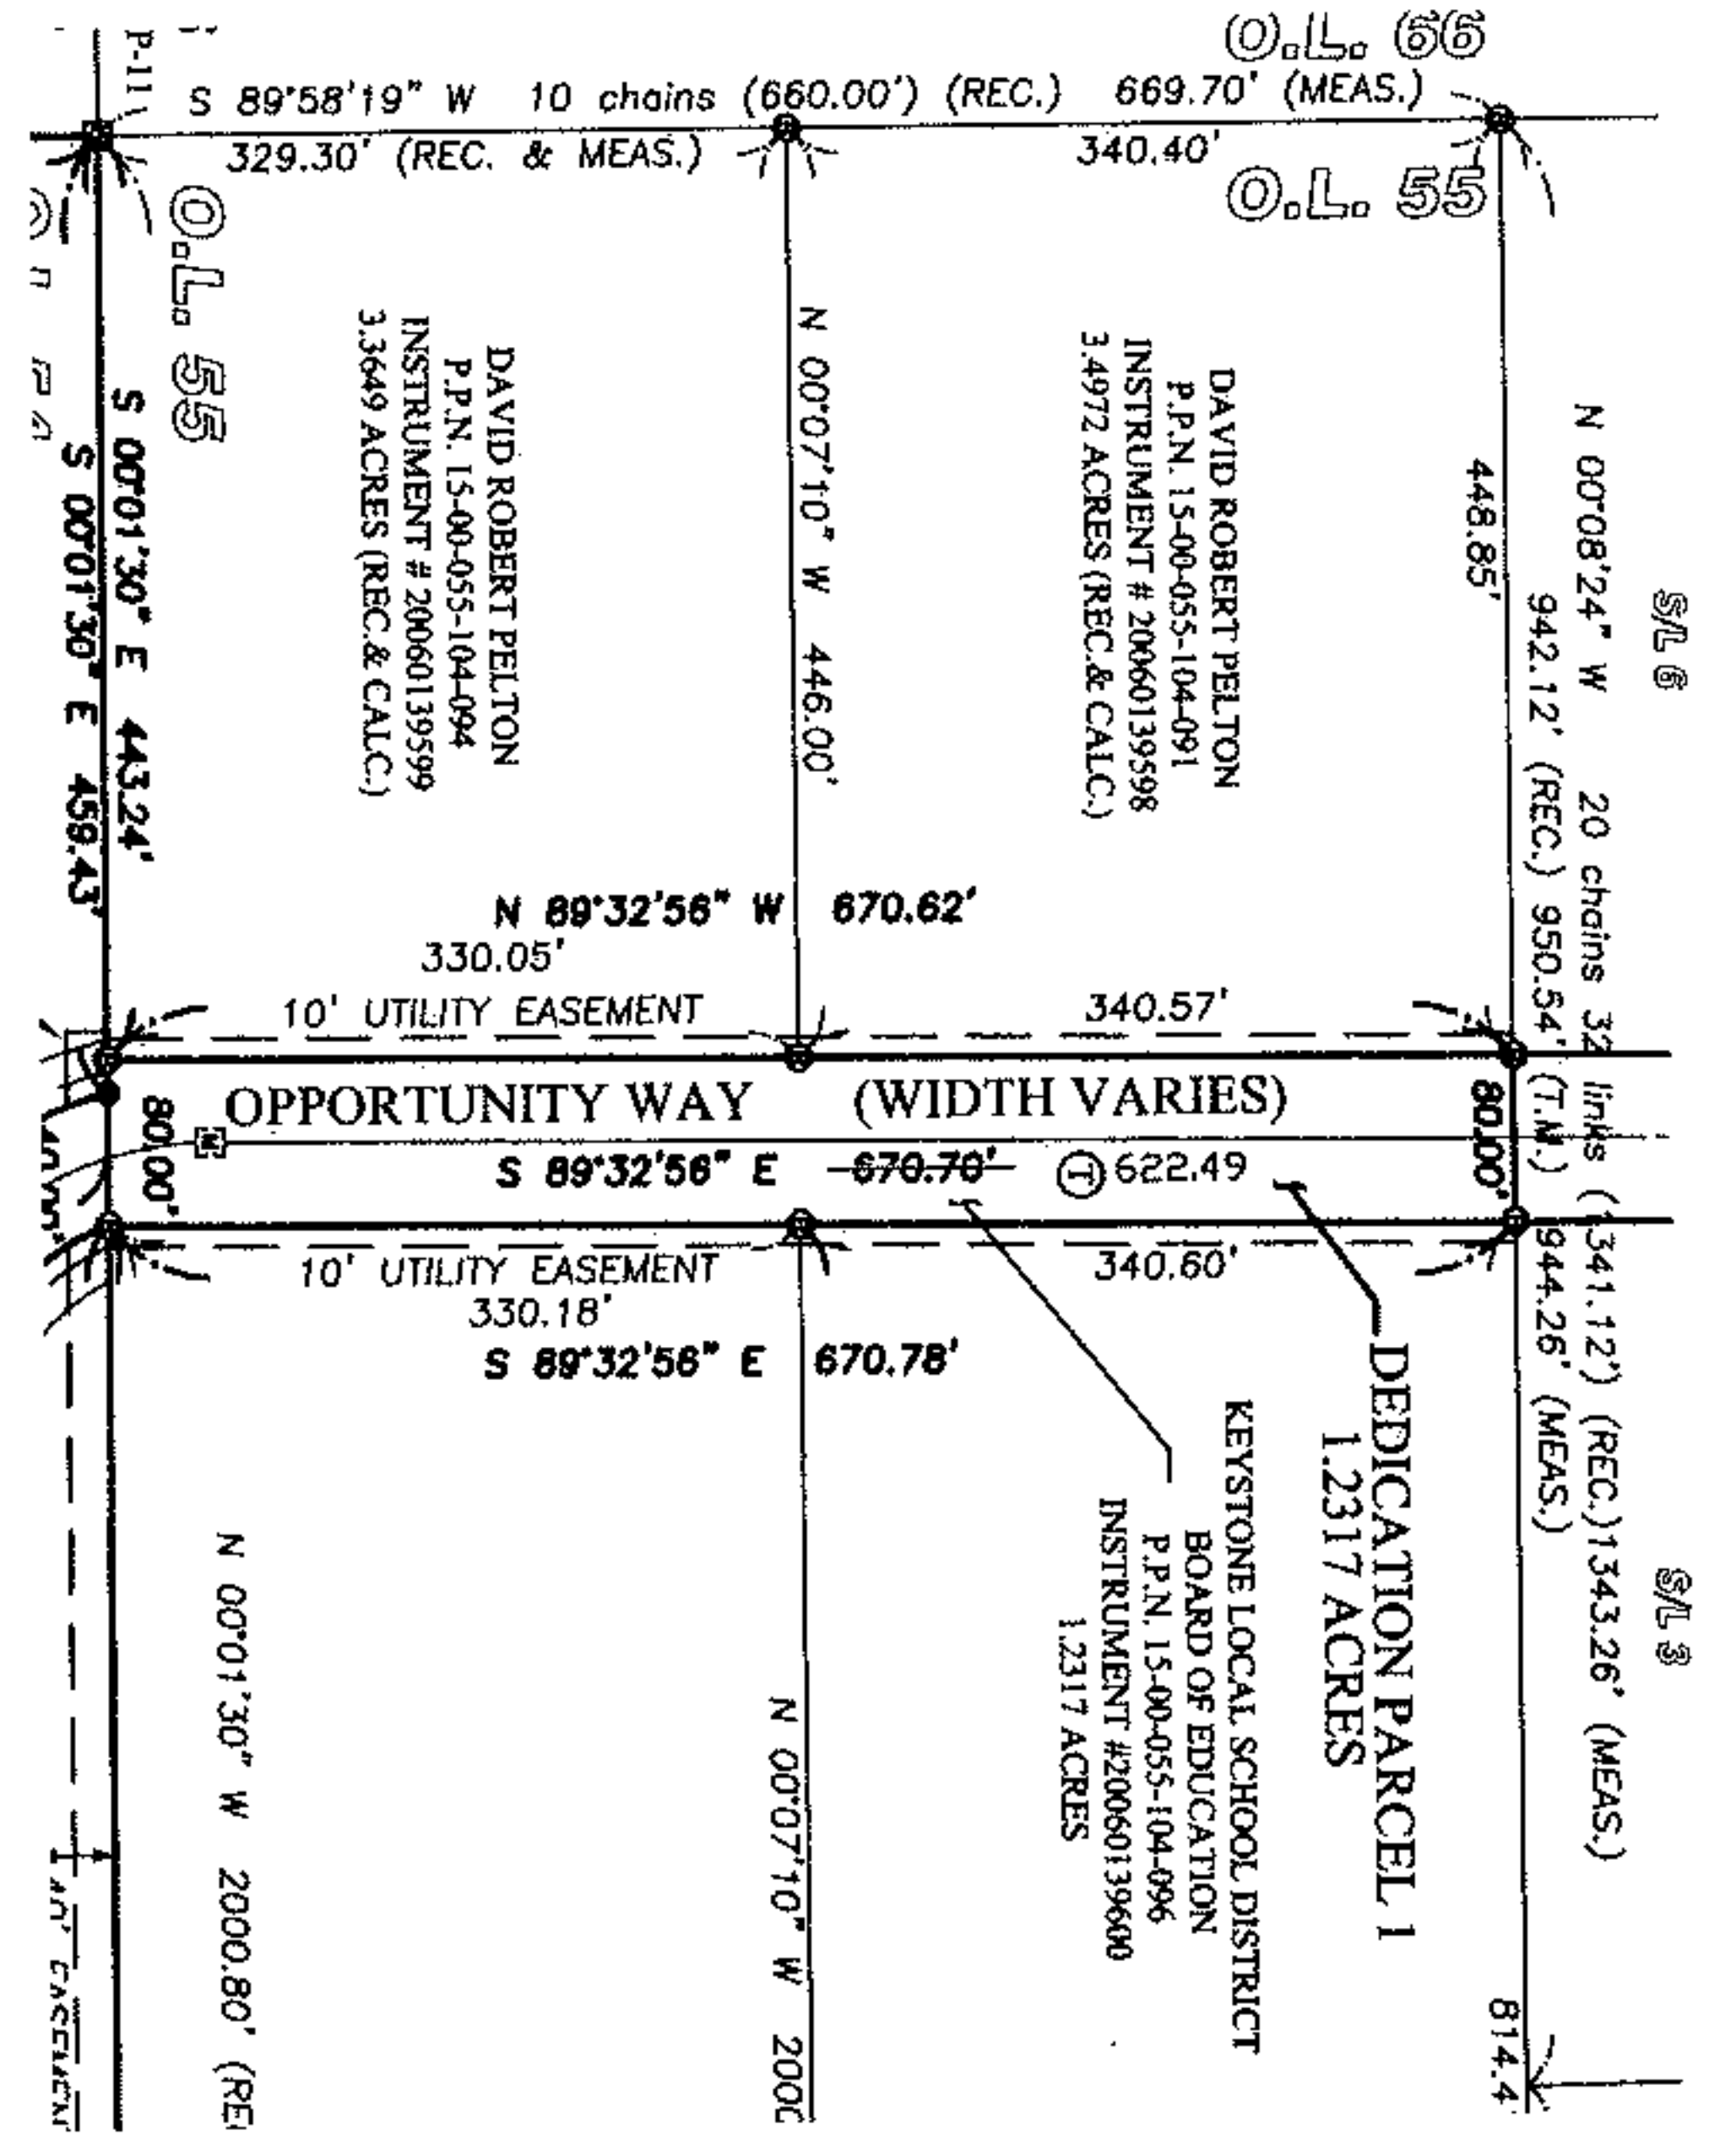

**SPLITS/DEEDS PROCESSED**  
 LORAIN COUNTY TAX MAP DEPARTMENT  
 226 MIDDLE AVE. ELYRIA, OHIO

SURVEYED BY: MICHAEL BRAMHALL  
 CLOSURE: XXXXXX  
 MAP PAGE(S): VOL. 95 PG. 52-56  
 APPROVED BY: TJS DATE: 3/16/11  
 SCALE: 1" = 50' PRIOR INST.: DV XXXX/XXX