
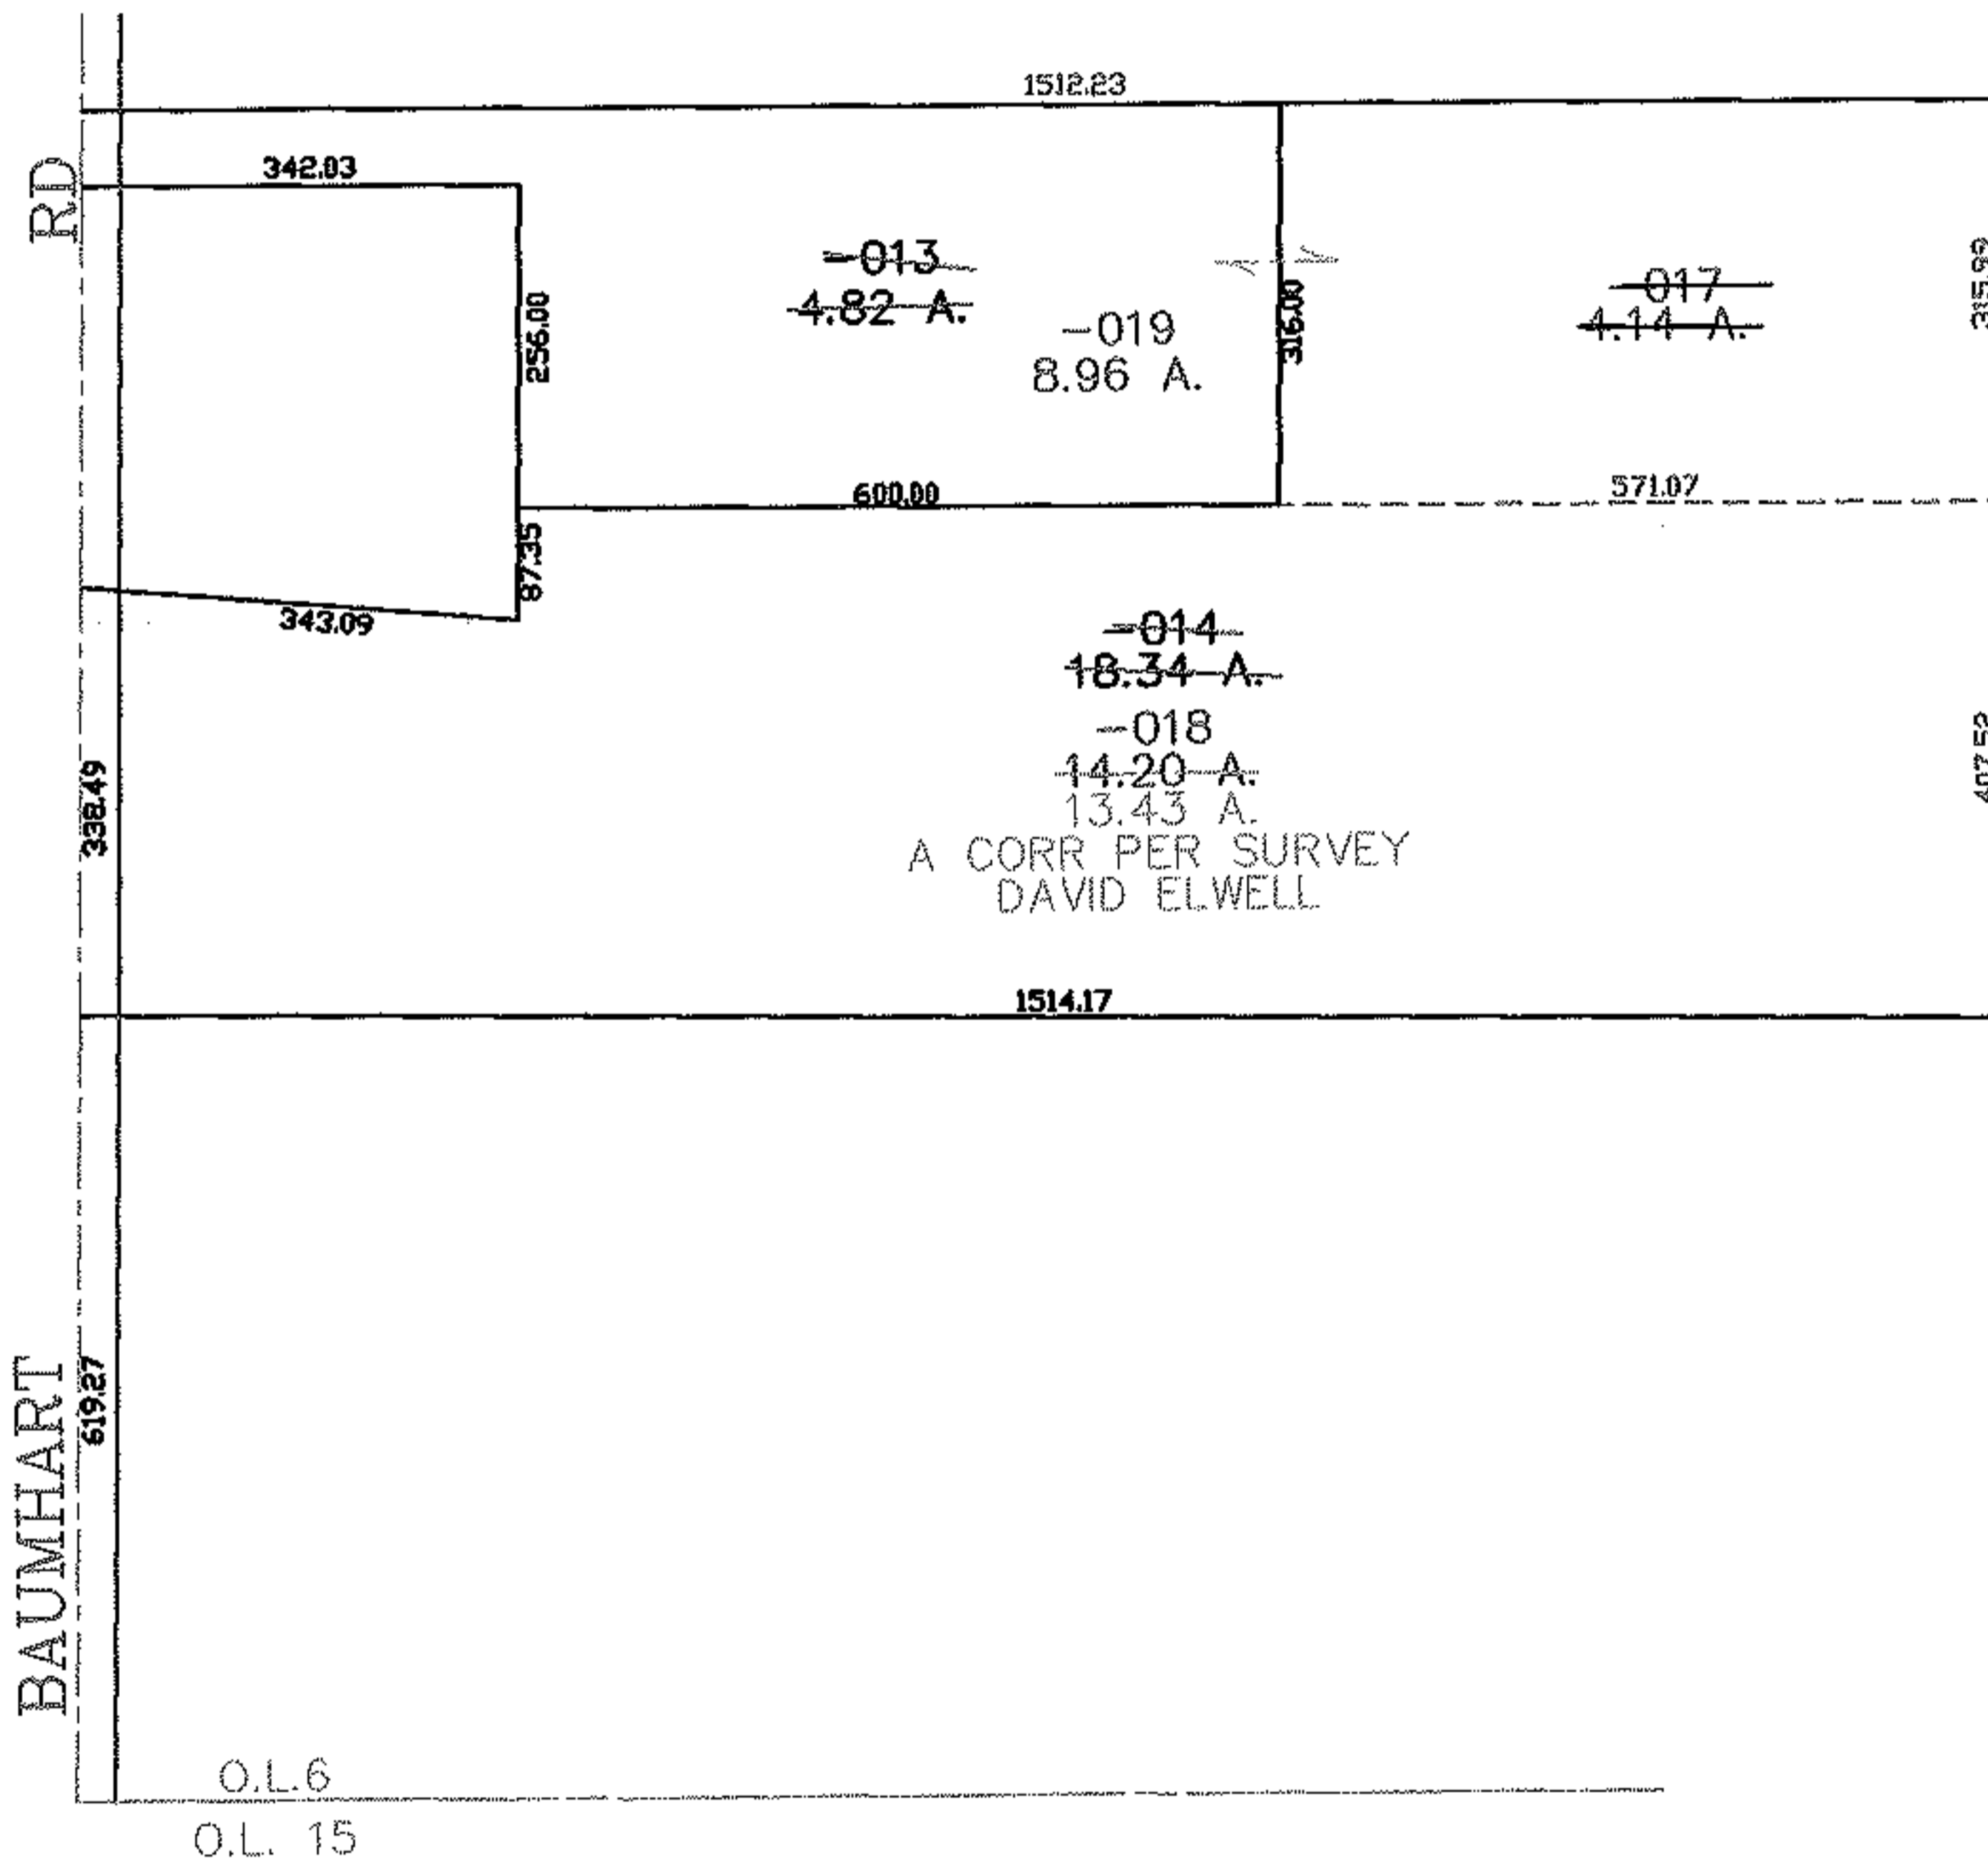


PARENT PARCEL: 08-15-006-000-014, -013
CHILD PARCEL: 08-15-006-000-017 THRU -019
STARTING POINT: CENTERLINE OF BAUMHART RD & O.L. 6

06-02267

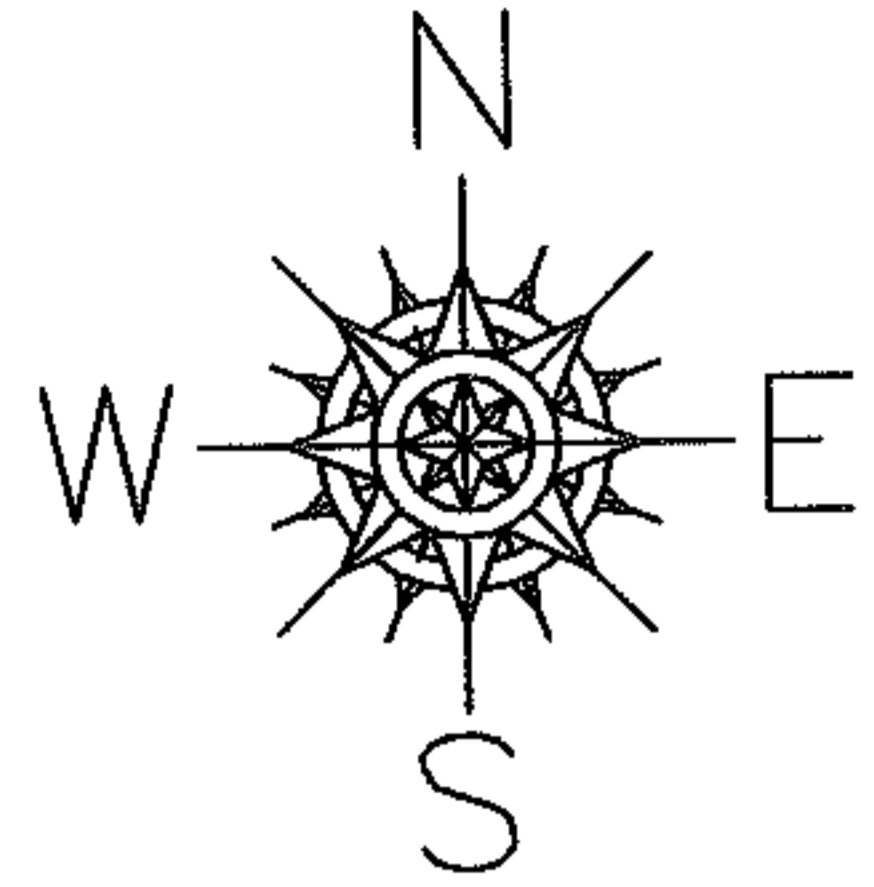

SPLITS/DEEDS PROCESSED
LORAIN COUNTY TAX MAP DEPARTMENT
226 MIDDLE AVE. ELYRIA, OHIO

SURVEYED BY: DAVID ELWELL
CLOSURE: 0.00 : 10.000
MAP PAGE(S): 8-**PD**
APPROVED BY: JAH DATE: 11-15-06
SCALE: 1" = 300 PRIOR INSTRUMENT: OR 645/921