
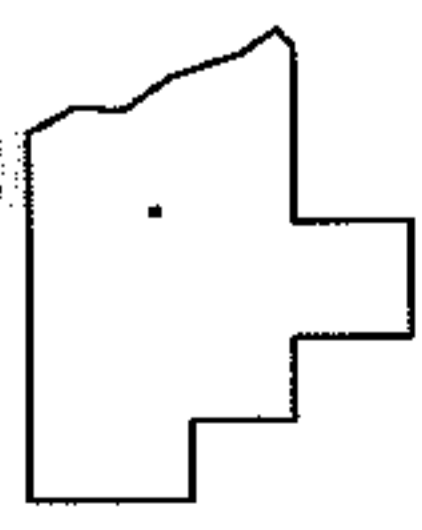
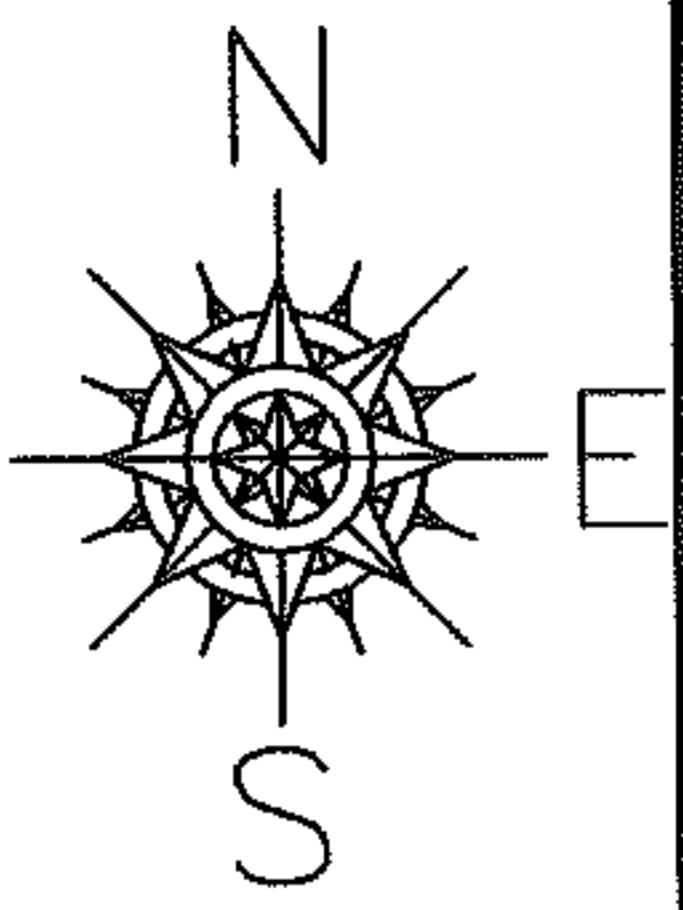


PARENT PARCEL: 18-00-004-000-004, -012

CHILD PARCEL: 18-00-004-000-017 THRU -024

STARTING POINT: CENTERLINE OF WEST RD & O.L. 4

06-02268

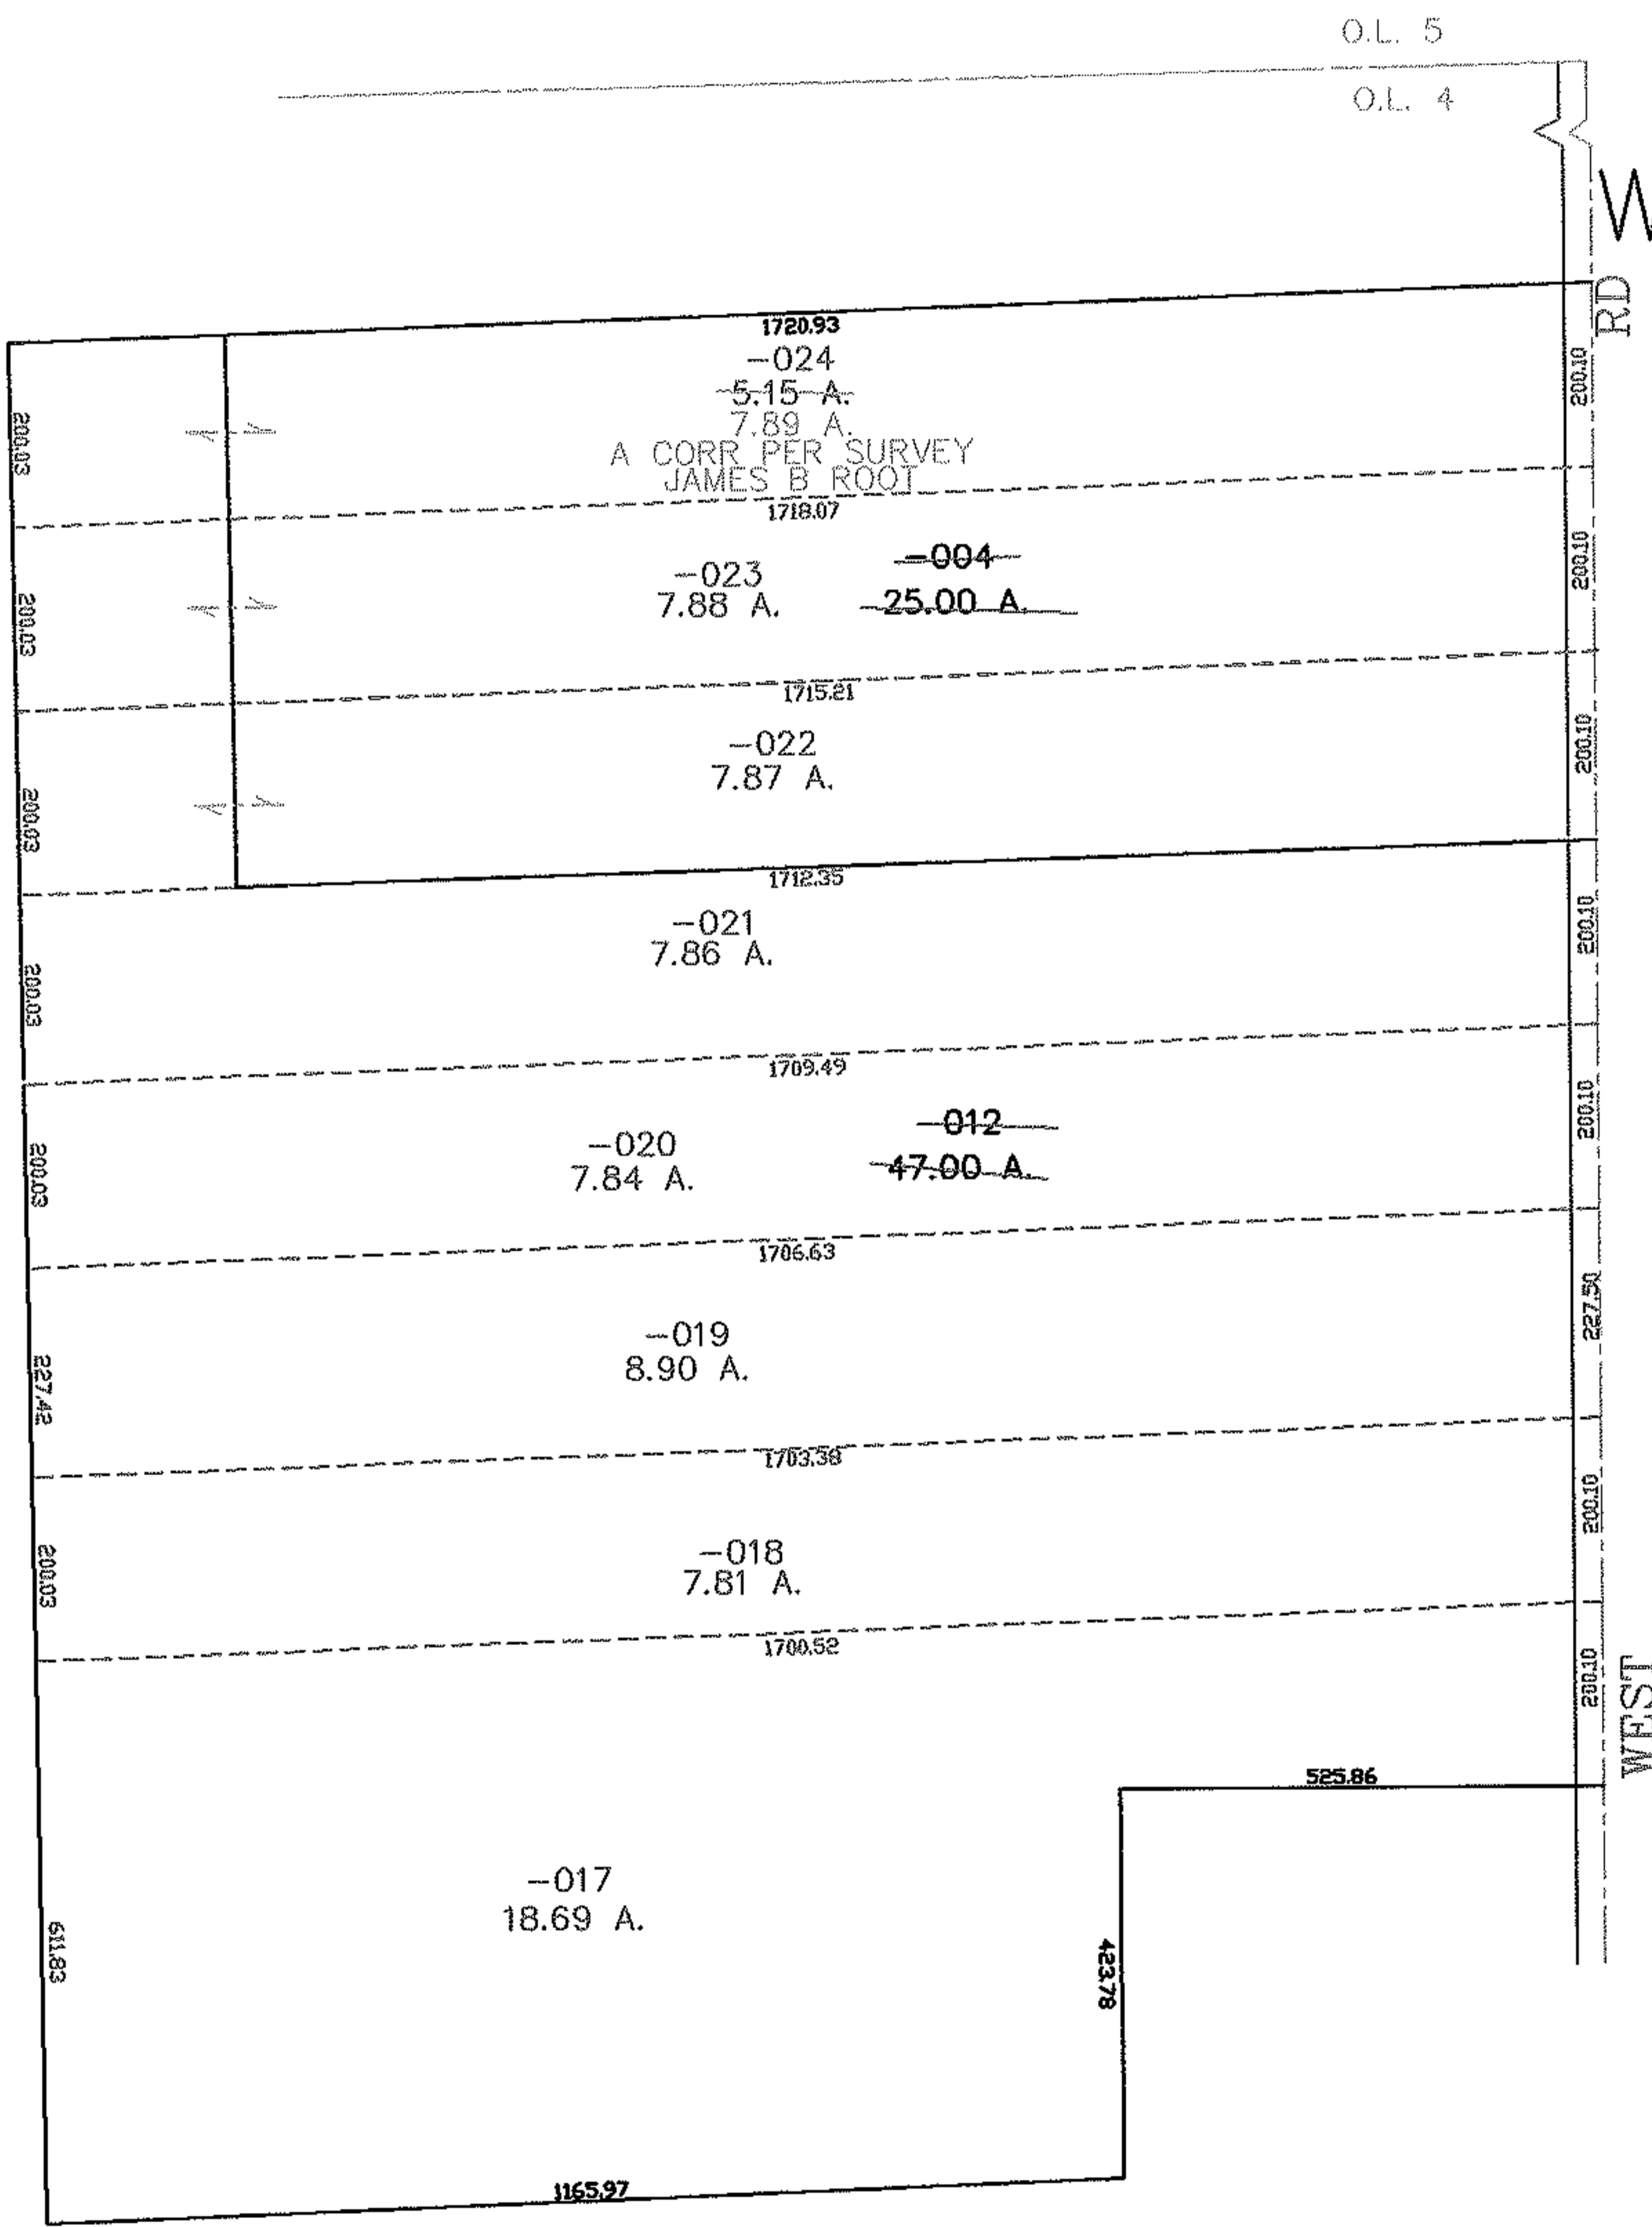

SPLITS/DEEDS PROCESSED
LORAIN COUNTY TAX MAP DEPARTMENT
226 MIDDLE AVE. ELYRIA, OHIO

SURVEYED BY: JAMES B ROOT
 CLOSURE: 0.00 : 10.000
 MAP PAGE(S): 18-D
 APPROVED BY: JAH DATE: 11-17-06
 SCALE: 1" = 300 PRIOR INSTRUMENT: 19980558934