
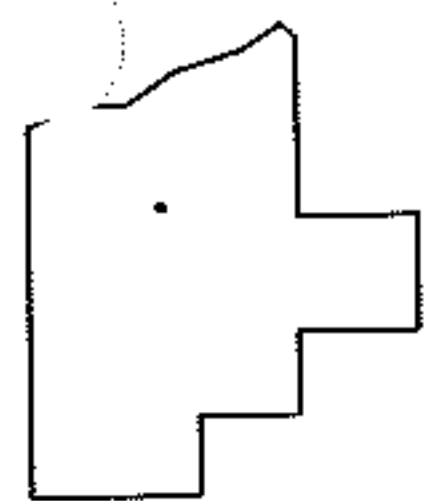
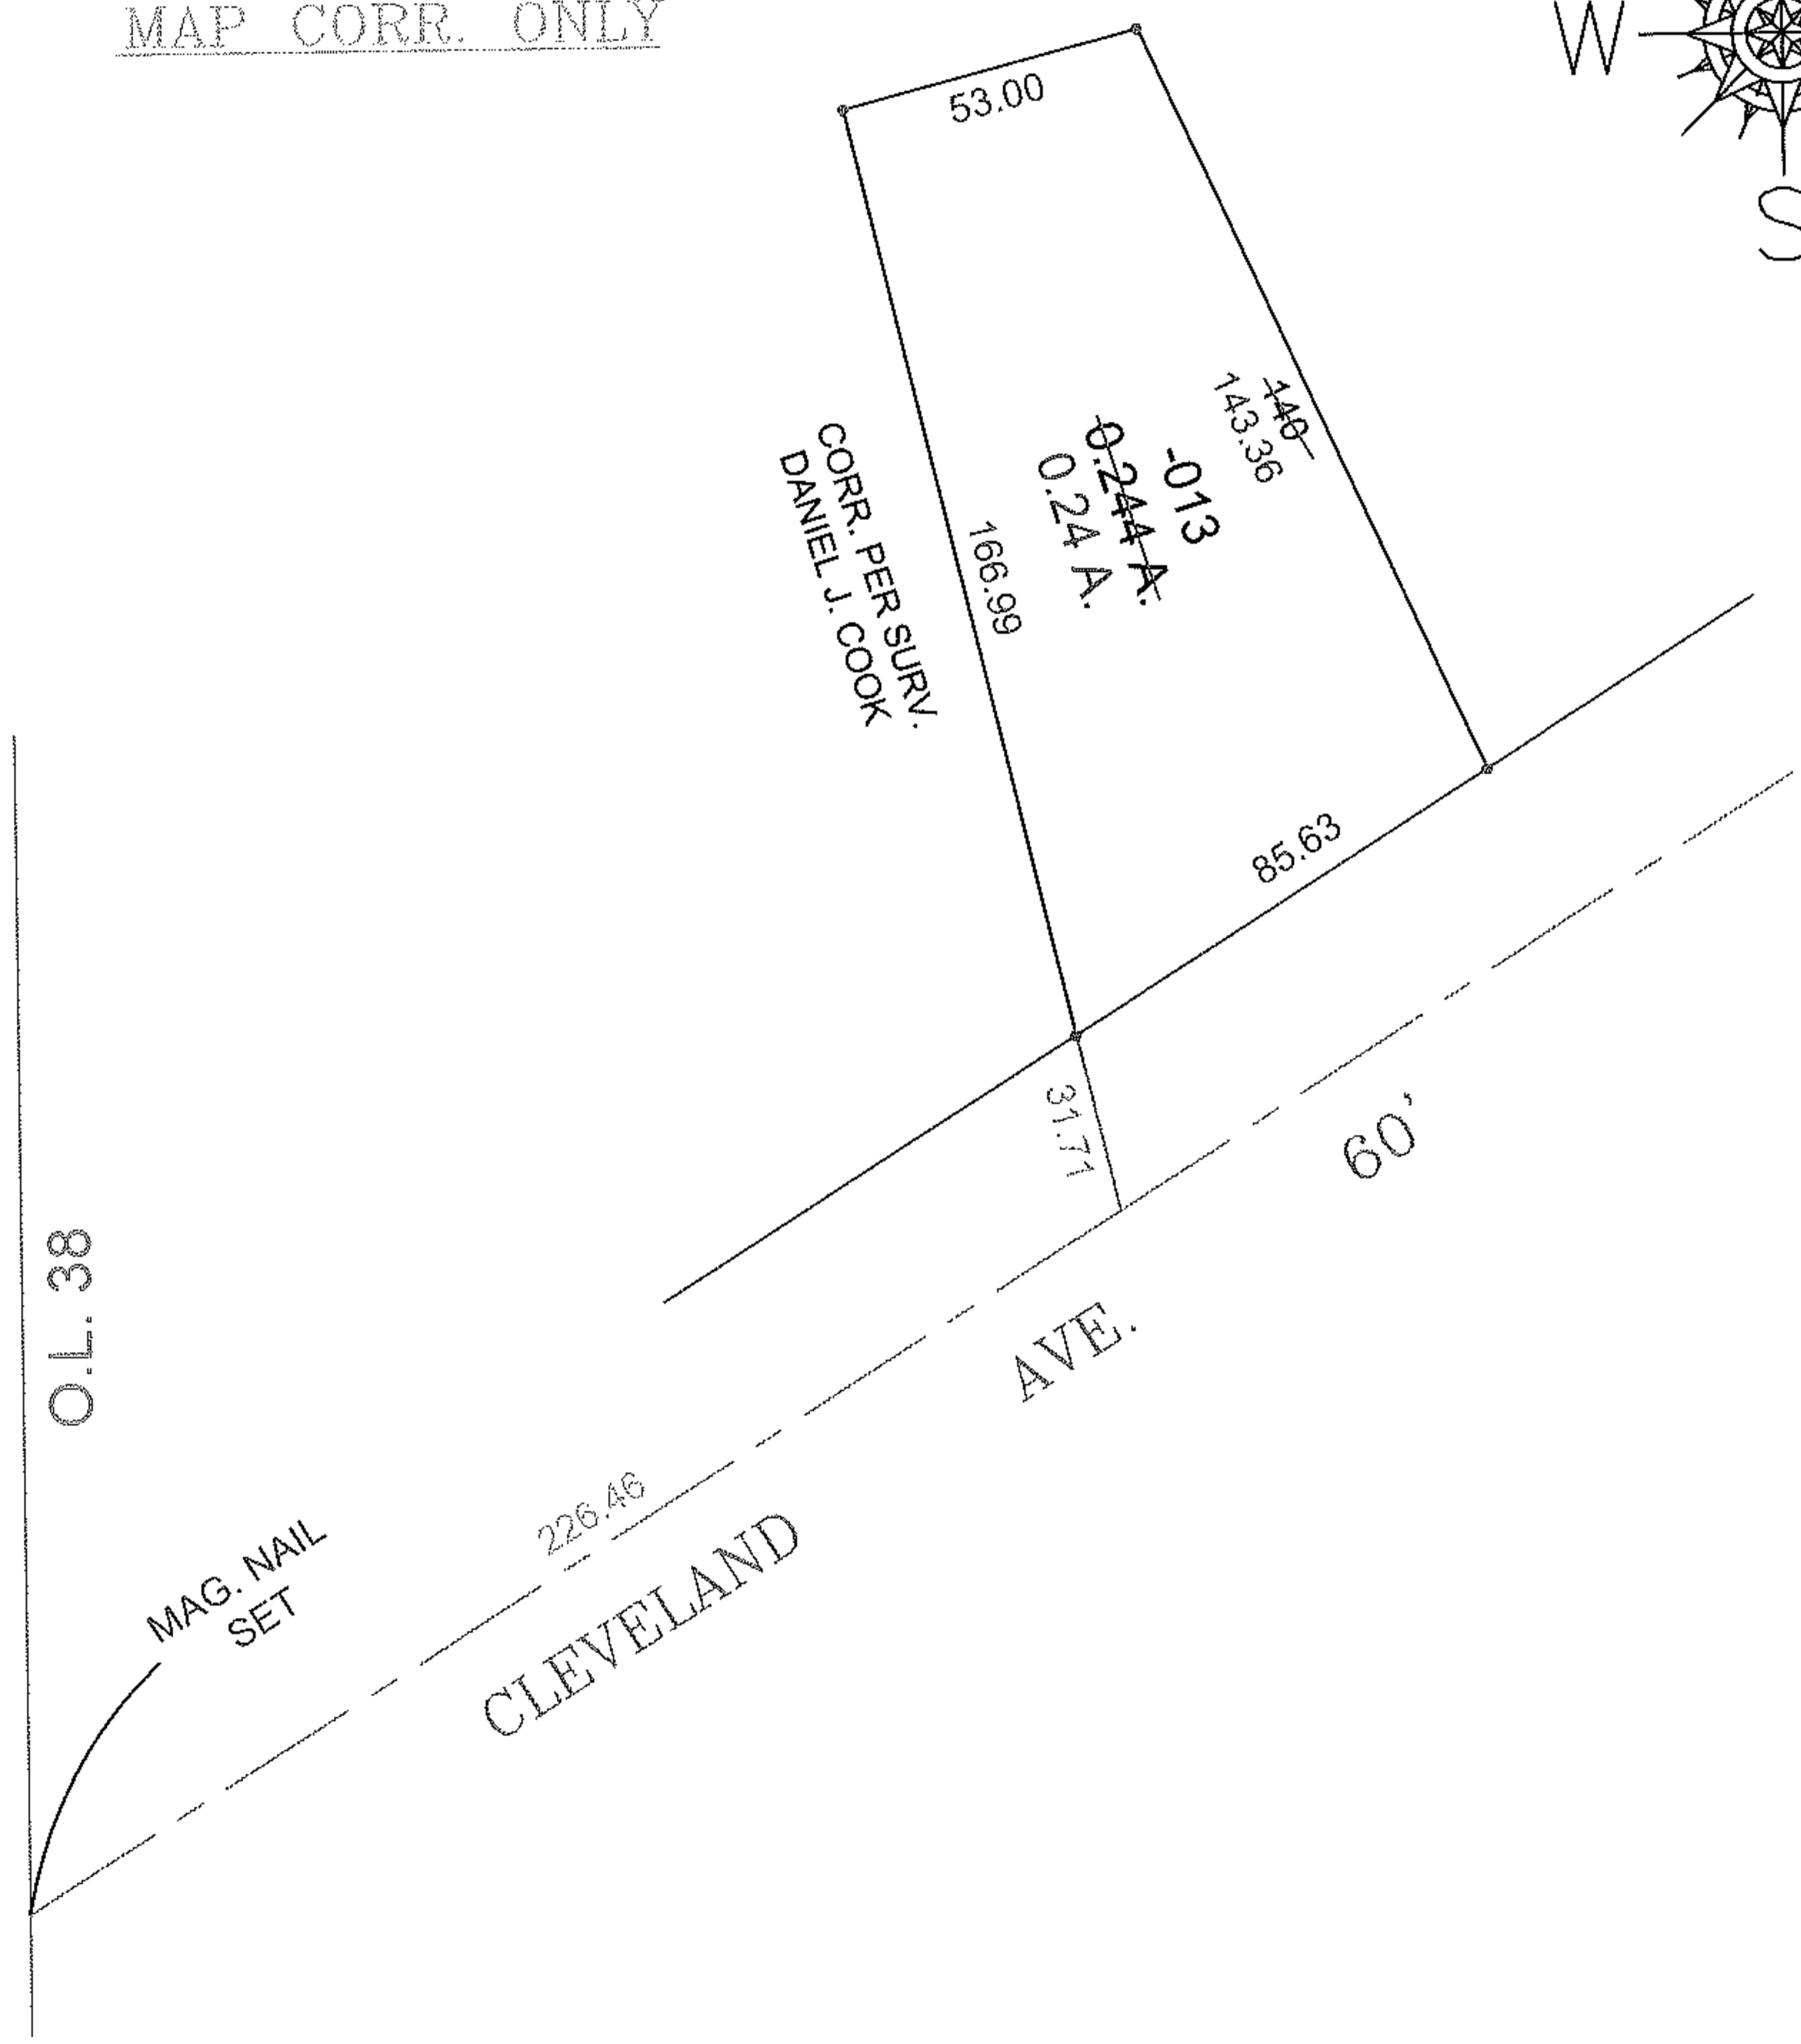


PARENT PARCEL: 05-00-038-101-013  
CHILD PARCEL: XX-XX-XXX-XXX-XXX  
STARTING POINT: MAG NAIL, CL OF CLEVELAND AVE. & WEST LINE OF O.L. 38

11-02272-C

MAP CORR. ONLY

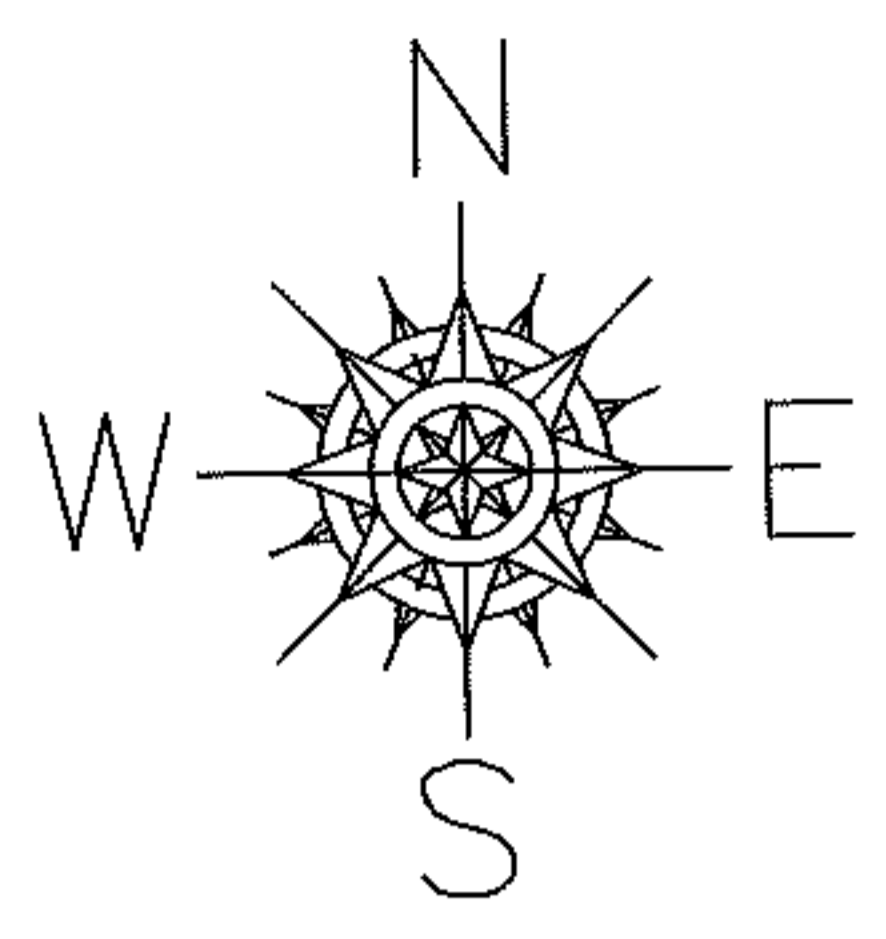

SPLITS/DEEDS PROCESSED

LORAIN COUNTY TAX MAP DEPARTMENT  
226 MIDDLE AVE. ELYRIA, OHIO

SURVEYED BY: DANIEL J. COOK  
CLOSURE: 0.01 : 10,000  
MAP PAGE(S): 5-00-038-A  
APPROVED BY: TJS DATE: 4/4/11  
SCALE: 1" = 50' PRIOR INST.: DV XXXX/XXX