


H CREEK

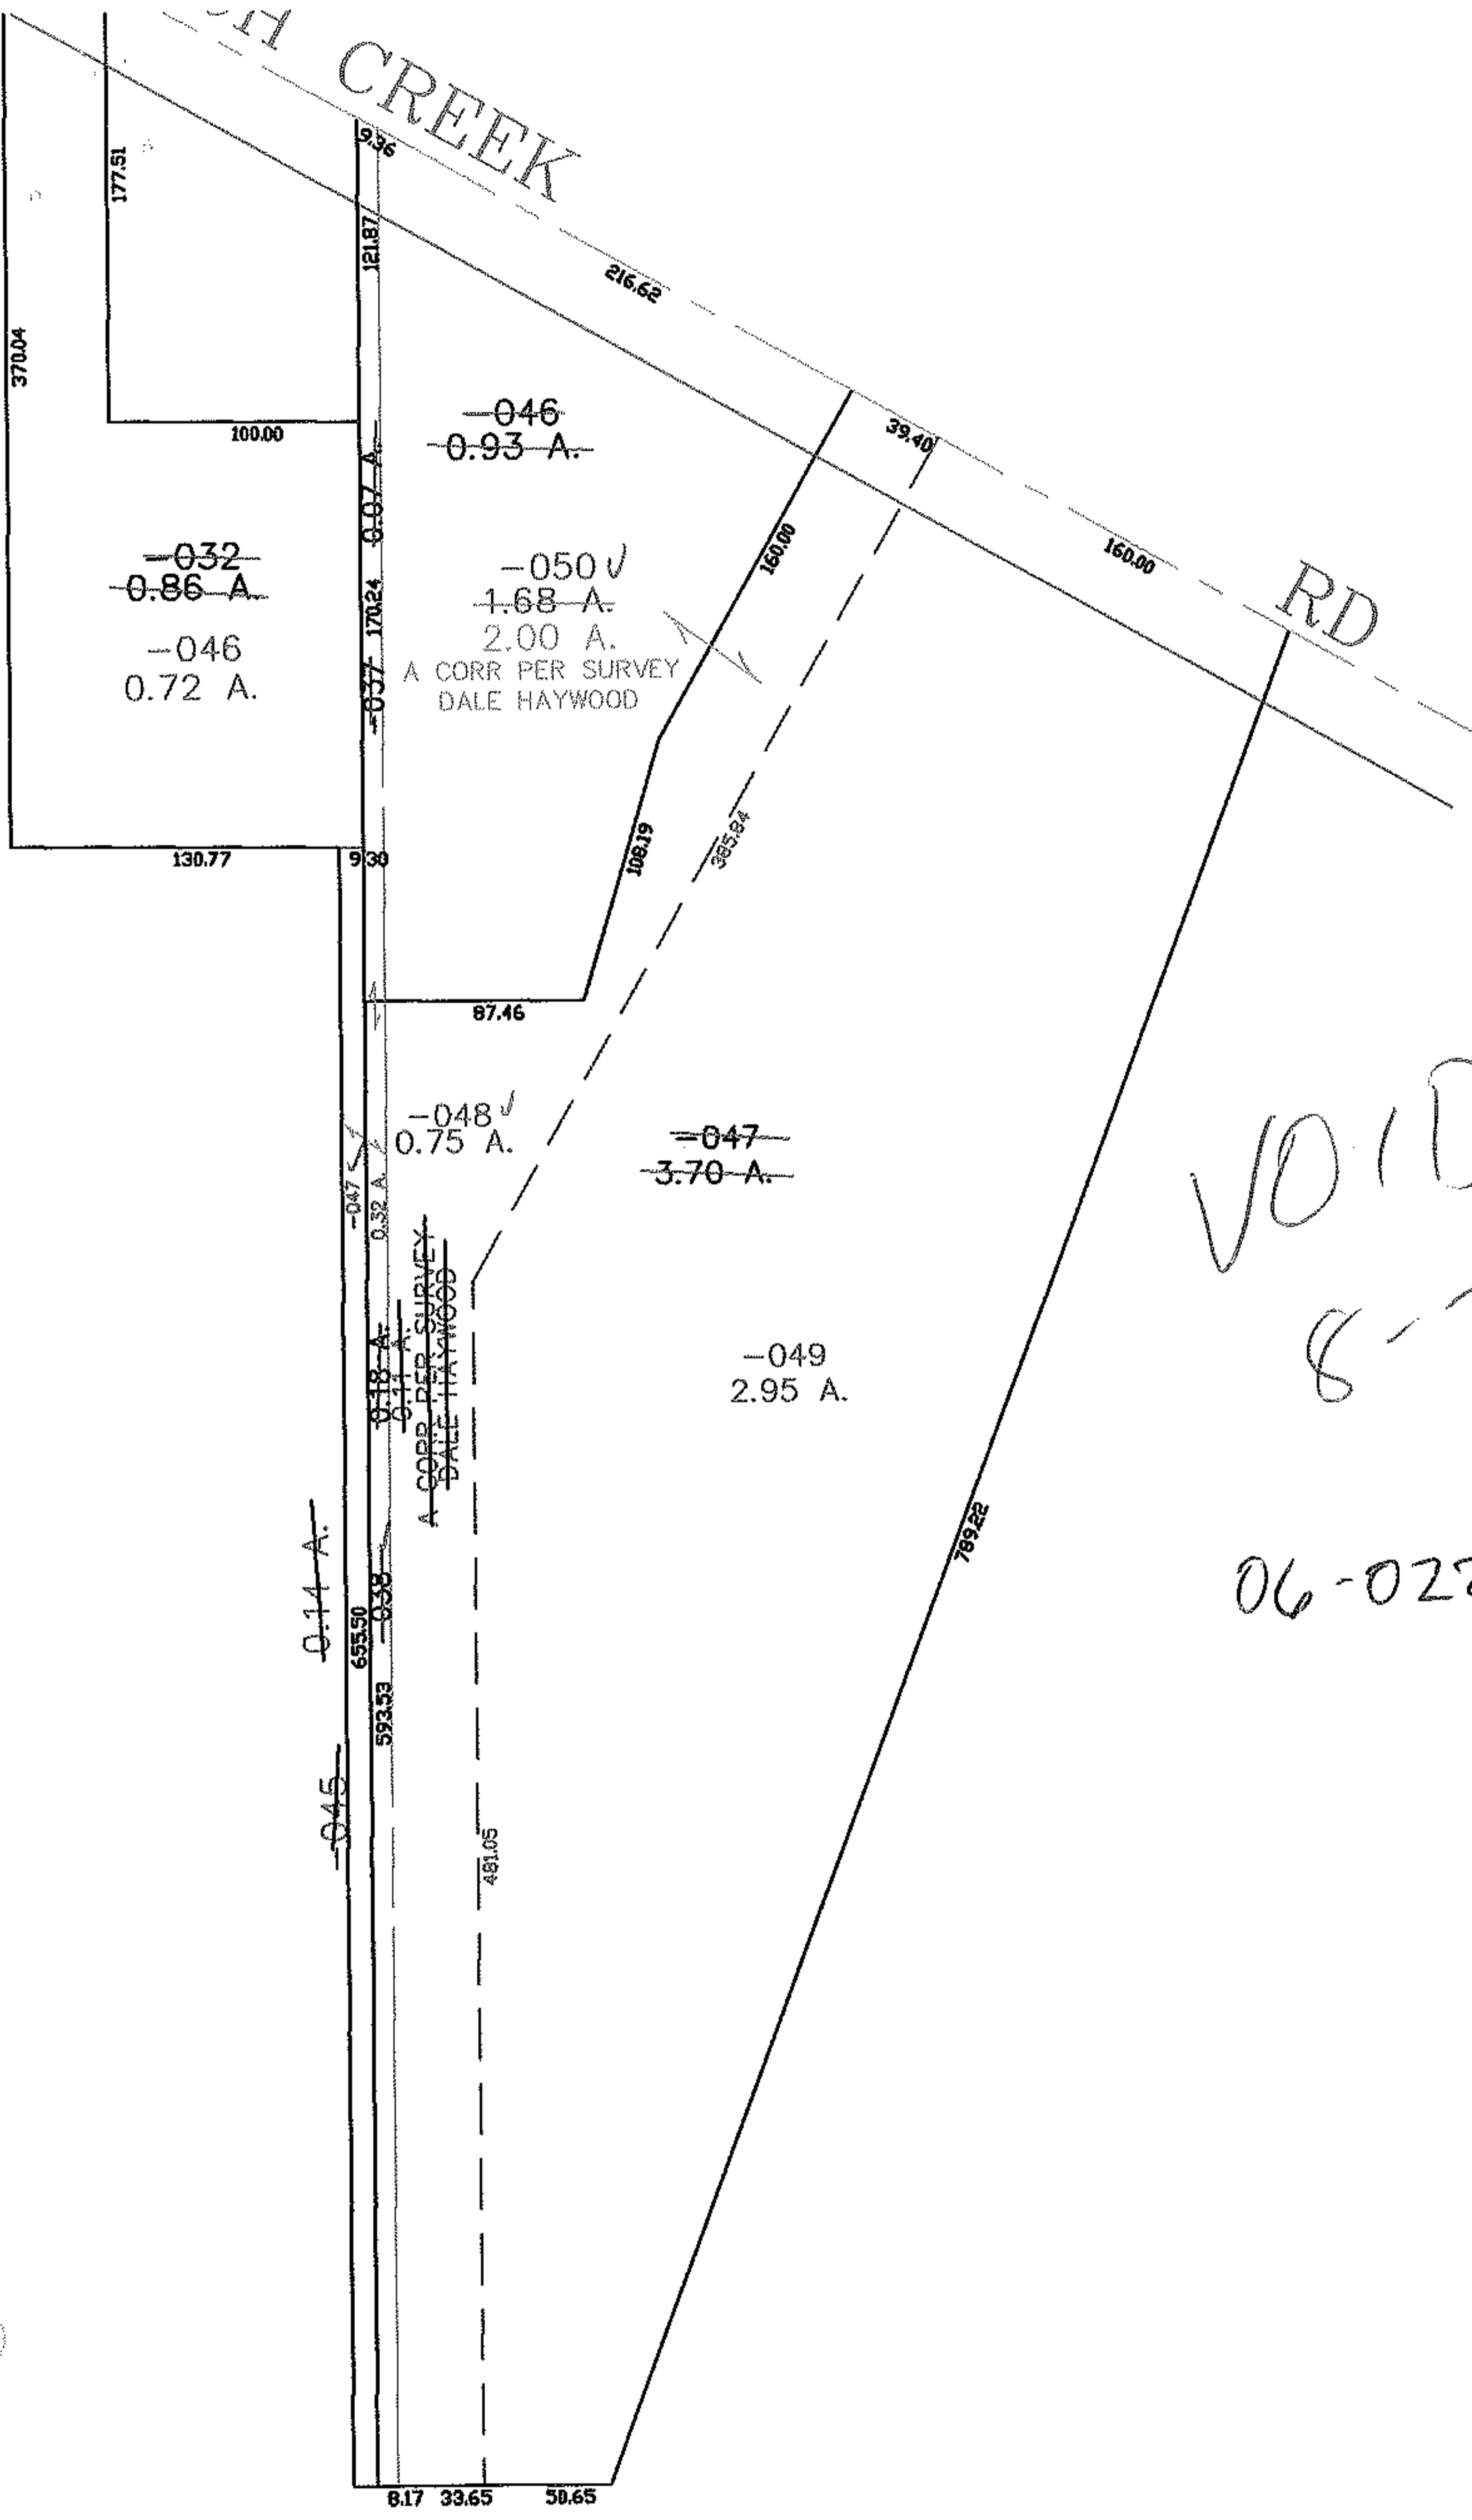

VOID
8-7-07

06-02274