
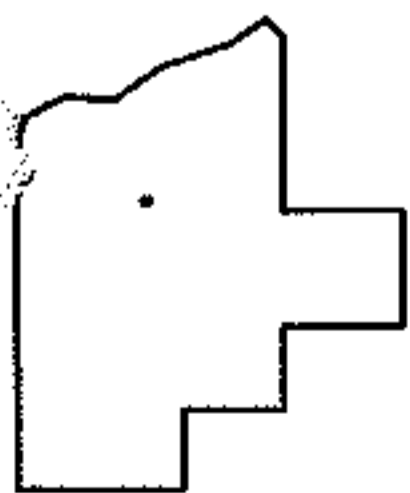
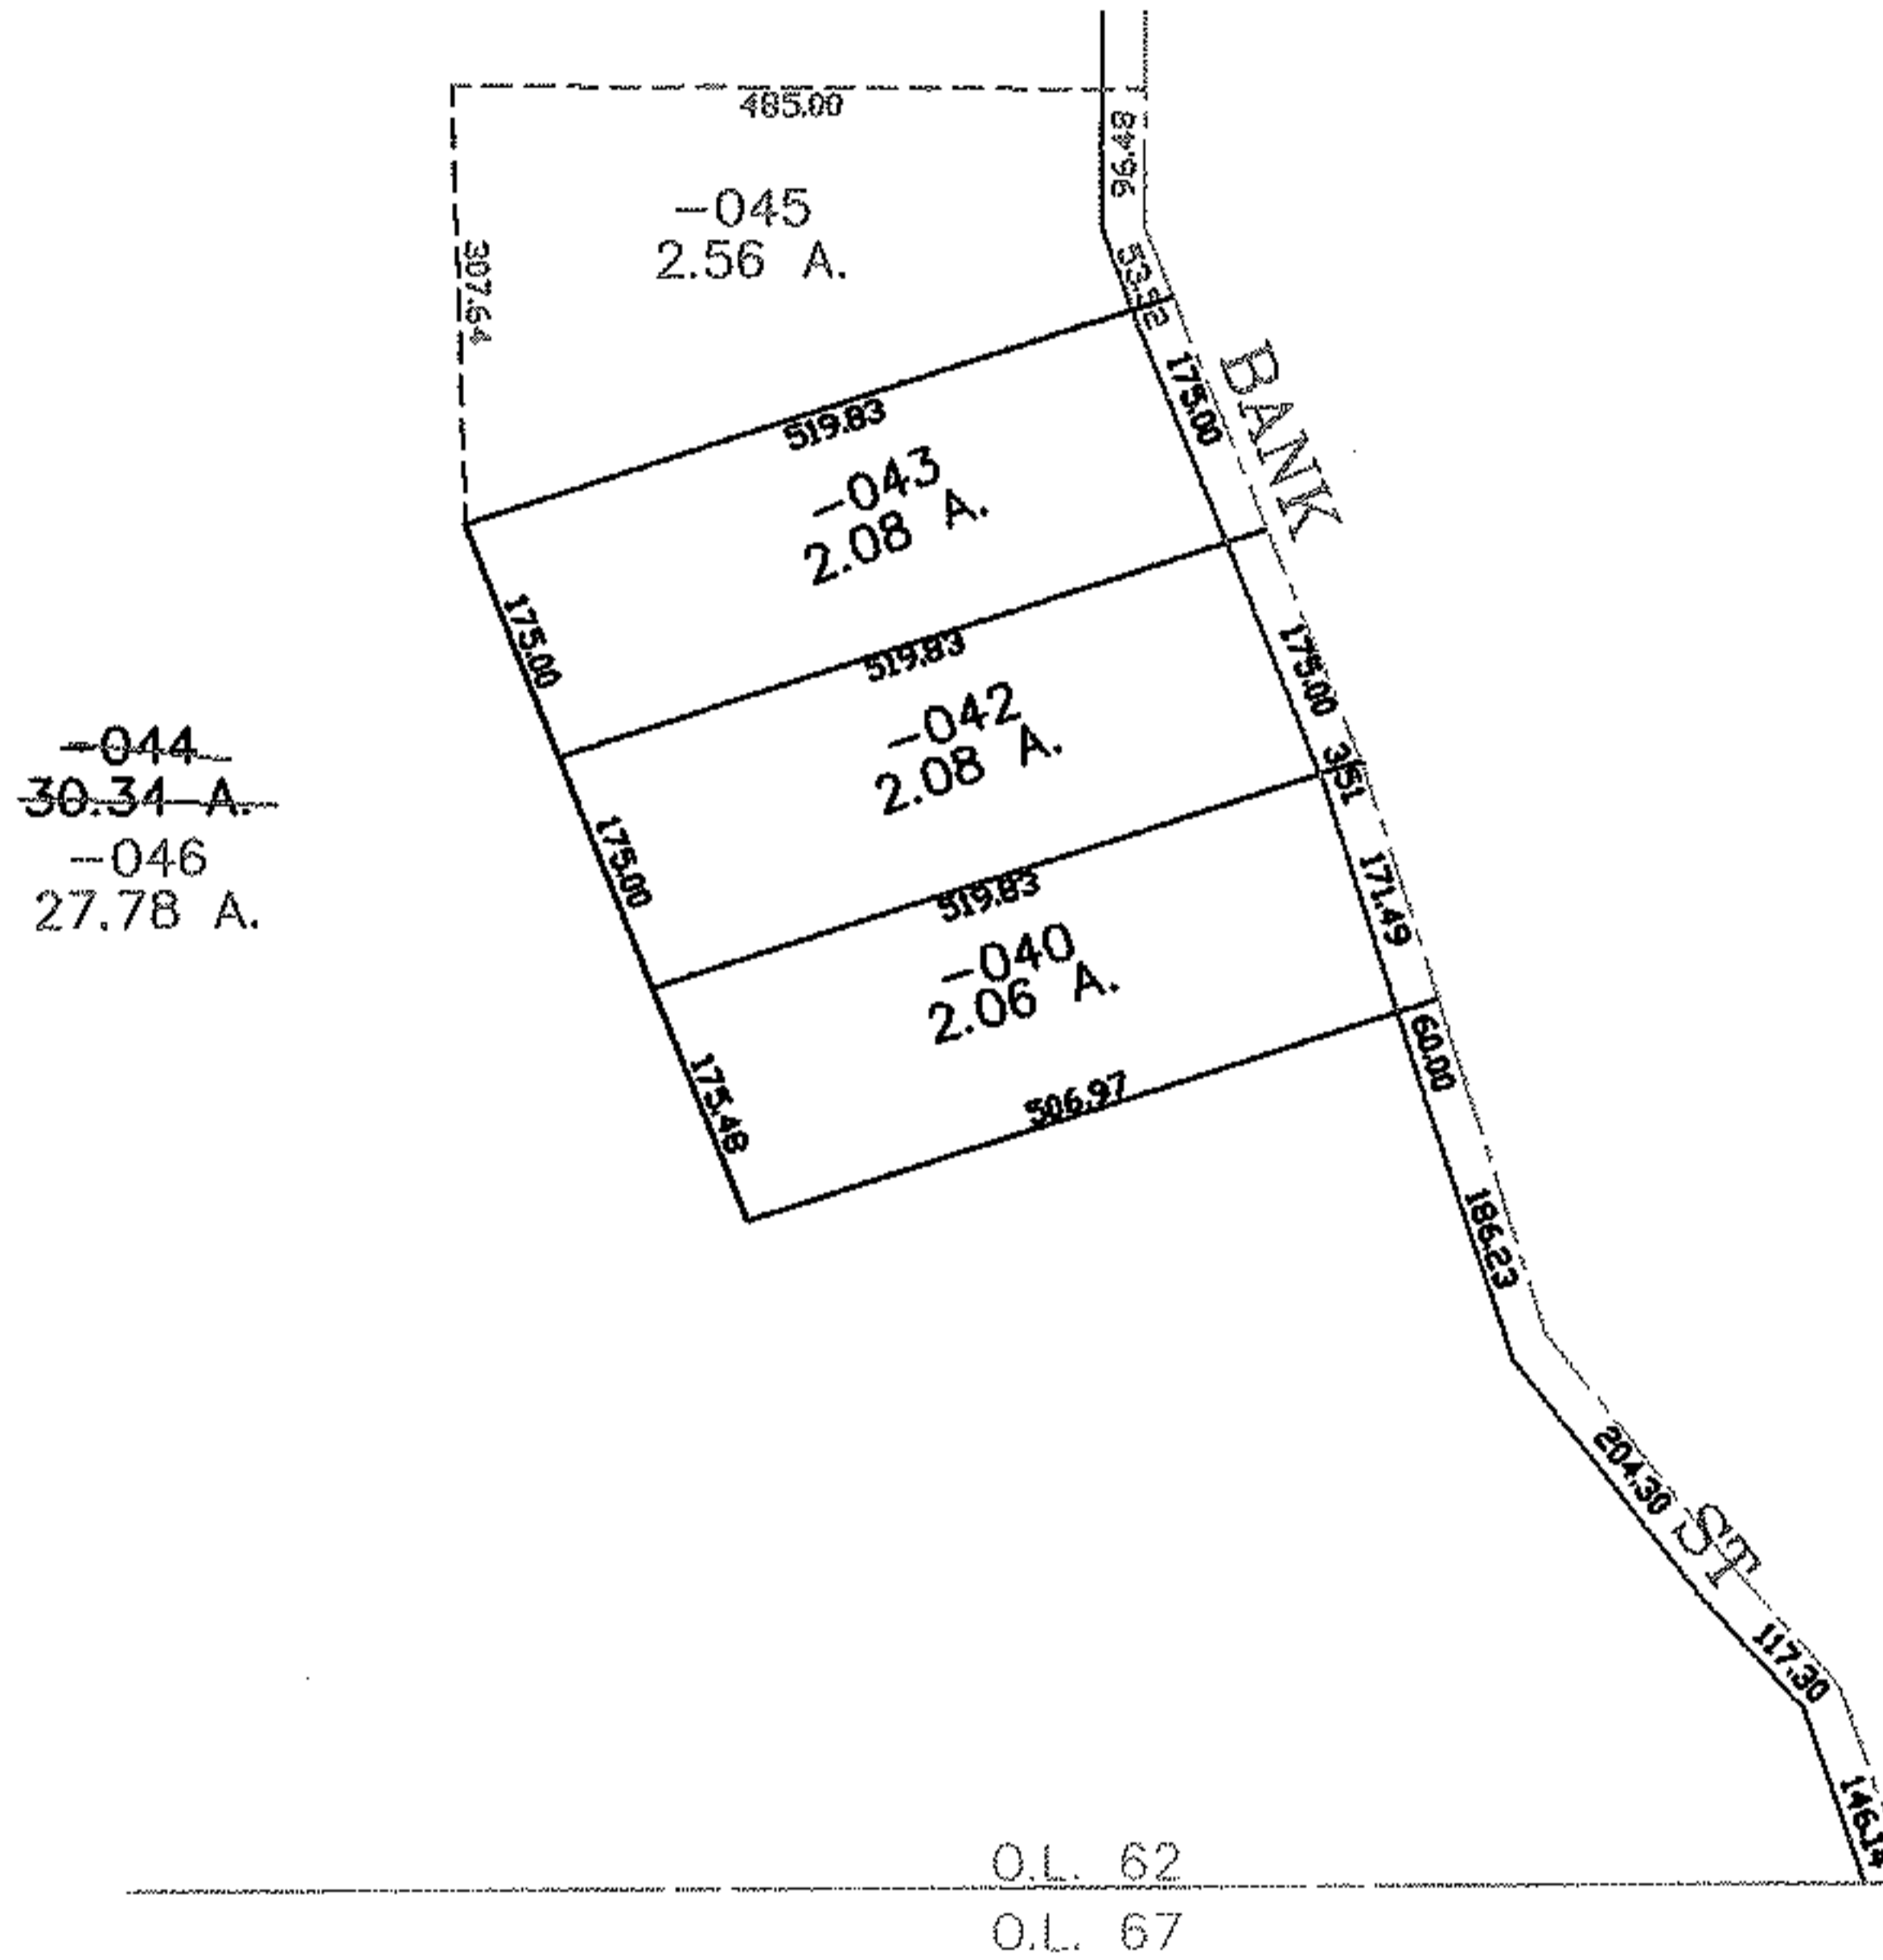


PARENT PARCEL: 01-00-062-000-044

CHILD PARCEL: 01-00-062-000-045, -046

STARTING POINT: CENTERLINE OF BANK RD & O.L. 62

06-02275

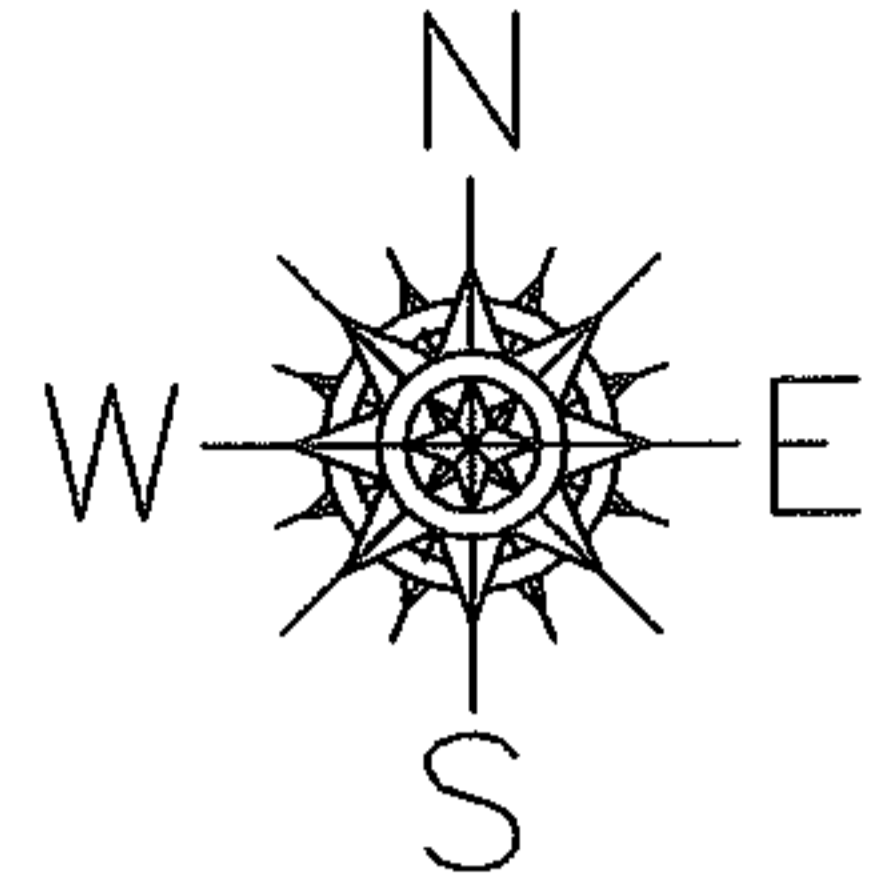

SPLITS/DEEDS PROCESSED
 LORAIN COUNTY TAX MAP DEPARTMENT
 226 MIDDLE AVE. ELYRIA, OHIO

SURVEYED BY: CHARLES WARYU
 CLOSURE: 0.00 ; 10.000
 MAP PAGE(S): 1-J
 APPROVED BY: JAH DATE: 11-28-06
 SCALE: 1" = 300 PRIOR INSTRUMENT: OR 1201/550