
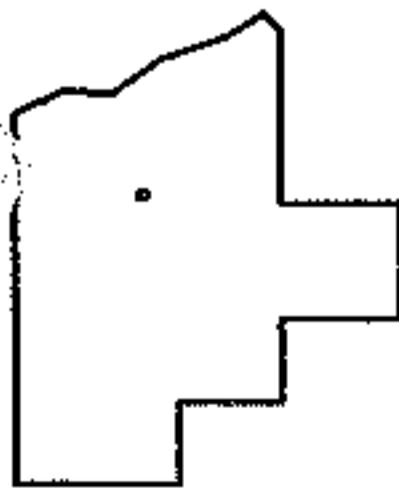
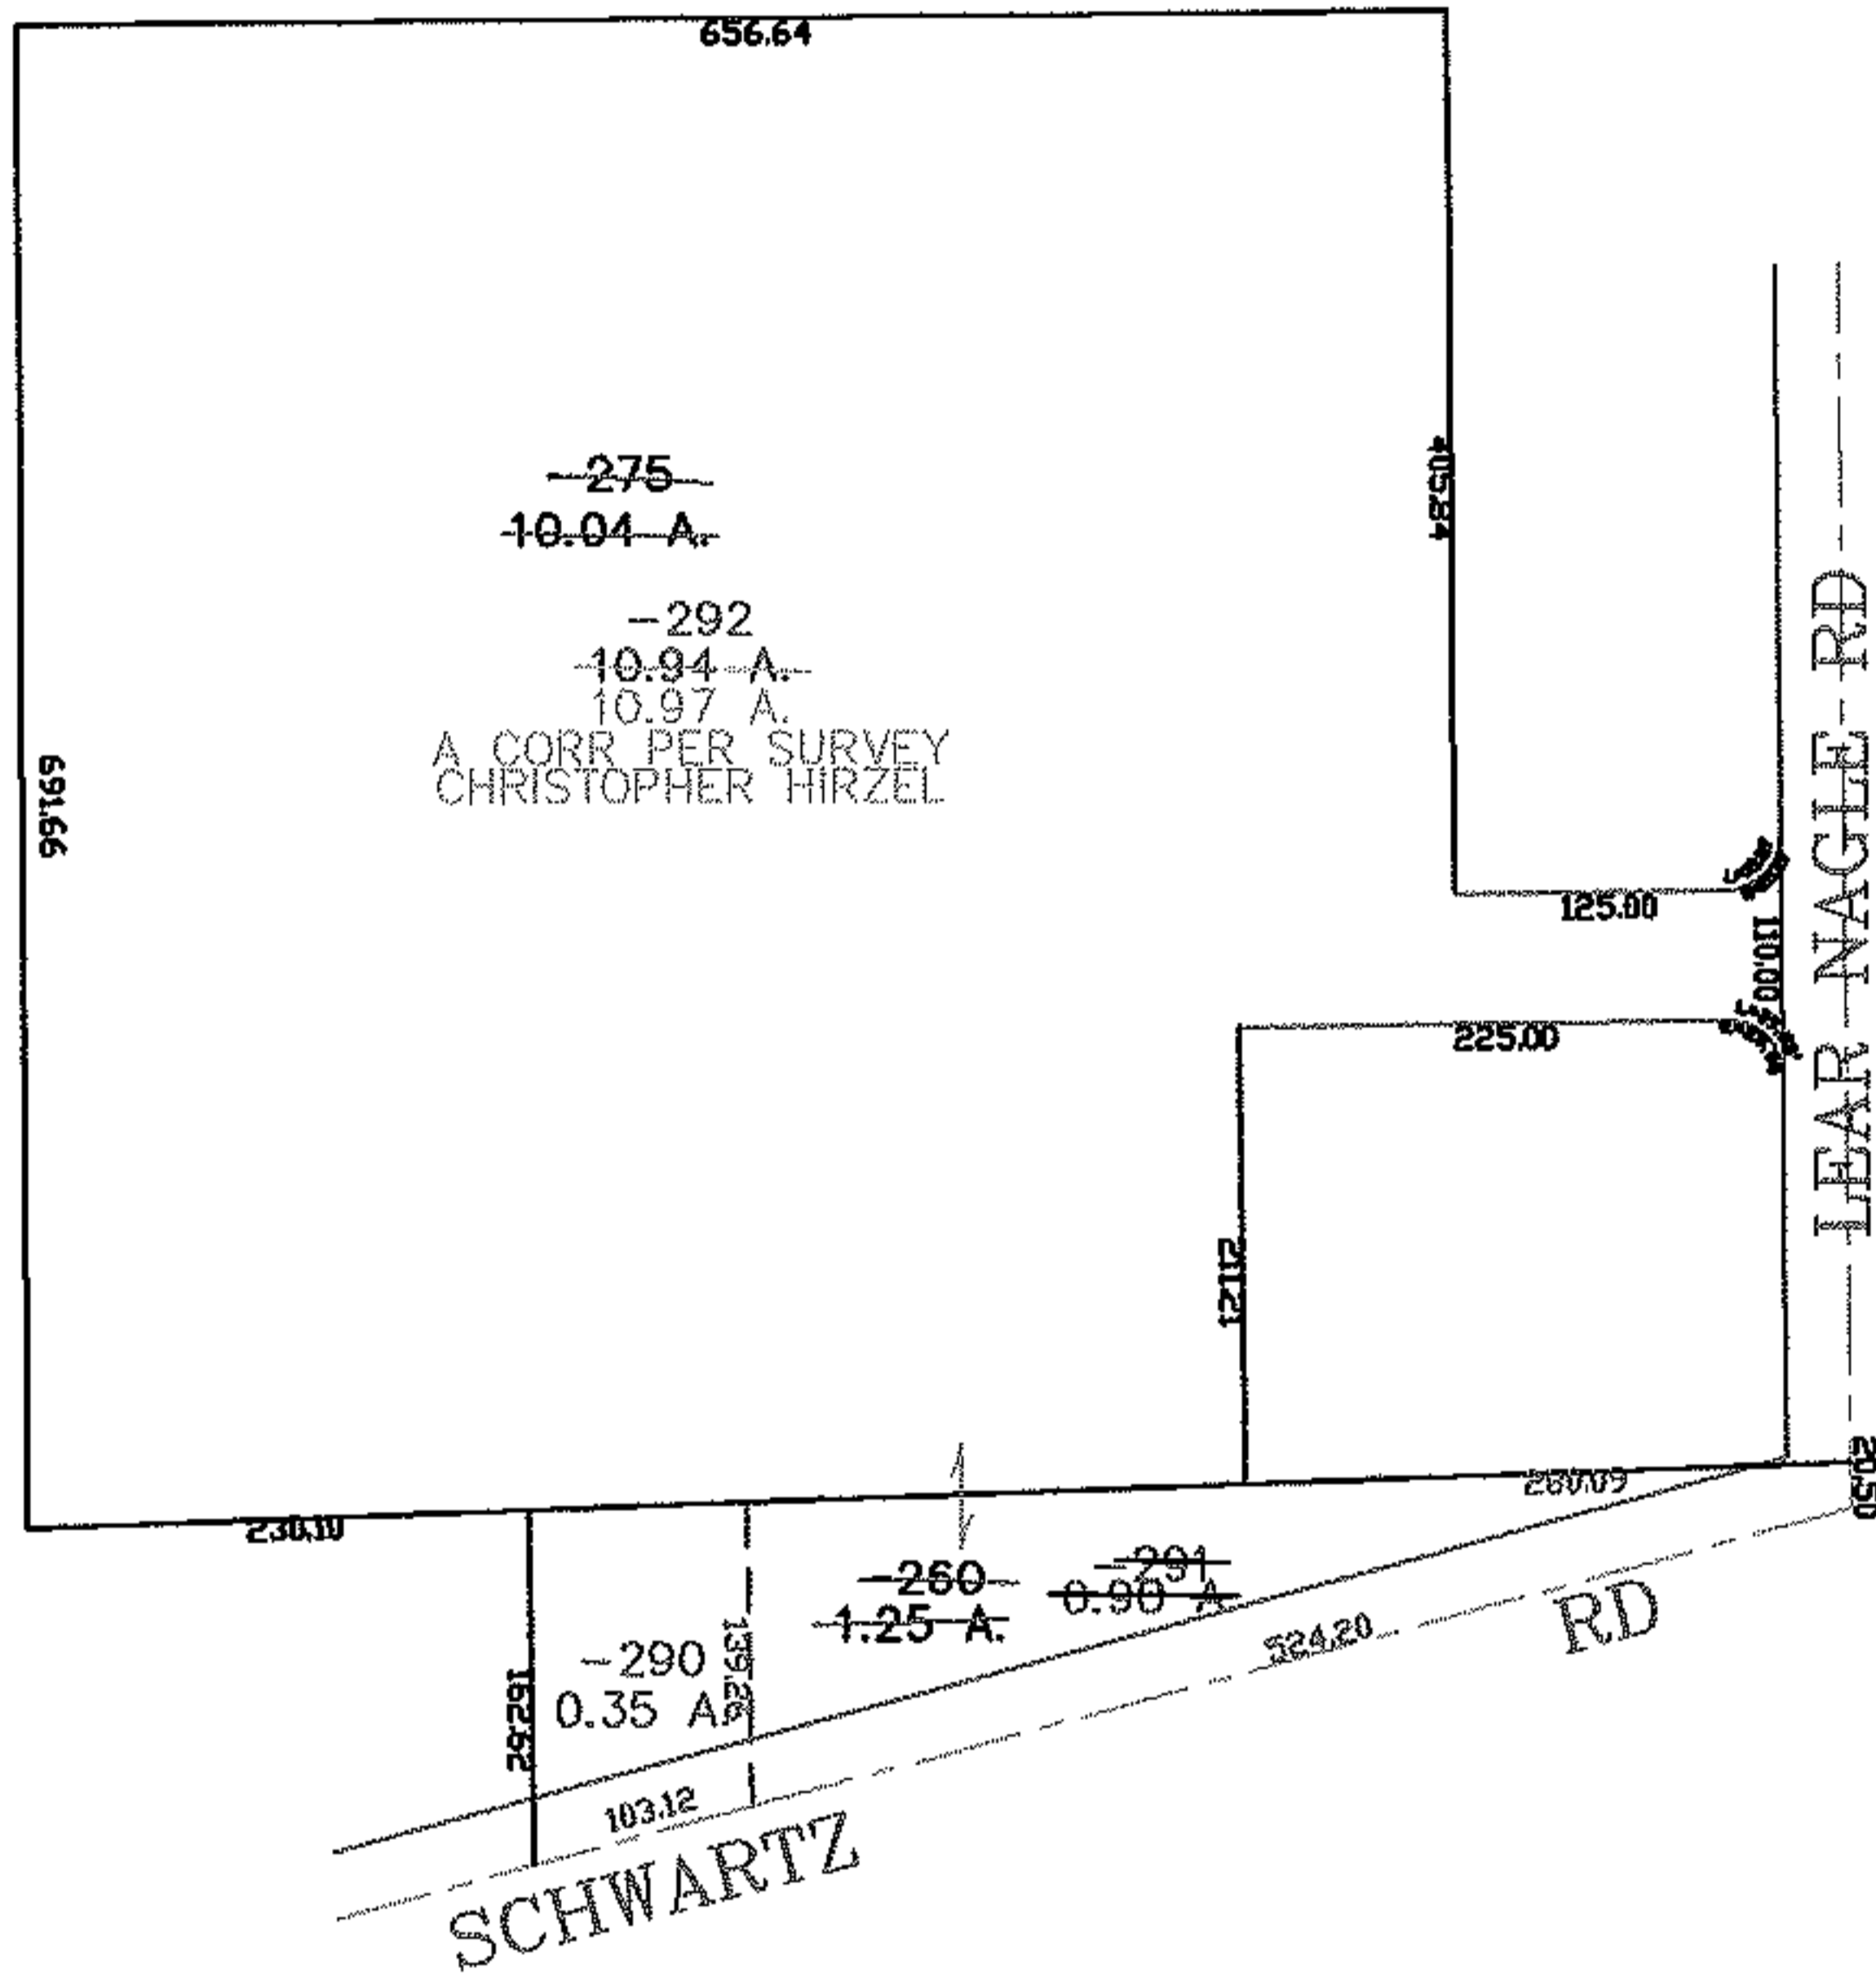


PARENT PARCEL: 04-00-023-105-260, -275  
CHILD PARCEL: 04-00-023-105-290 THRU -292  
STARTING POINT: CENTERLINE OF SCHWARTZ RD & LEAR NAGLE RD

06-02276

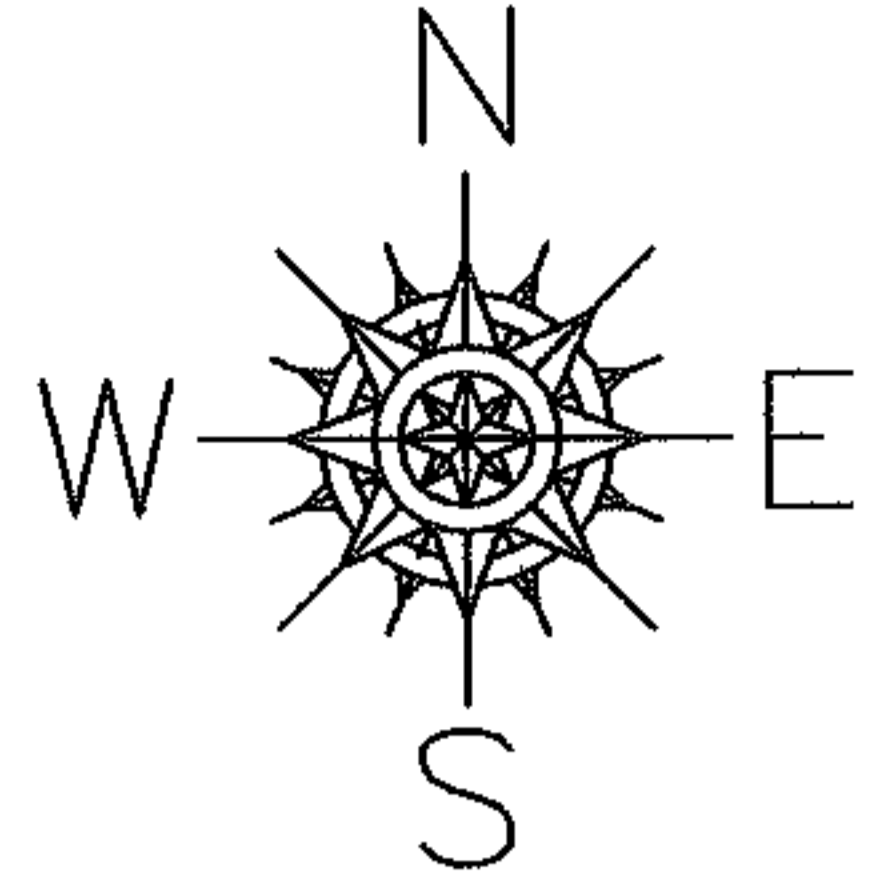

**SPLITS/DEEDS PROCESSED**  
LORAIN COUNTY TAX MAP DEPARTMENT  
226 MIDDLE AVE. ELYRIA, OHIO

SURVEYED BY: CHRISTOPHER HIRZEL  
CLOSURE: 0.00 : 10.000  
MAP PAGE(S): 04-00-023-H  
APPROVED BY: JAH DATE: 11-28-06  
SCALE: 1" = 200' PRIOR INSTRUMENT: 20050072505