
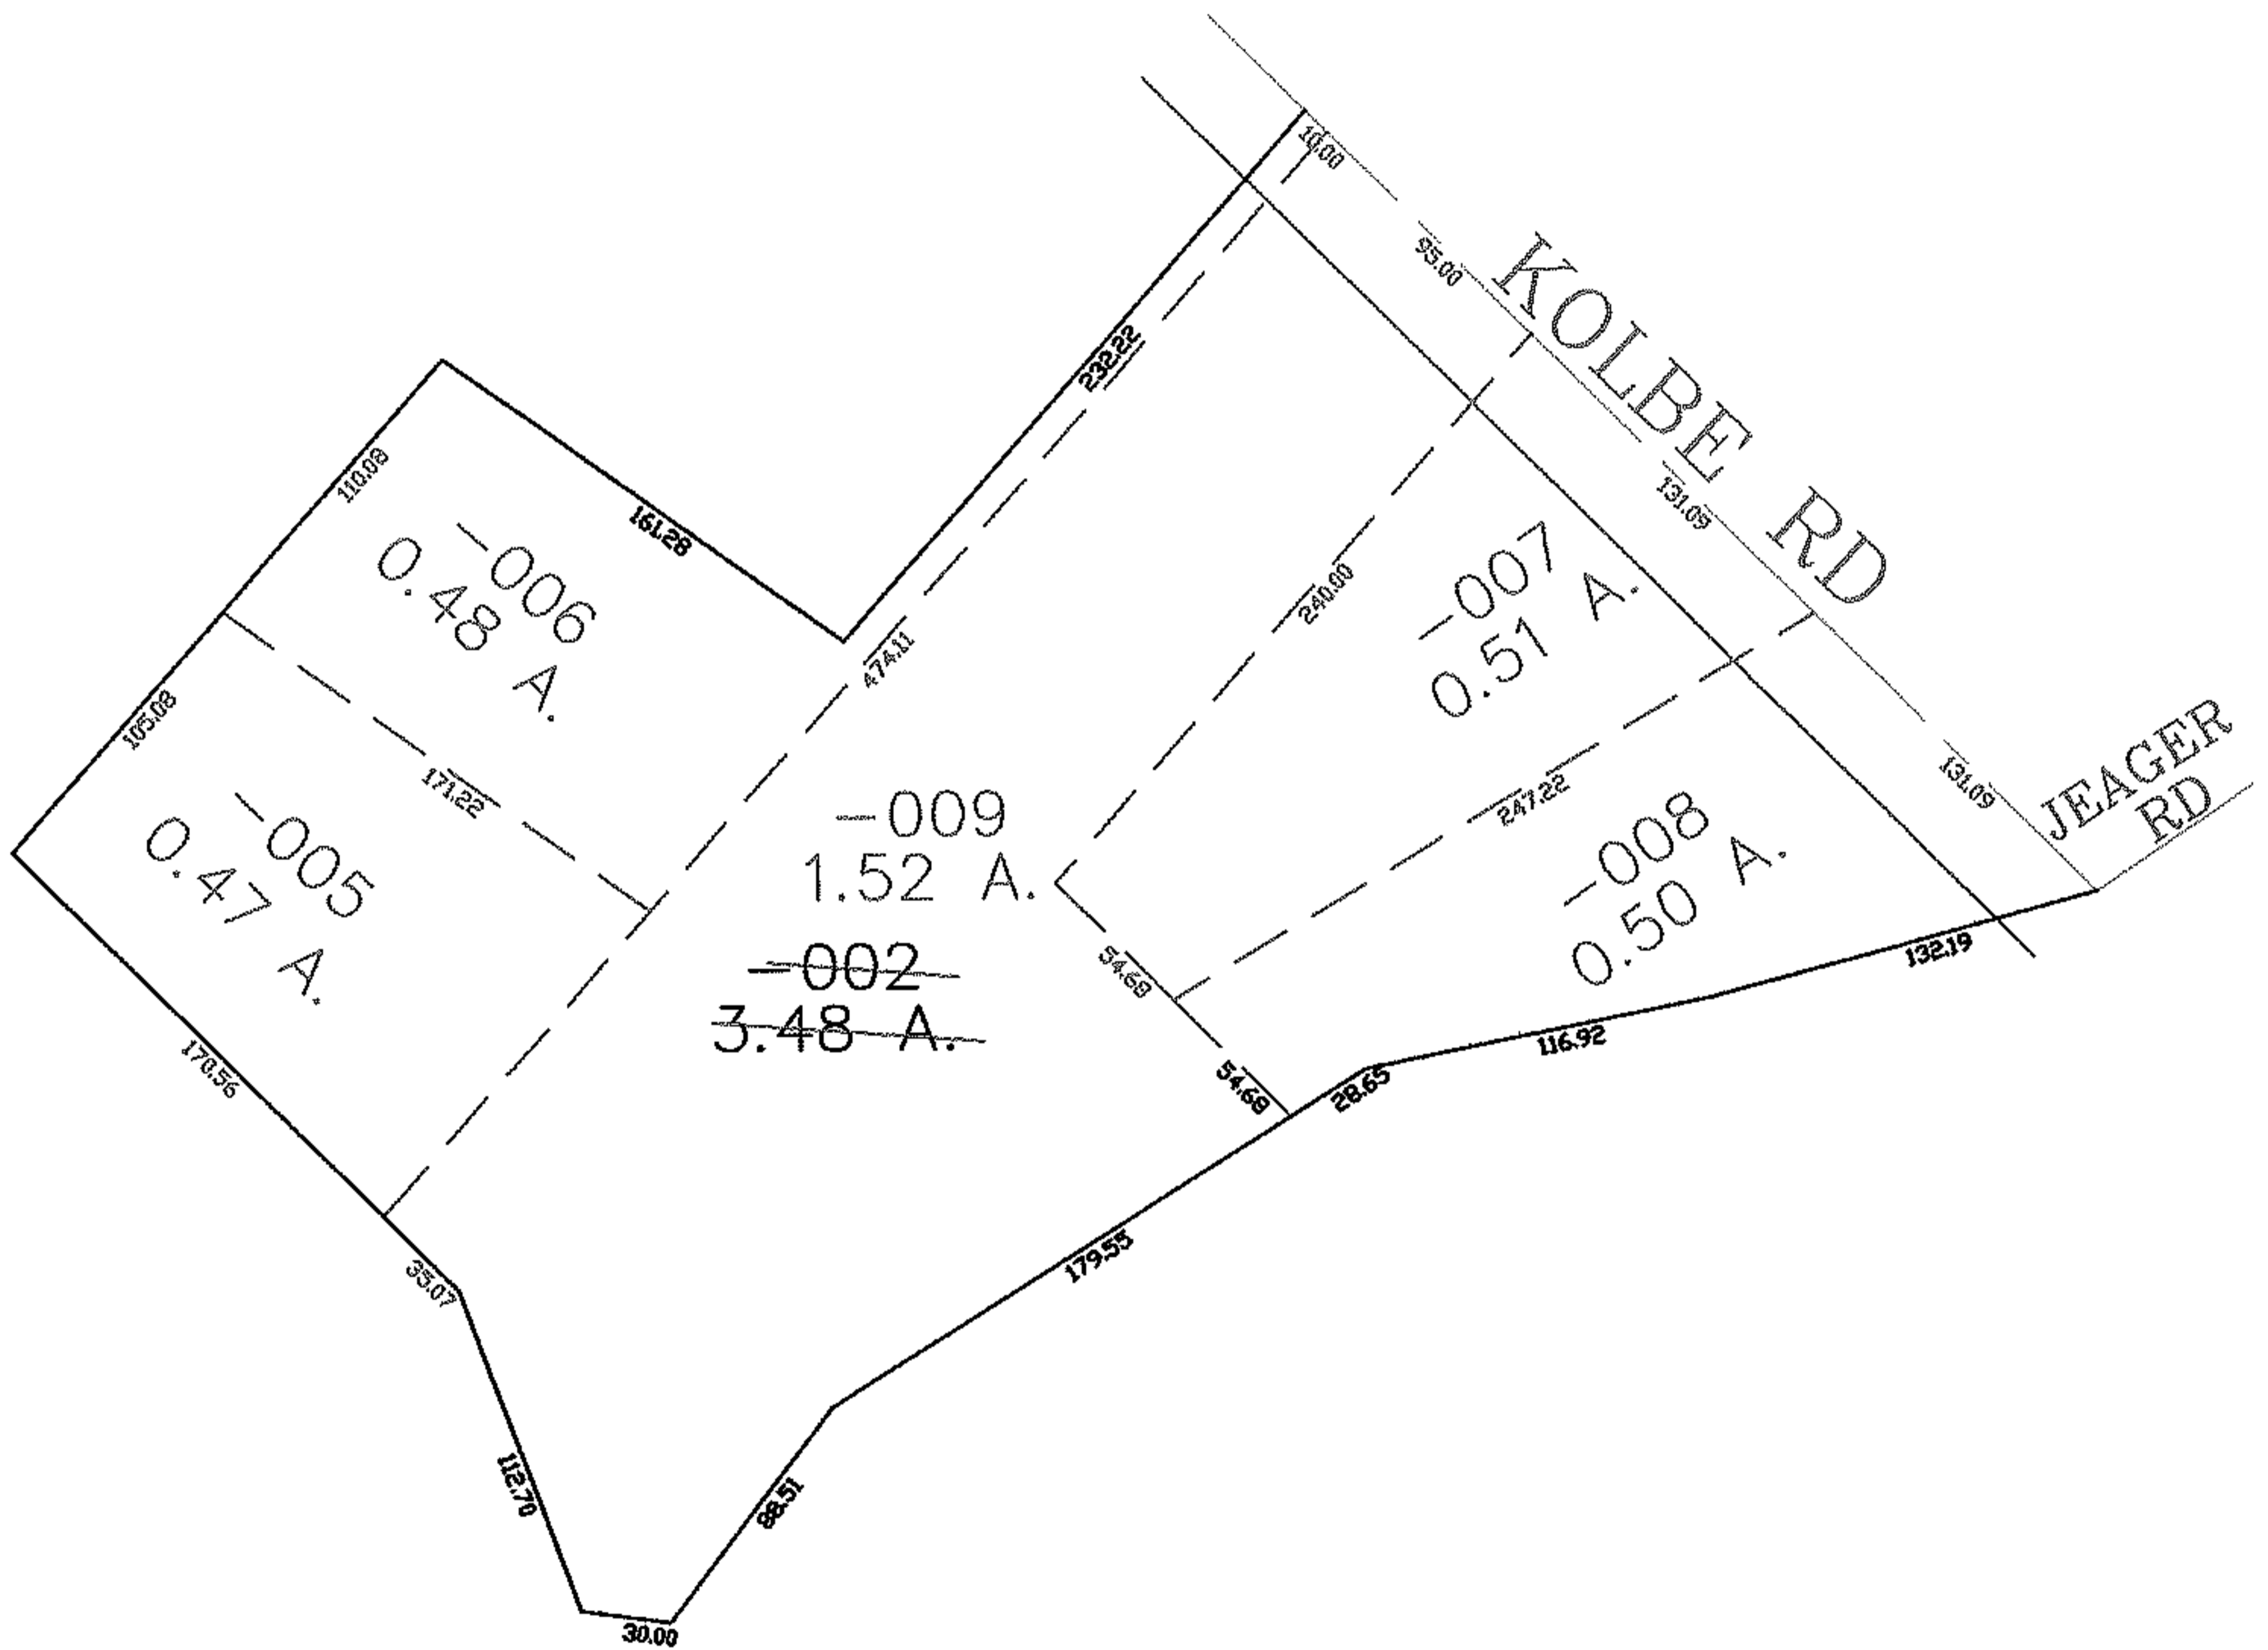


PARENT PARCEL: 02-03-005-104-002

CHILD PARCEL: 02-03-005-104-005 THRU -009

STARTING POINT: CENTERLINE OF KOLBE RD & JAEGER RD

06-02277

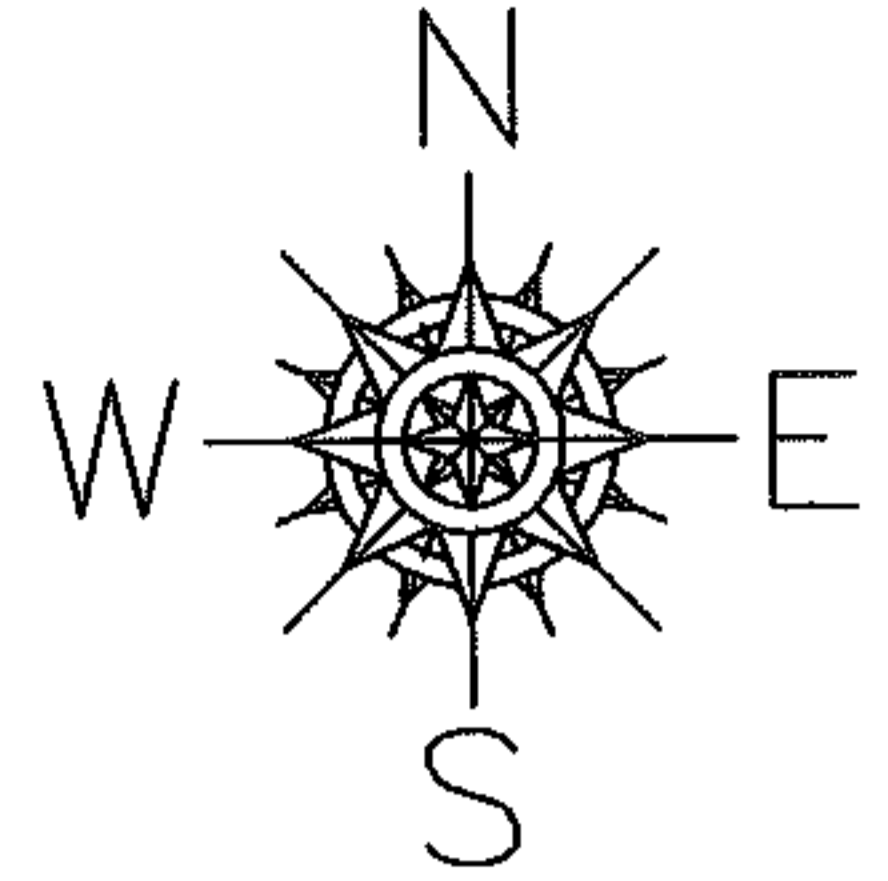

SPLITS/DEEDS PROCESSED

LORAIN COUNTY TAX MAP DEPARTMENT  
226 MIDDLE AVE. ELYRIA, OHIO

SURVEYED BY: DALE HAYWOOD  
CLOSURE: 0.00 : 10.000  
MAP PAGE(S): 02-03-005-B  
APPROVED BY: JAH DATE: 11-29-06  
SCALE: 1" = 100 PRIOR INSTRUMENT: 20050085823