


PARENT PARCEL: 03-00-025-000-039

11-02280-A

CHILD PARCEL: _____

STARTING POINT: INTERSECTION OF C/L OF HARRIS RD. AND NORTH LINE OF O.L. 25

O.L.26
O.L.25

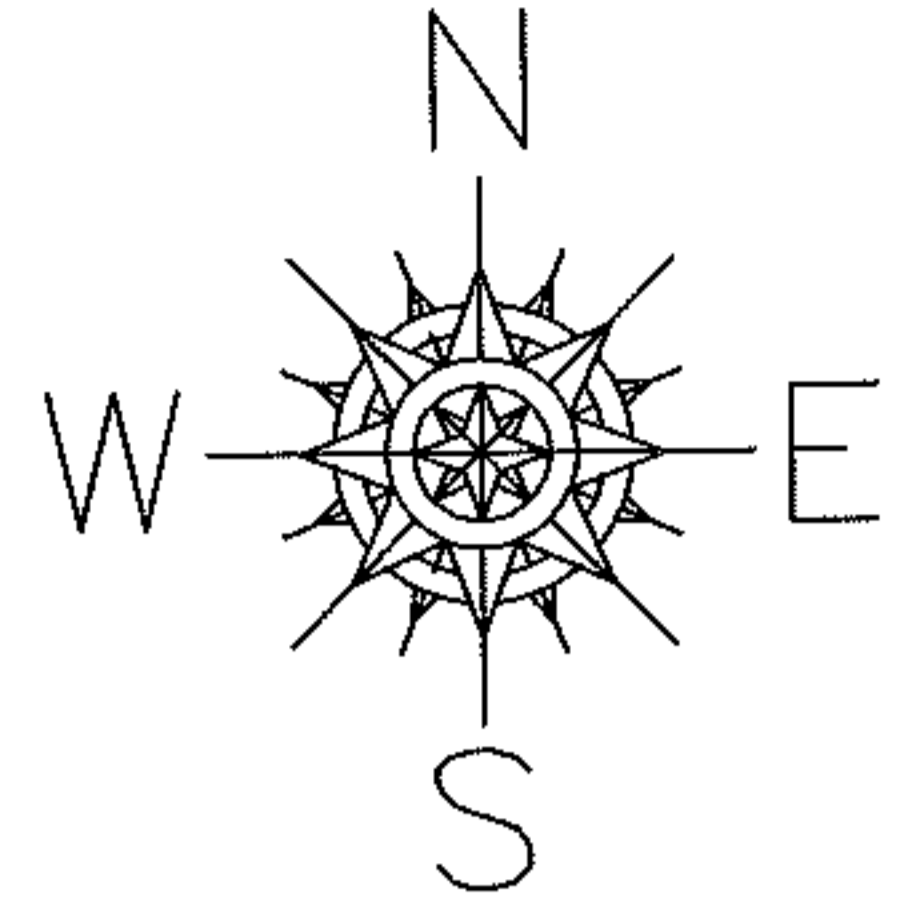

796.23

HARRIS RD.

837.21

473.09

-039
~~18.86 A.~~
18.21 A.

180.00

AC. CORR. PER.
PRIOR DEEDS

1296.24

386.32

636.22

COLORADO AVE.

L=154.80

SURVEYED BY: N/A

CLOSURE: .04:10,000

MAP PAGE(S): 3-00-025-B

APPROVED BY: RRM DATE: 4-6-11

SCALE: 1"= 300 PRIOR INST.: DV 929/855

SPLITS/DEEDS PROCESSED

LORAIN COUNTY TAX MAP DEPARTMENT
226 MIDDLE AVE. ELYRIA, OHIO

