
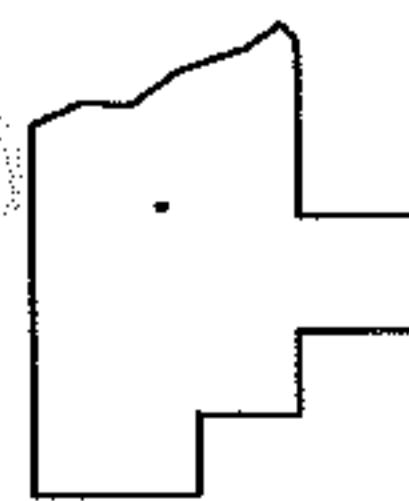
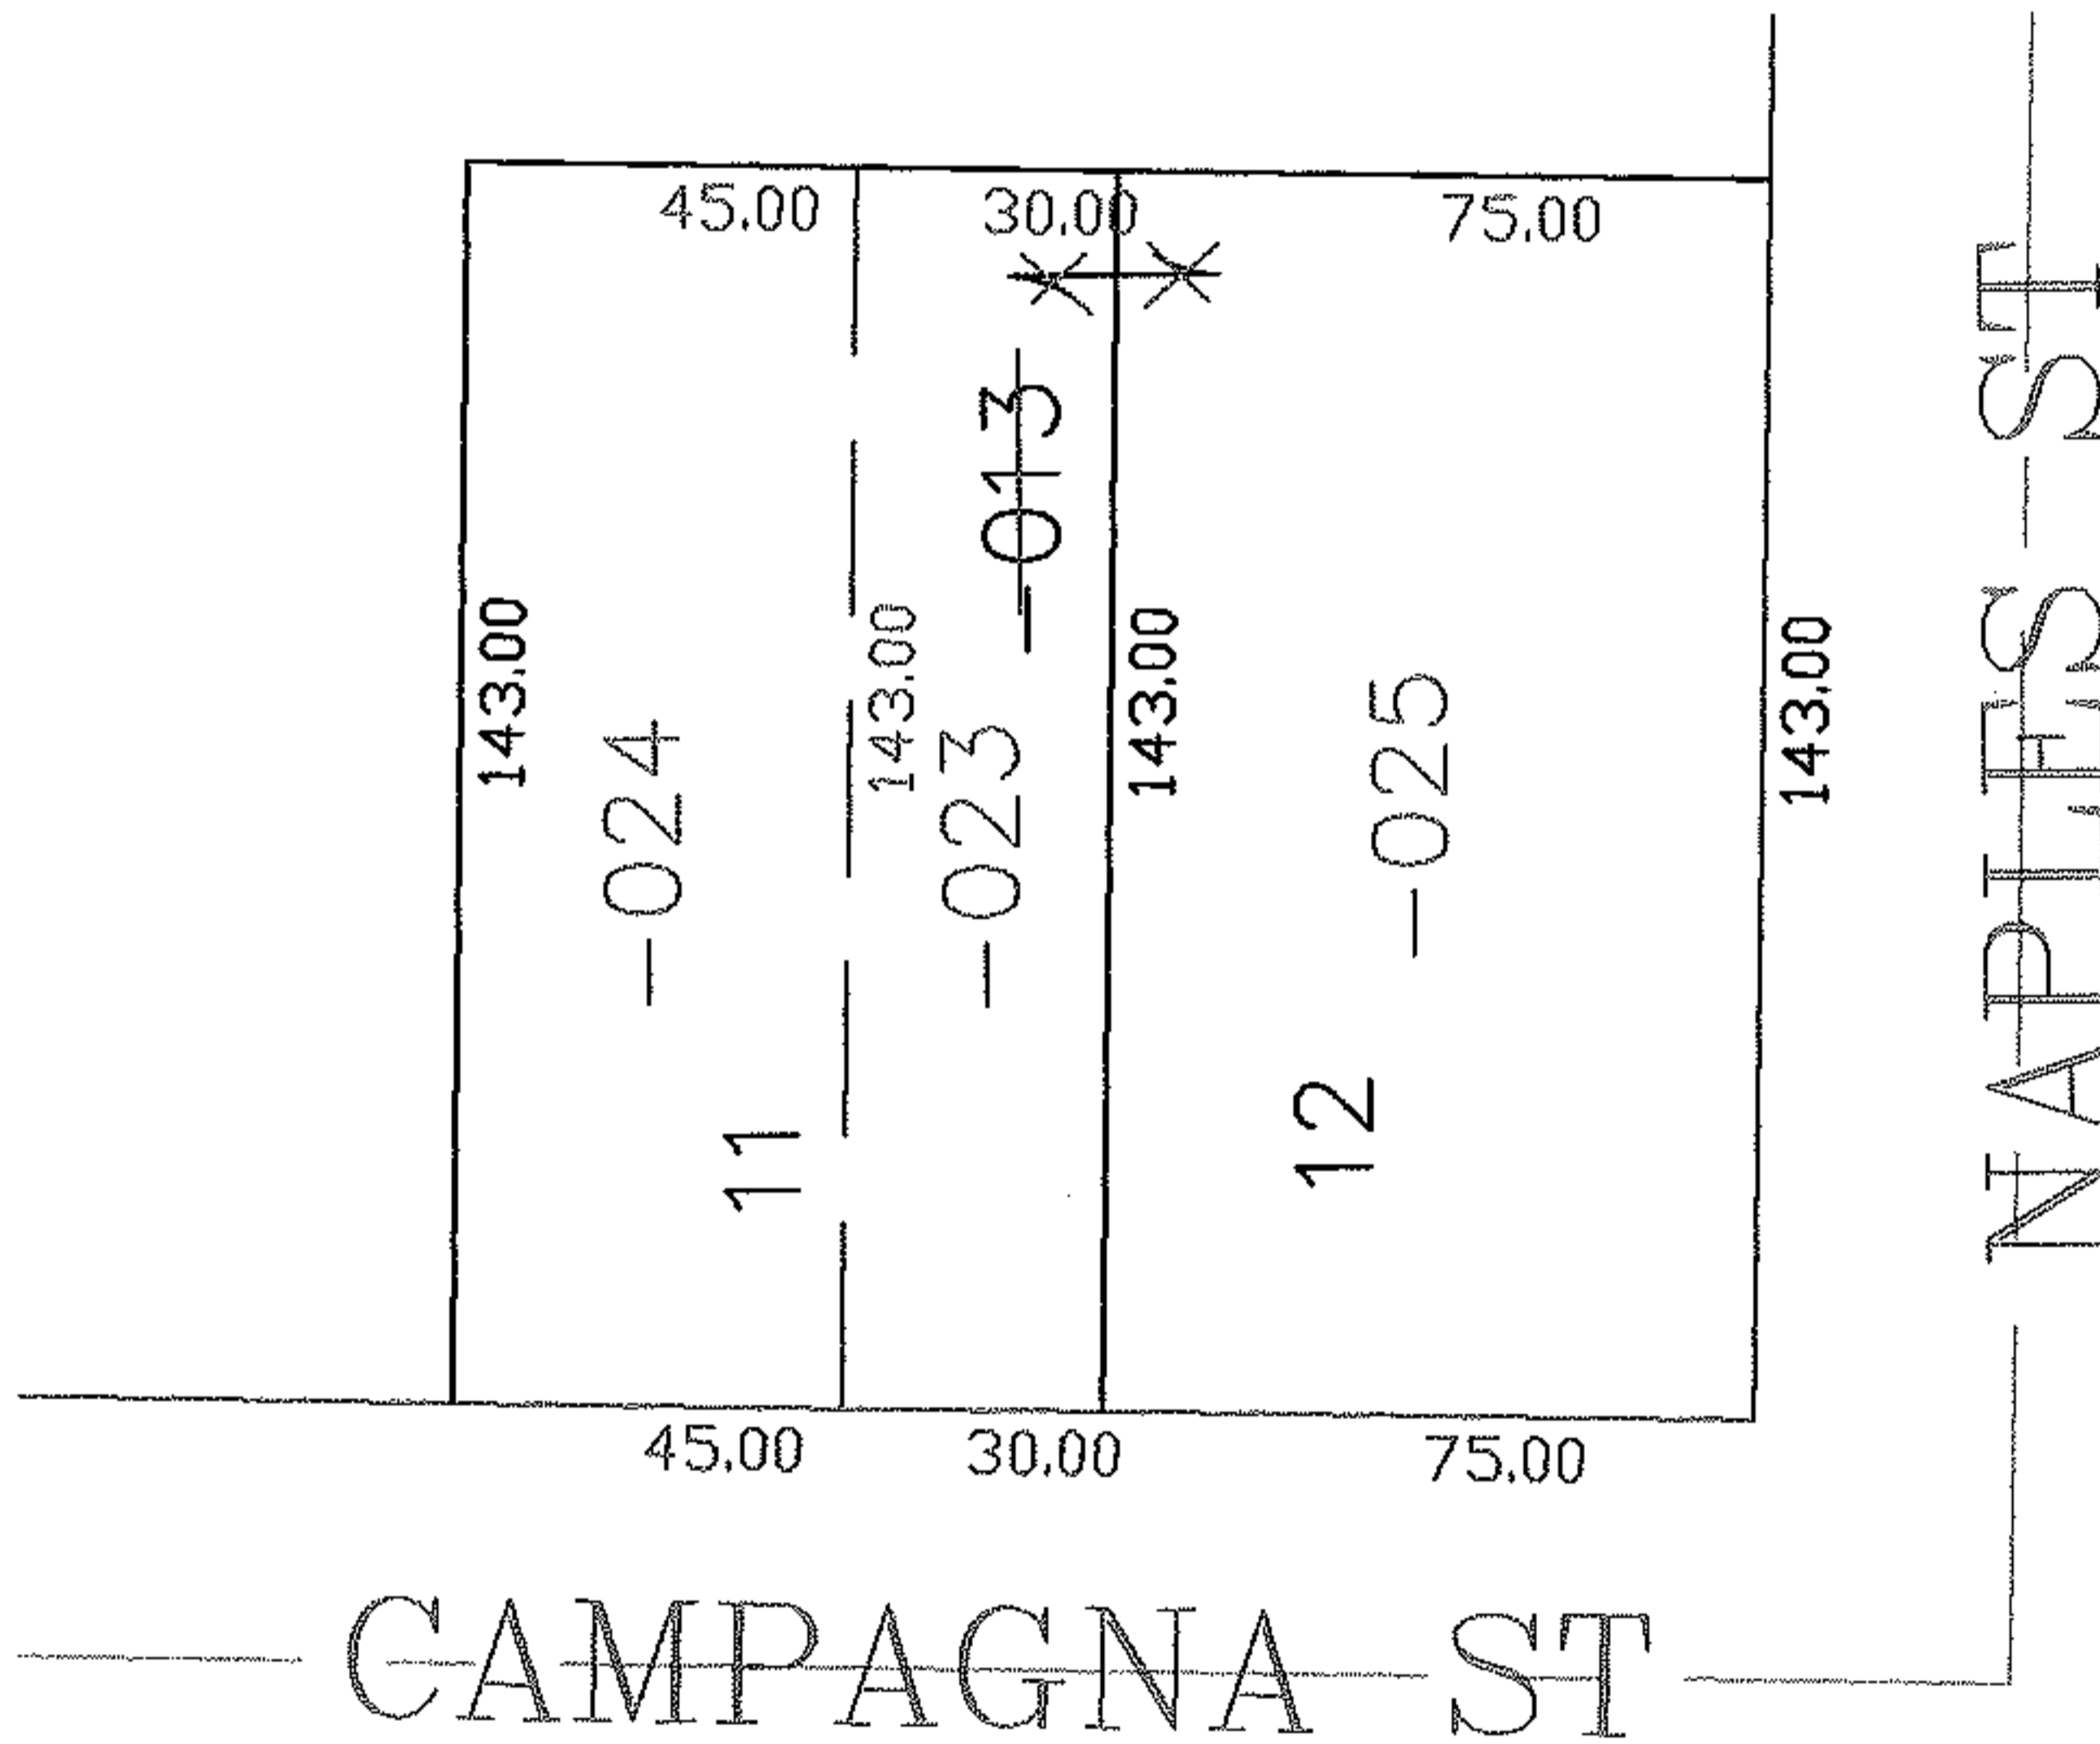


PARENT PARCEL: 06-22-008-102-013

CHILD PARCEL: 06-22-008-102-023, -024, -025

STARTING POINT: SOUTHEAST CORNER OF S/L 12 IN GULF RD HEIGHTS ALLOT

06-02280

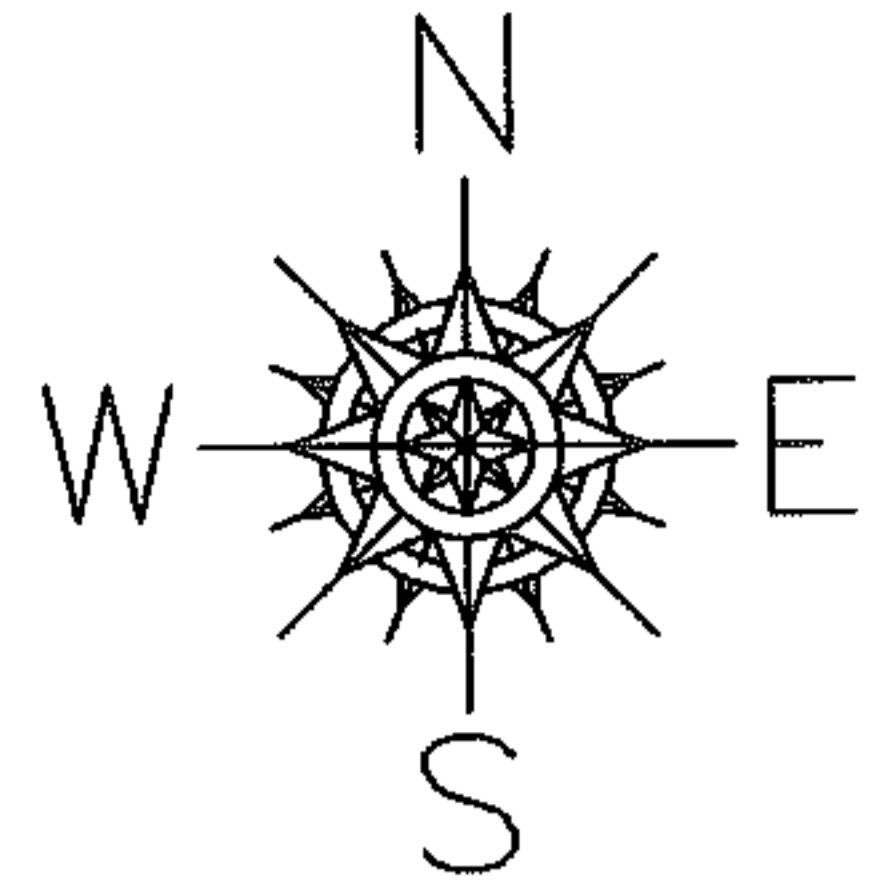

SPLITS/DEEDS PROCESSED

LORAIN COUNTY TAX MAP DEPARTMENT
226 MIDDLE AVE. ELYRIA, OHIO

SURVEYED BY: RICHARD CARLSON

CLOSURE: 0.00 : 10.000

MAP PAGE(S): 6-15

APPROVED BY: JAH DATE: 11-4-06

SCALE: 1" = 100 PRIOR INSTRUMENT: 20060156609