
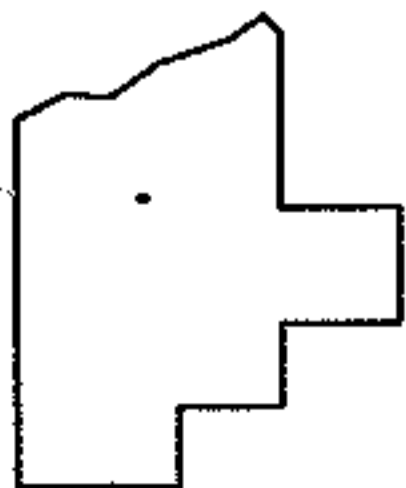
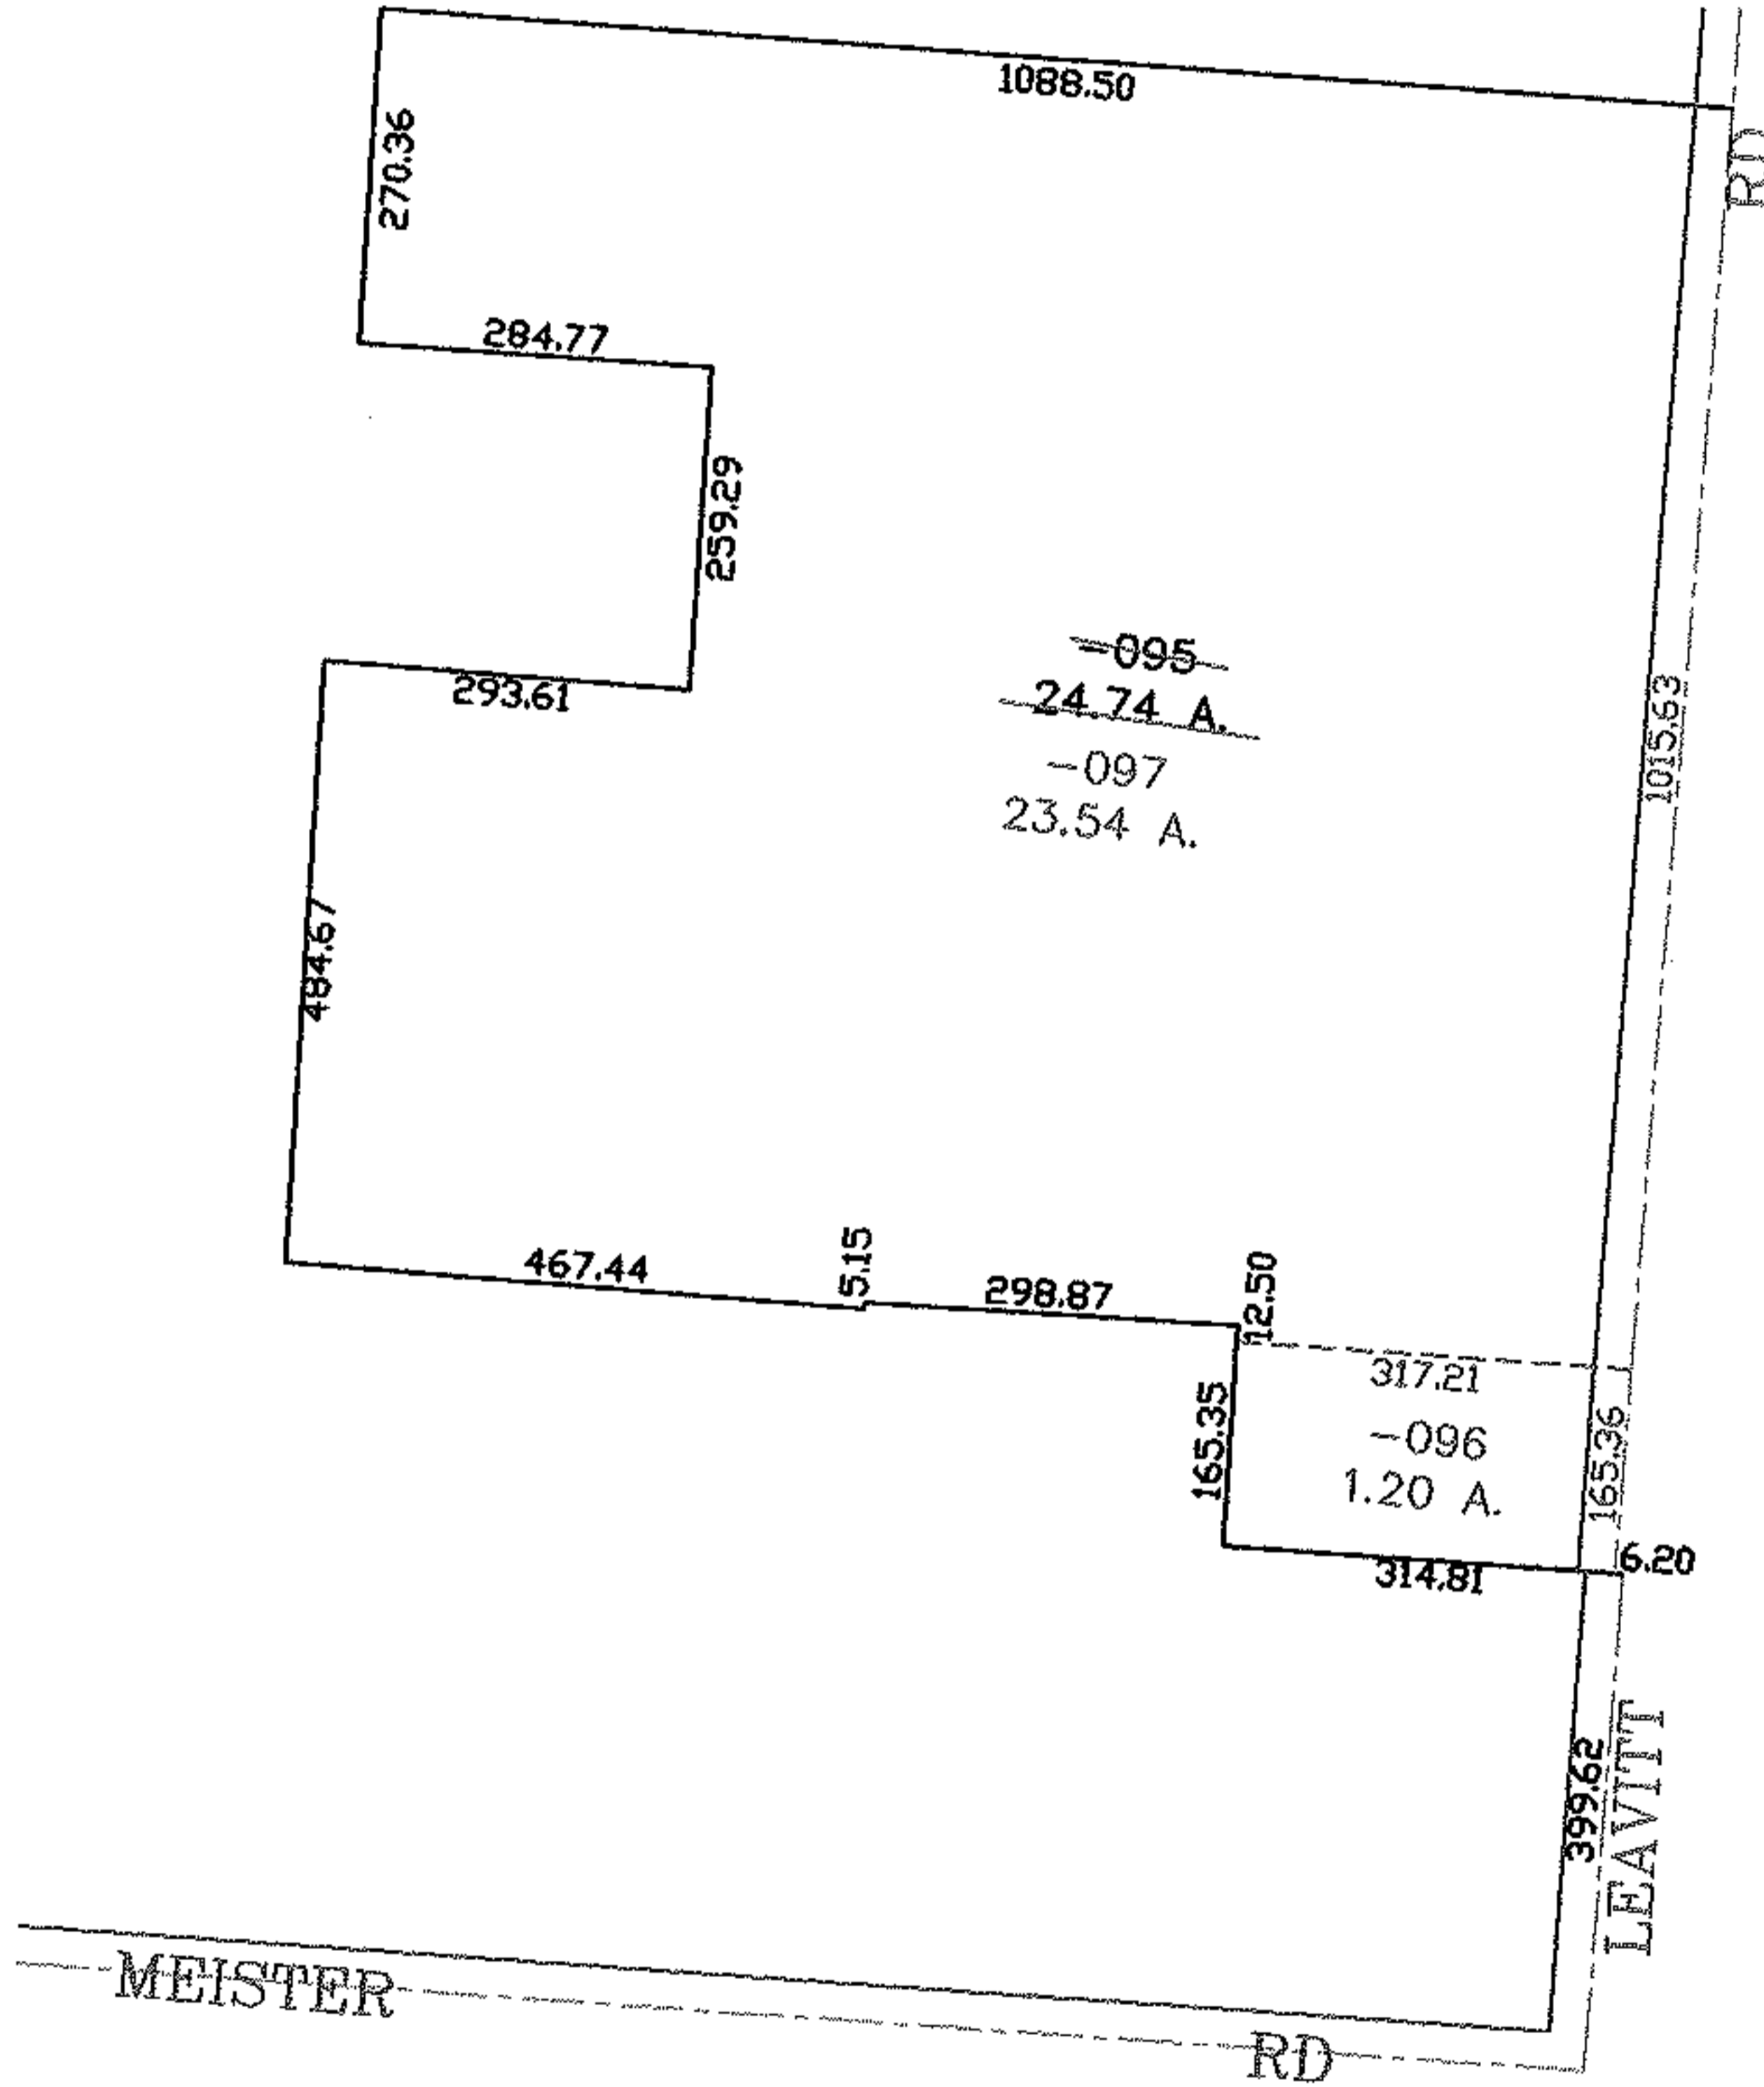


PARENT PARCEL: 02-02-018-000-095

CHILD PARCEL: 02-02-018-000-096, -097

STARTING POINT: CENTERLINE OF MEISTER RD & LEAVITT RD

06-02281

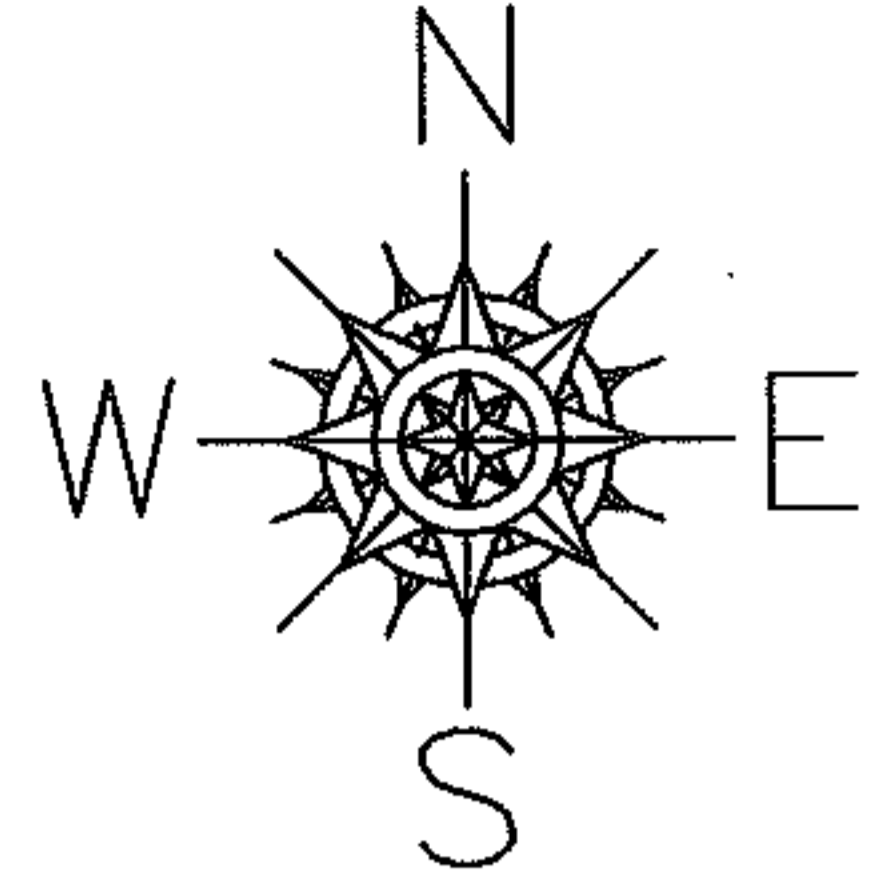

SPLITS/DEEDS PROCESSED

LORAIN COUNTY TAX MAP DEPARTMENT
226 MIDDLE AVE. ELYRIA, OHIO

SURVEYED BY: ROBERT HOY

CLOSURE: 0.00 : 10.000

MAP PAGE(S): 02-02-018-B

APPROVED BY: JAH DATE: 11-4-06

SCALE: 1" = 300 PRIOR INSTRUMENT: 20060140986