
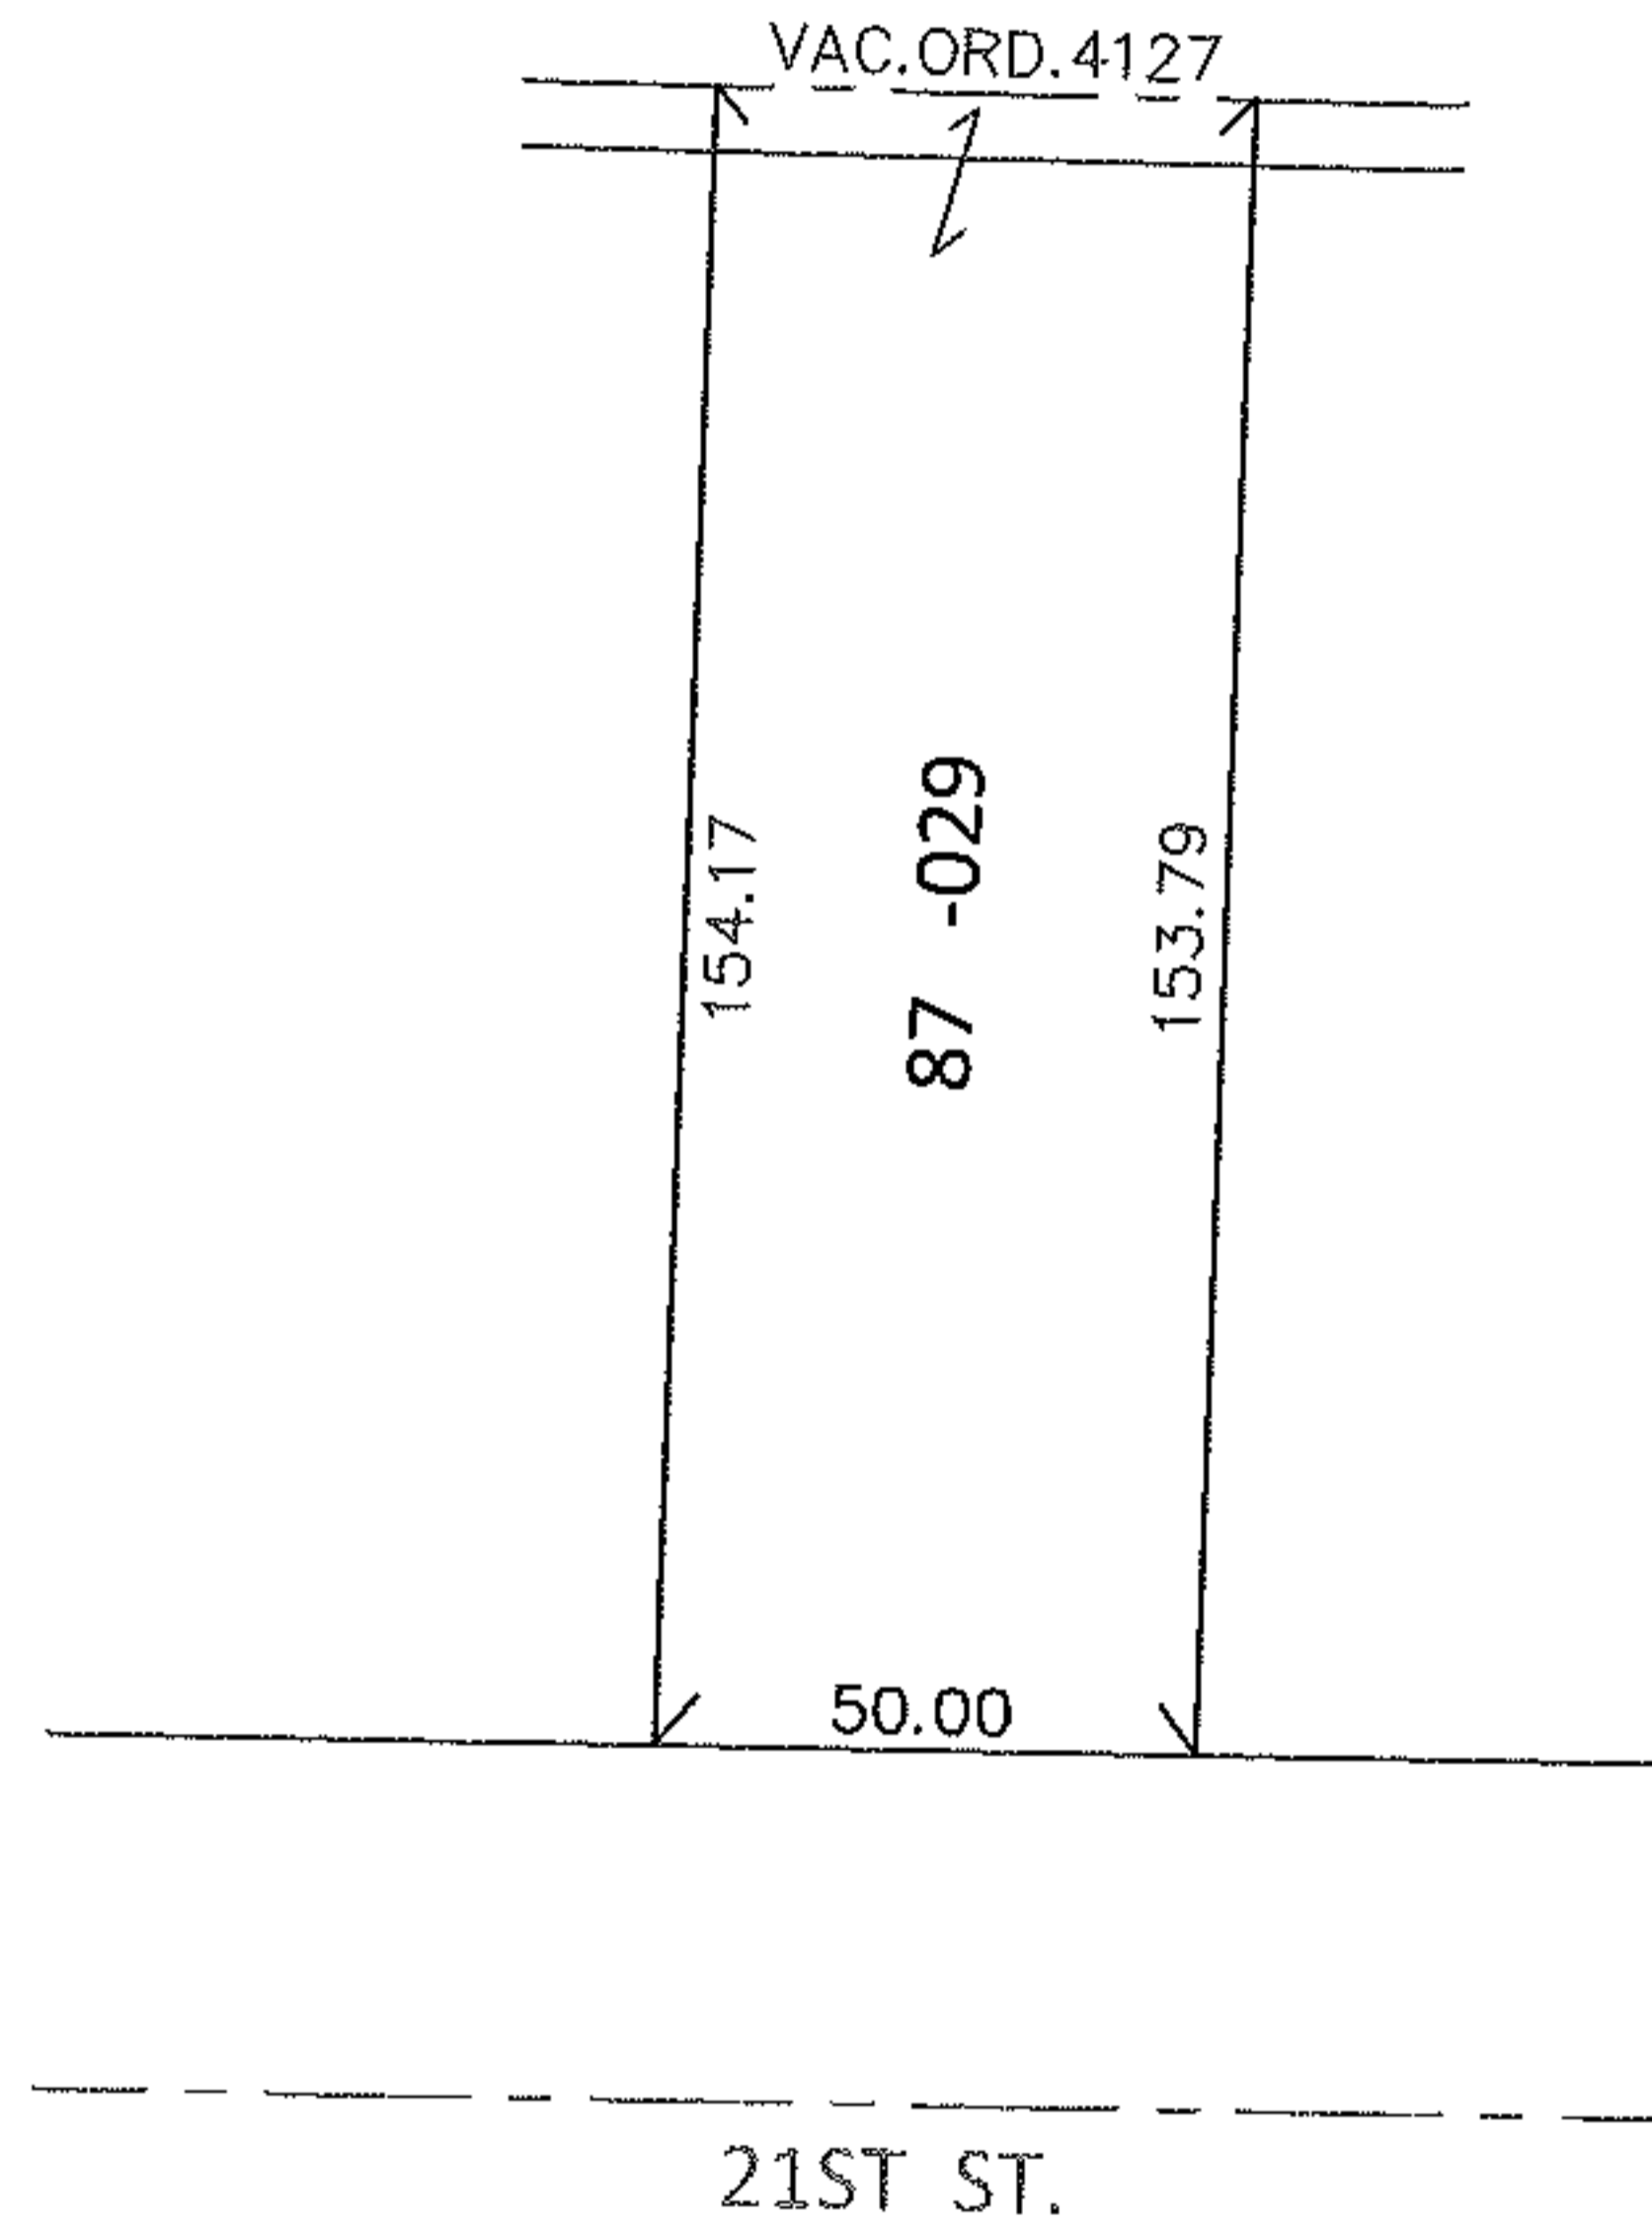


PARENT PARCEL: 02-02-025-120-029

CHILD PARCEL: _____

STARTING POINT: S/L 87 IN OAKLAND ADD. (VOL.4 PG.17)

11-02283-C

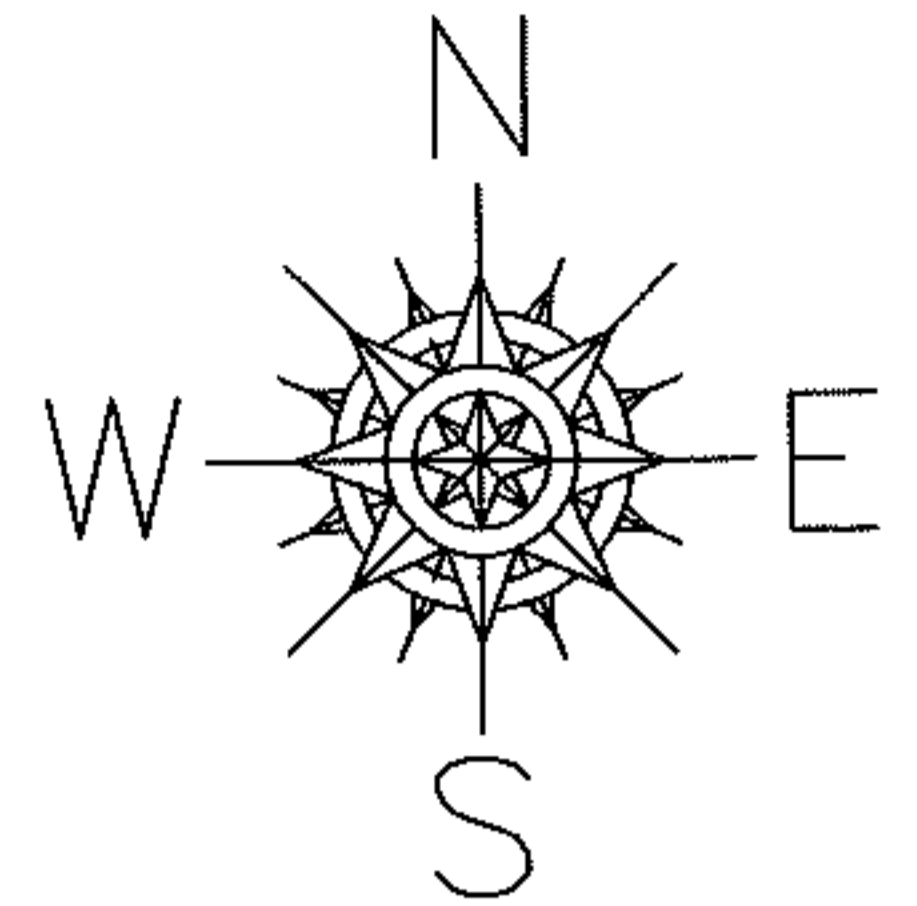


DEPTH CORRECTION

02-02-025-120-029

154.17

50 X ~~152~~

PER PLAT AND VAC. ORD.

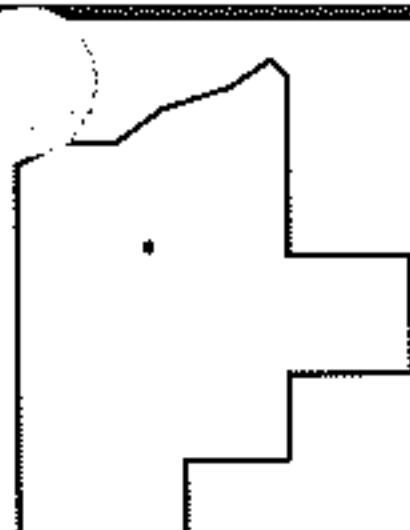

SPLITS/DEEDS PROCESSED

LORAIN COUNTY TAX MAP DEPARTMENT
226 MIDDLE AVE. ELYRIA, OHIO

SURVEYED BY: N/A

CLOSURE: N/A

MAP PAGE(S): 2-02-025-B

APPROVED BY: RRM DATE: 11-20-12

SCALE: 1"= 50' PRIOR INST.: 20120414976