
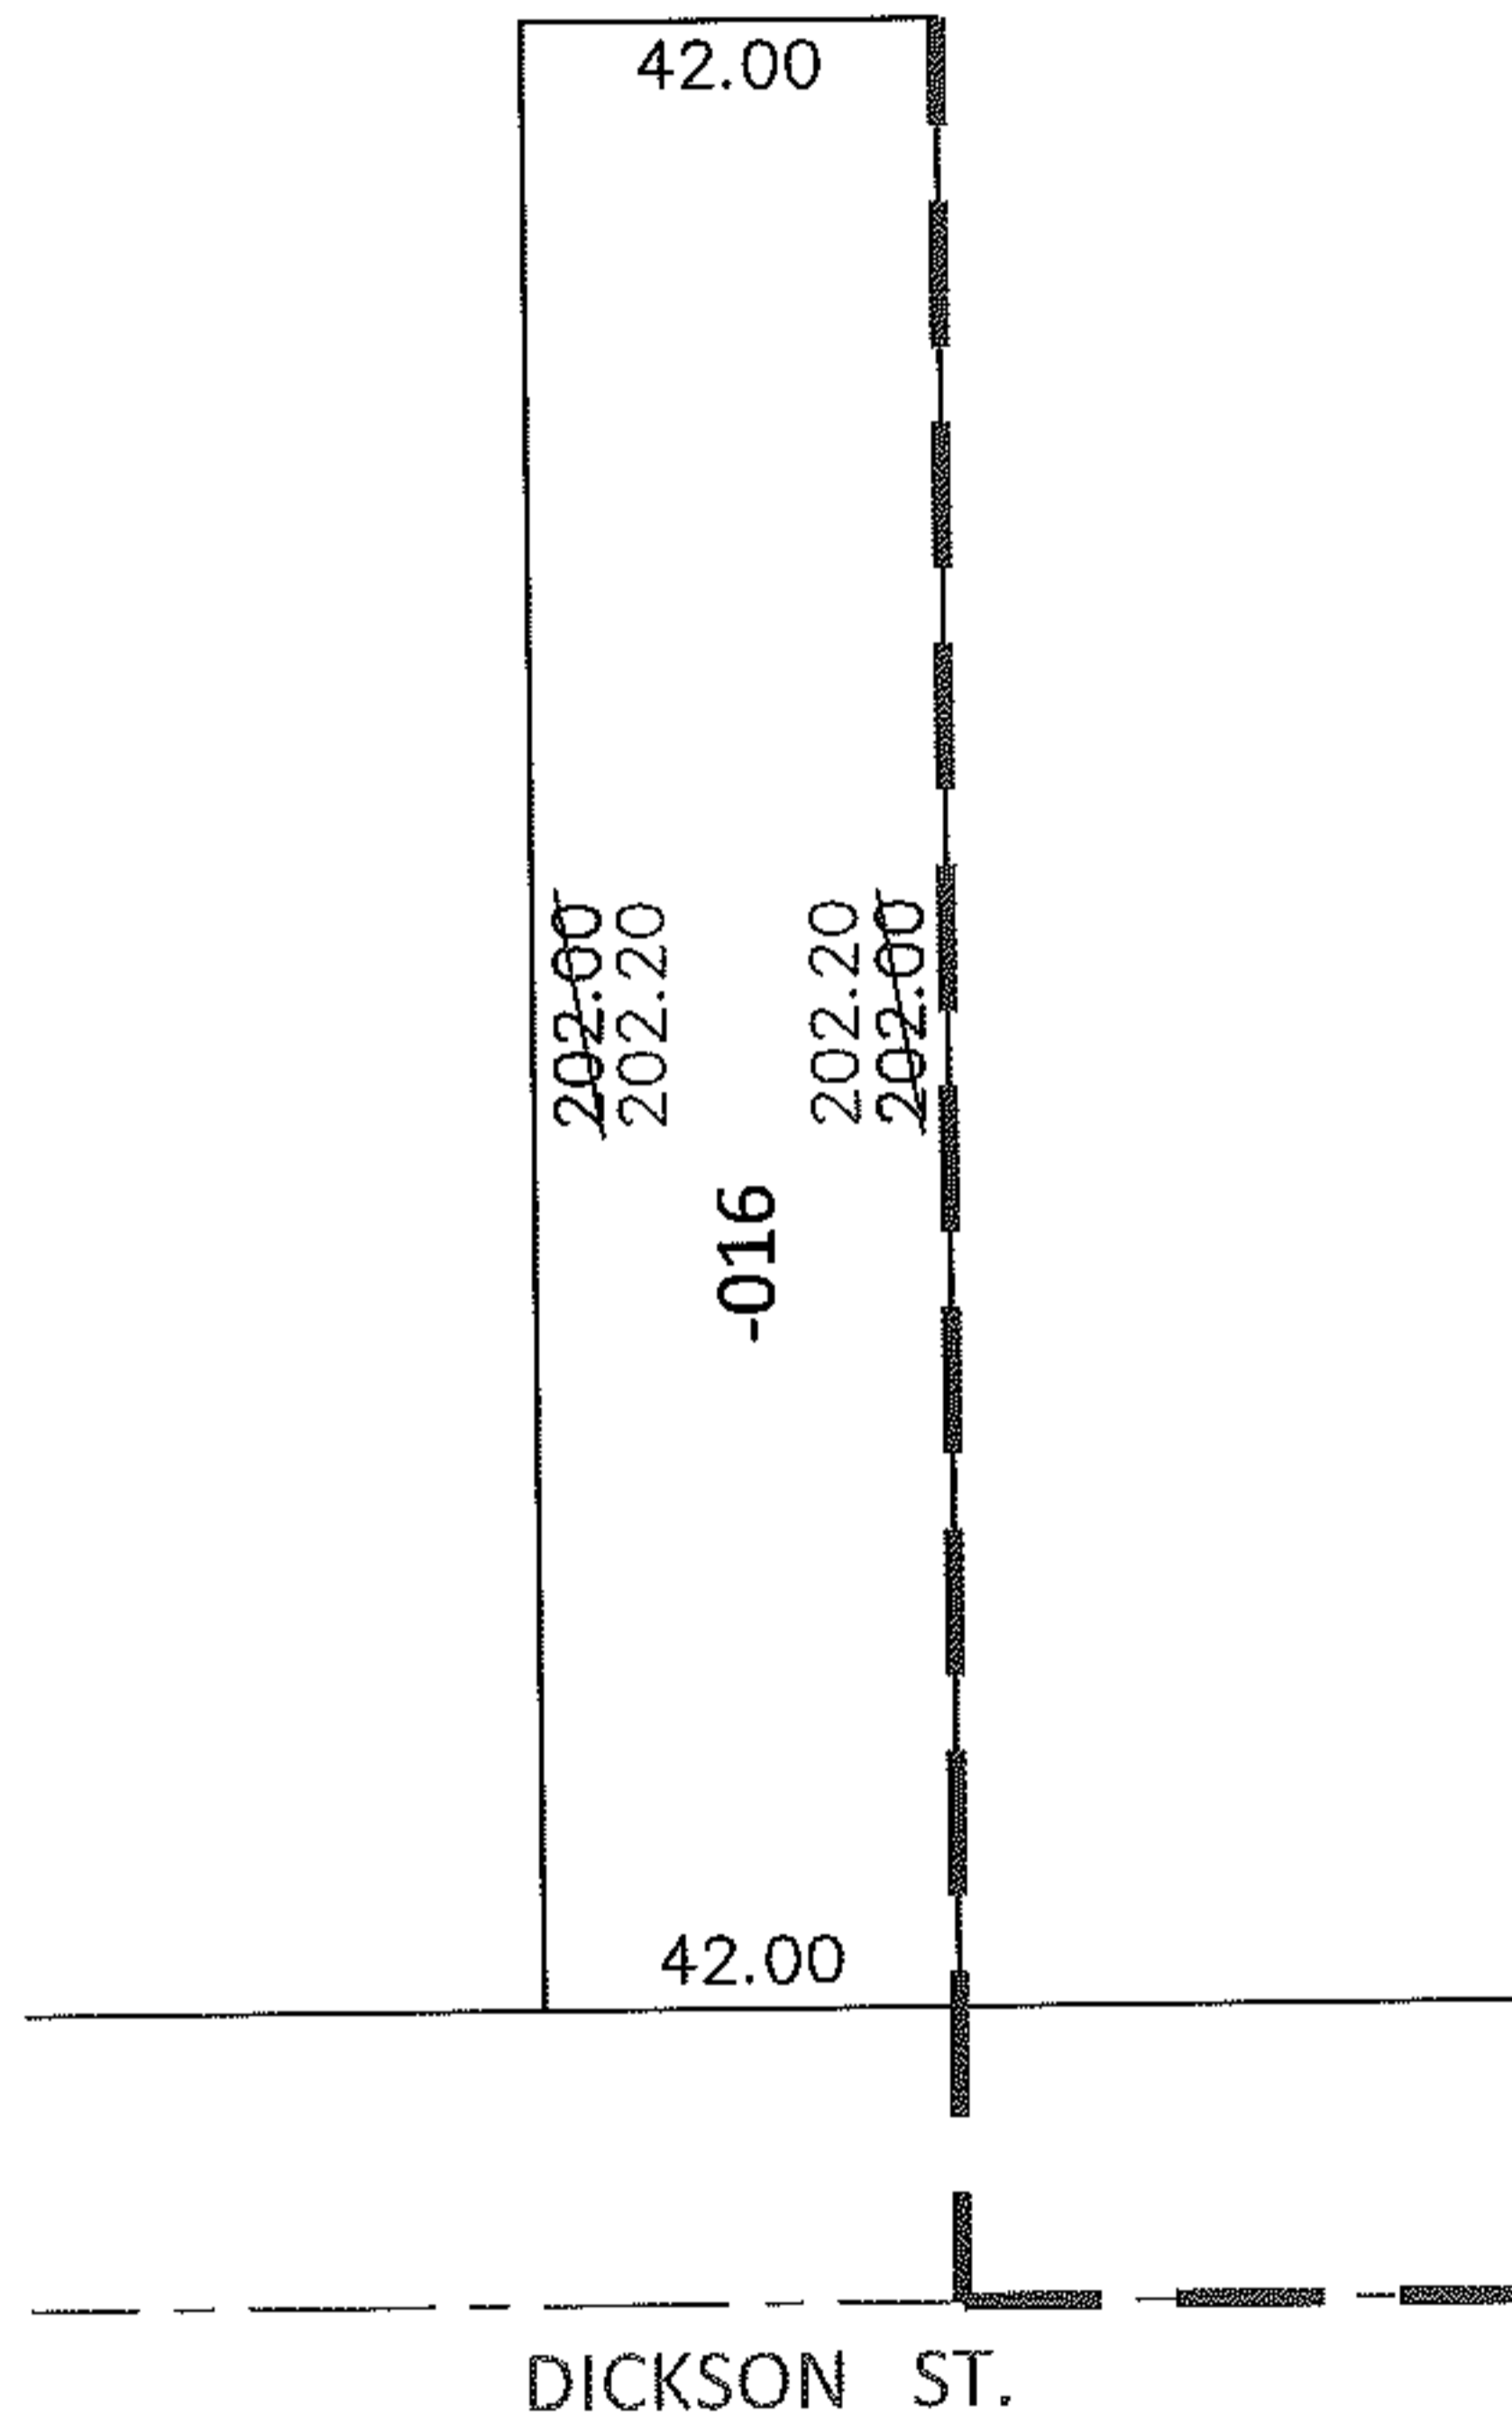


PARENT PARCEL: 18-00-022-103-016

CHILD PARCEL:

STARTING POINT: N/A

11-02284-C

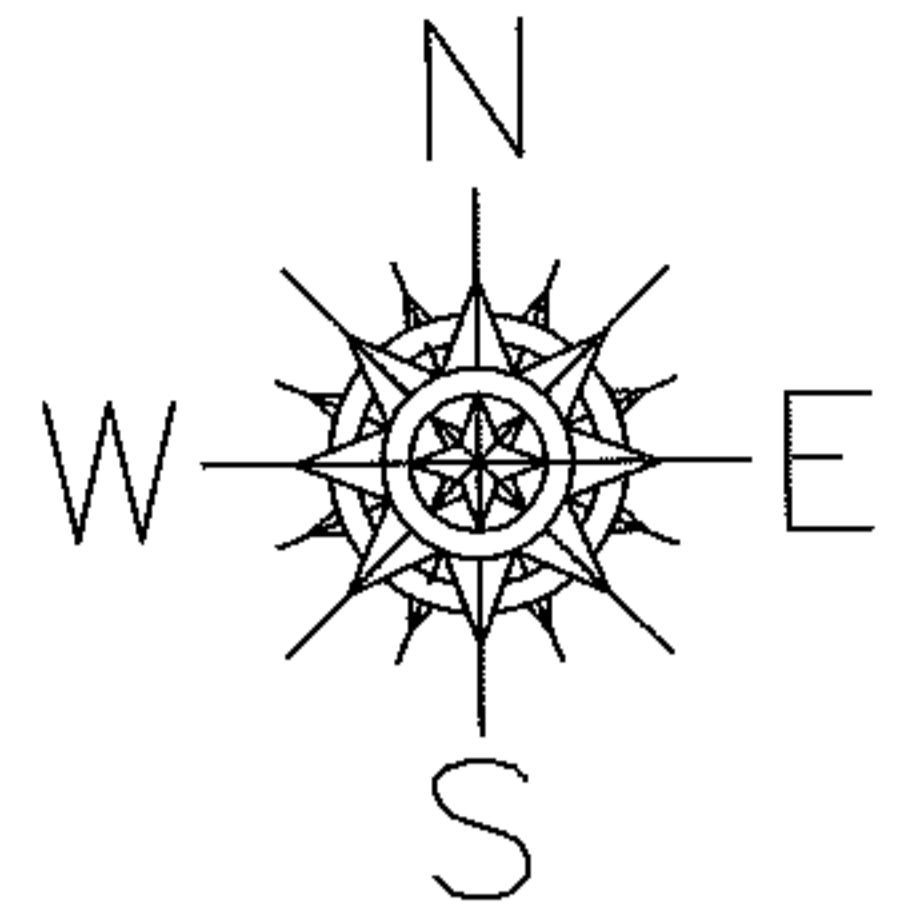


DEPTH CORRECTION

18-00-022-103-016

202.20

42 X ~~202~~

PER PRIOR DEEDS

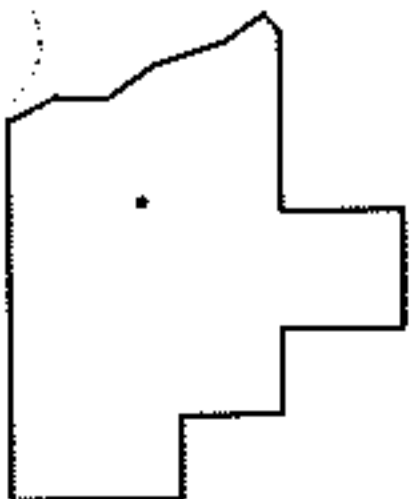

SPLITS/DEEDS PROCESSED

LORAIN COUNTY TAX MAP DEPARTMENT
226 MIDDLE AVE. ELYRIA, OHIO

SURVEYED BY: N/A

CLOSURE: N/A

MAP PAGE(S): 18-00-022-A

APPROVED BY: RRM DATE: 3-14-13

SCALE: 1"= 50' PRIOR INST.: 20010761665