




MASTER

PARENT PARCEL: 02-01-003-118-014

CHILD PARCEL: 02-01-003-118-016, -017

STARTING POINT: SIDELINE OF 9TH ST & BROADWAY BLVD

07-02285

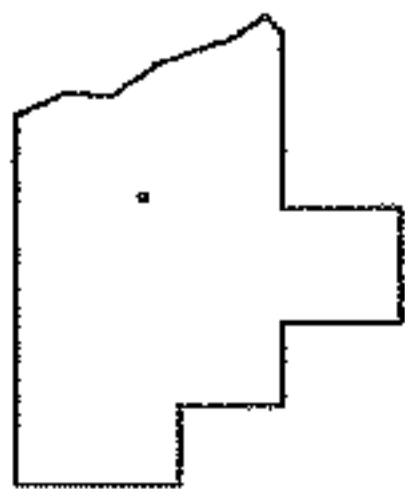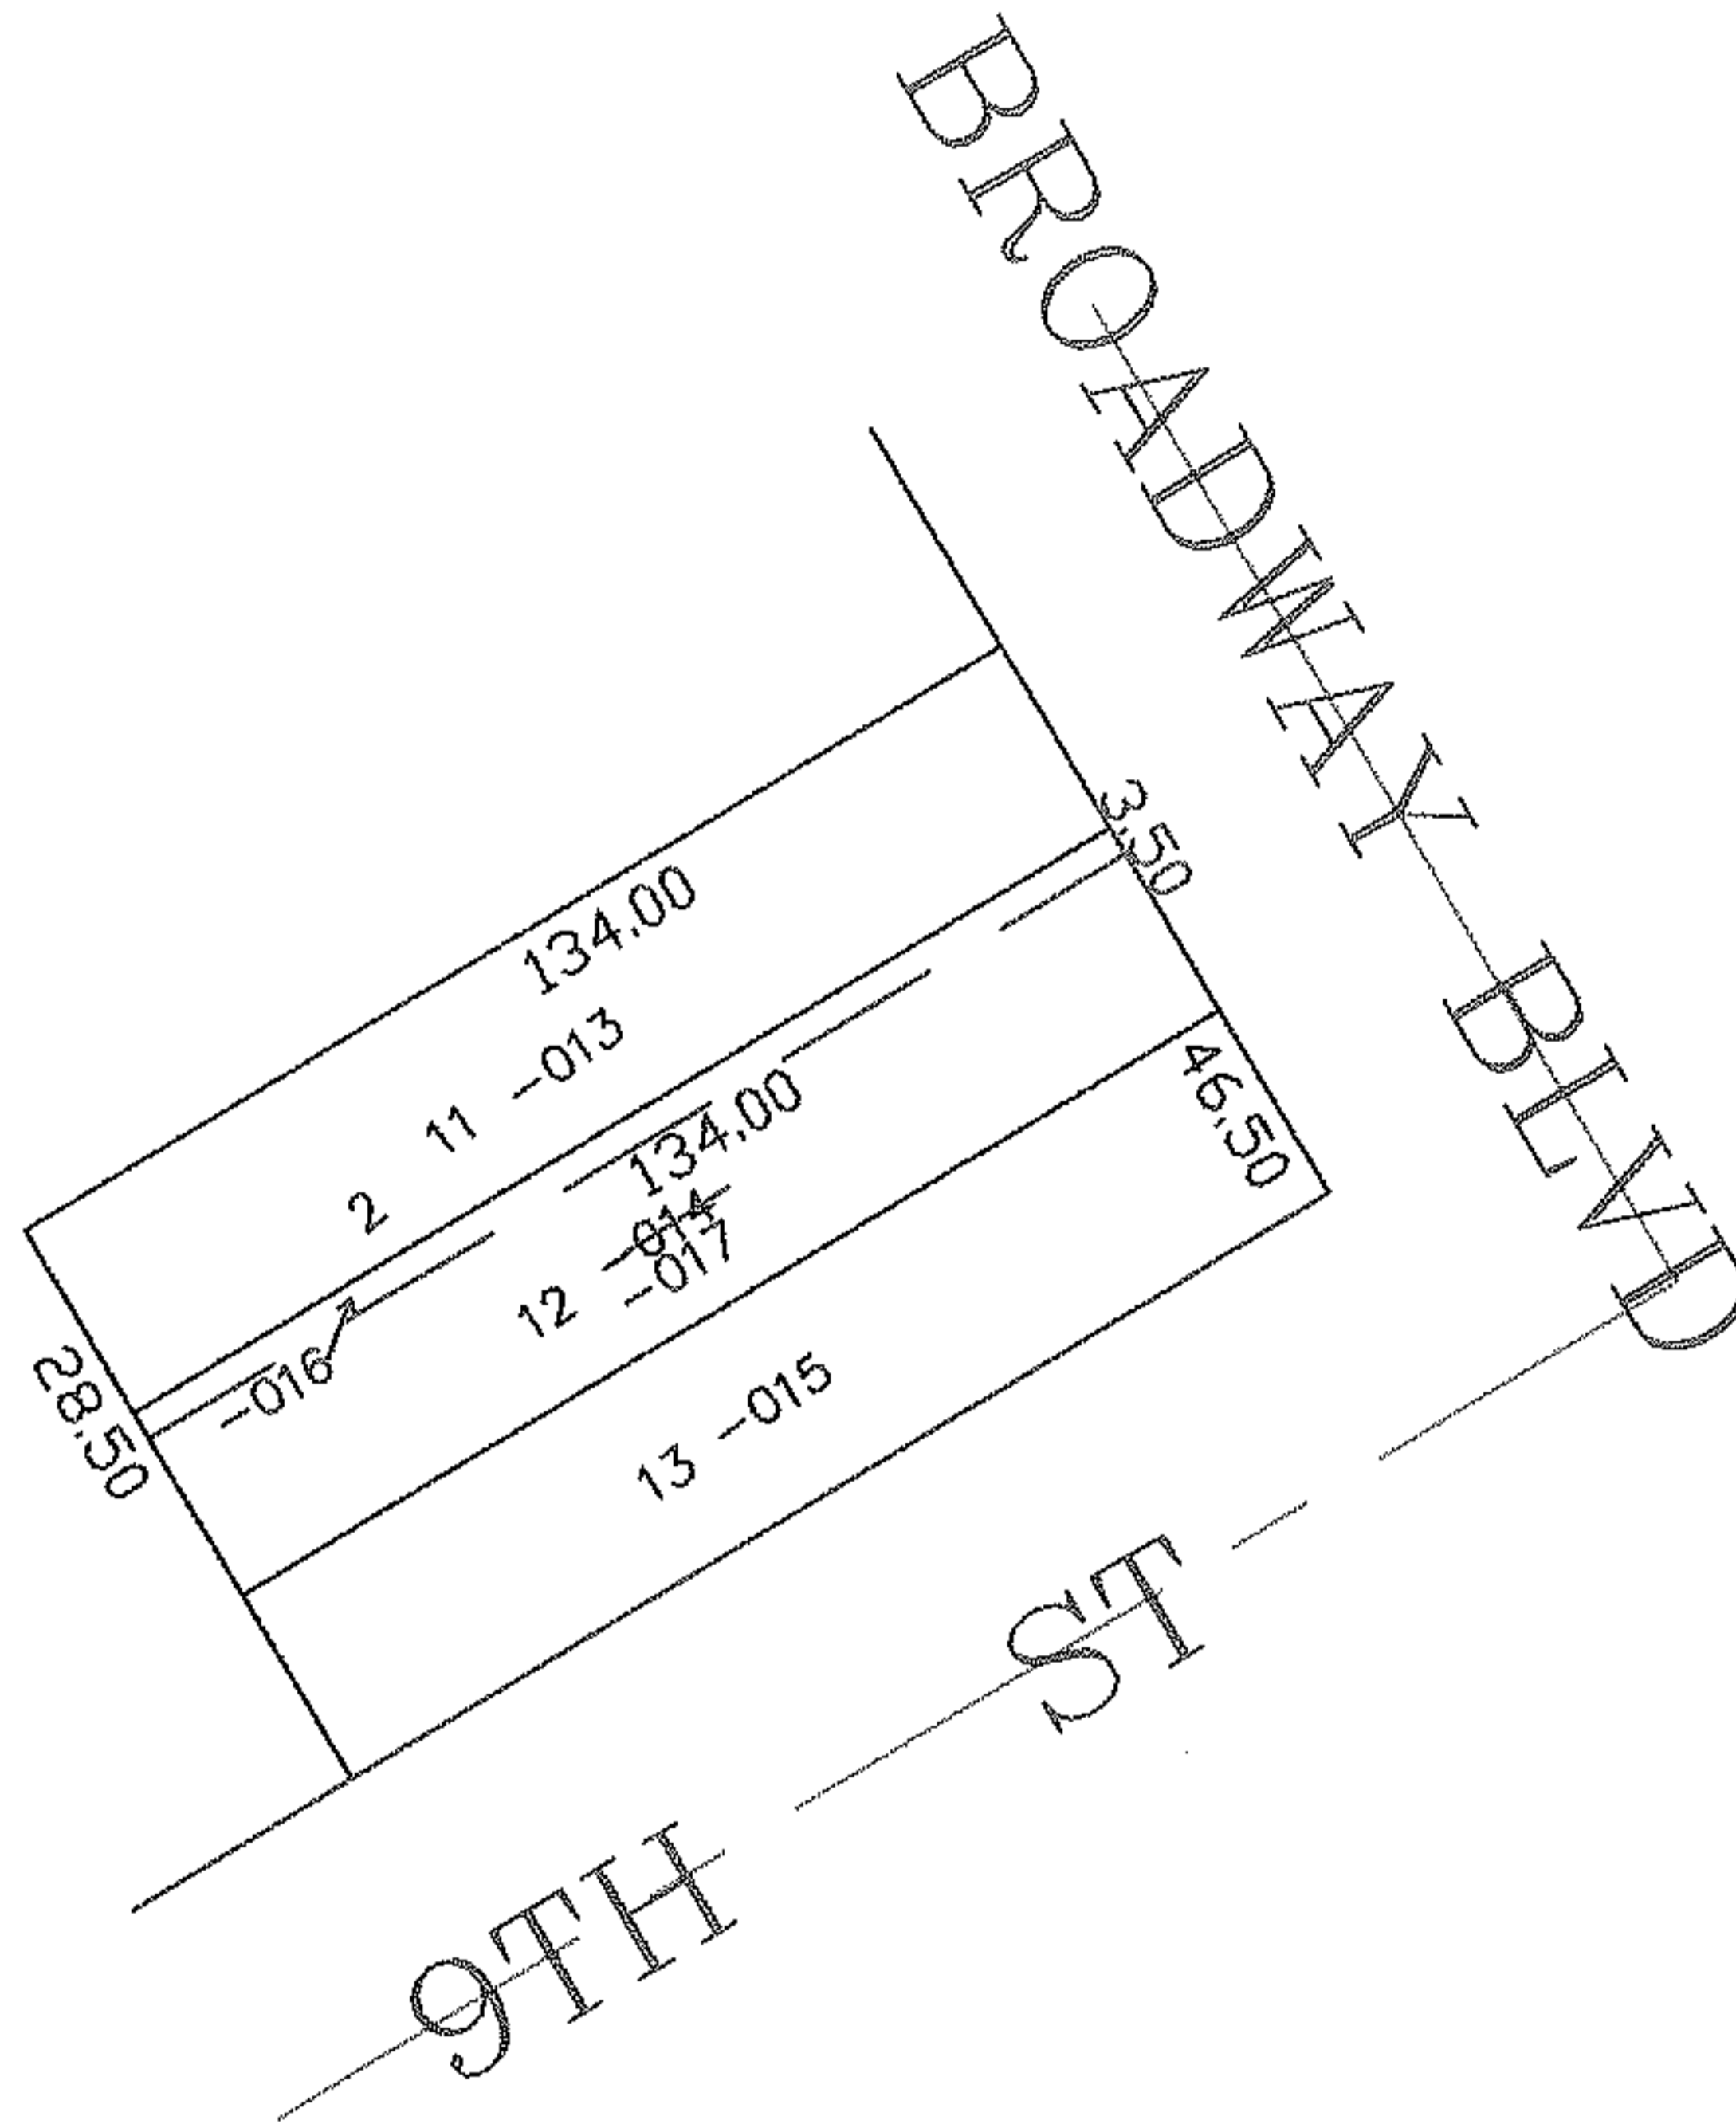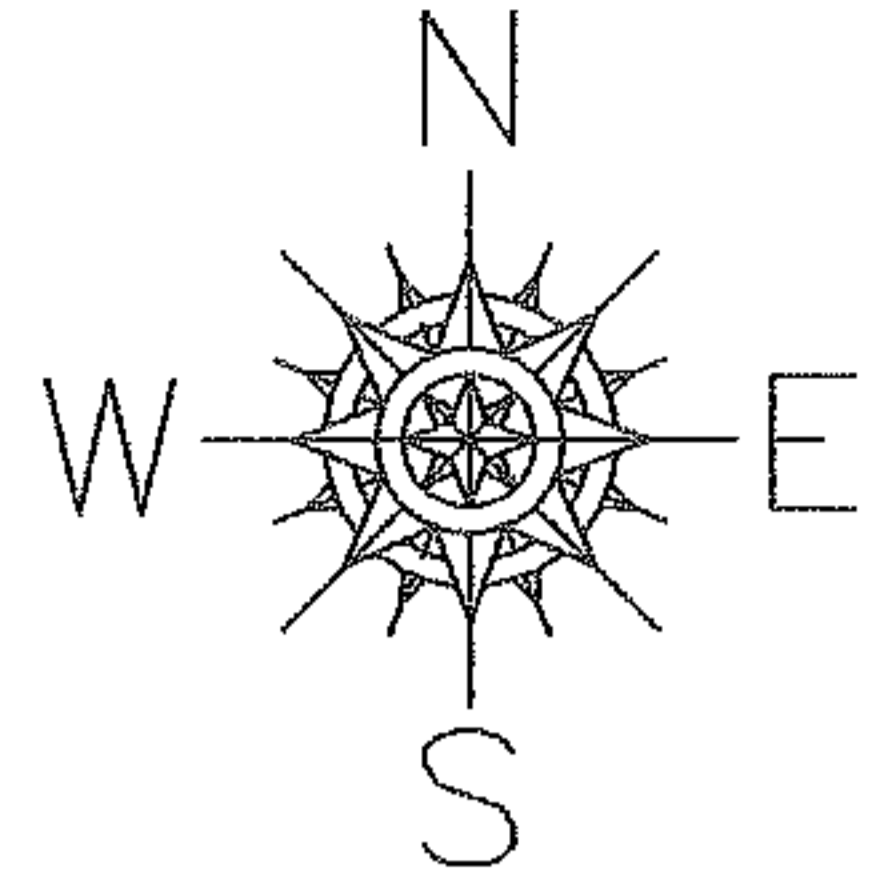

SPLITS/DEEDS PROCESSED

LORAIN COUNTY TAX MAP DEPARTMENT
226 MIDDLE AVE. ELYRIA, OHIO

SURVEYED BY: DANE HAPONEK

CLOSURE: 0.00 : 10,000

MAP PAGE(S): 02-01-003-C

APPROVED BY: JAH DATE: 6-8-07

SCALE: 1" = 100 PRIOR INSTRUMENT: OR 423/201