
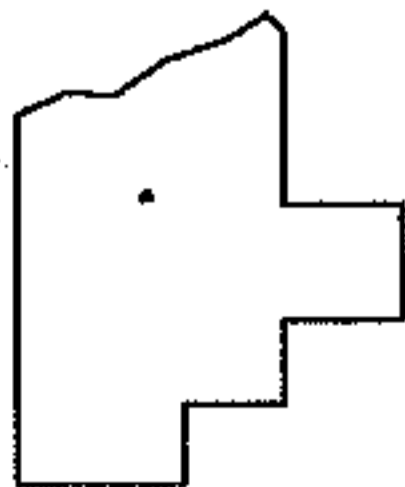
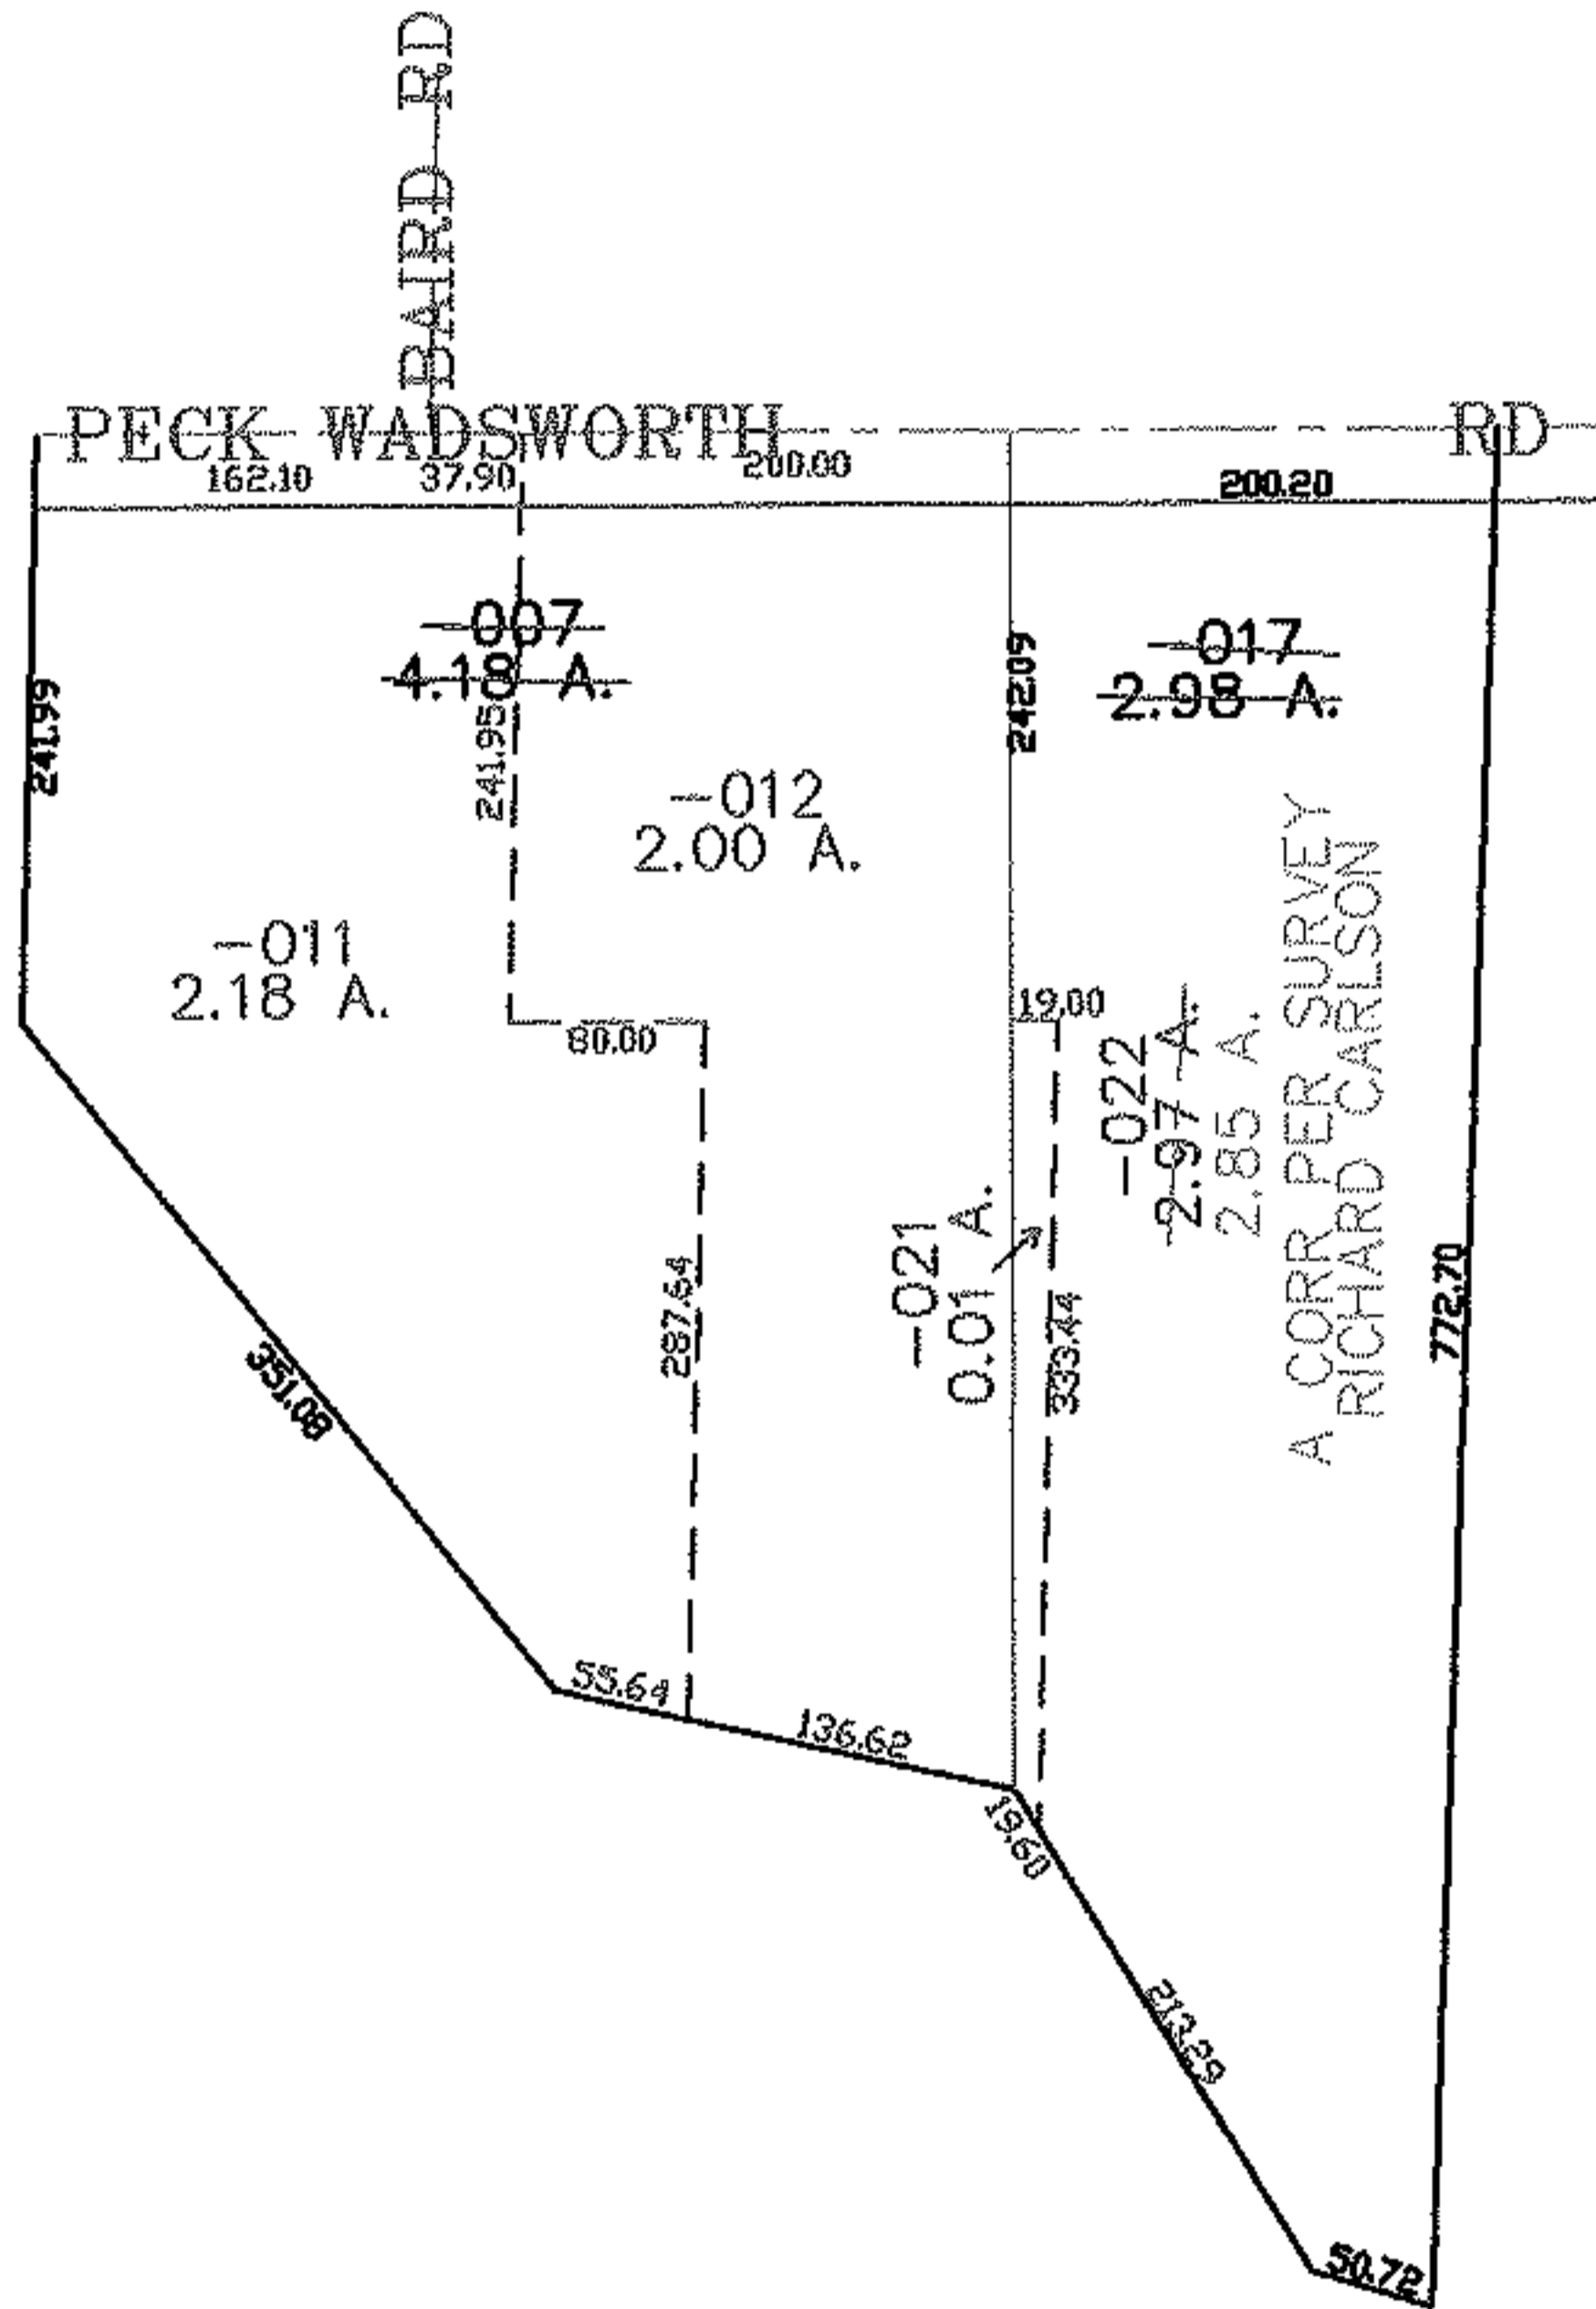


PARENT PARCEL: 17-07-005-000-007, 17-07-004-000-017
CHILD PARCEL: 17-07-005-000-011, -012 17-07-004-000-021, -022
STARTING POINT: CENTERLINE OF PECK WADSWORTH RD & BAIRD RD

06-02286

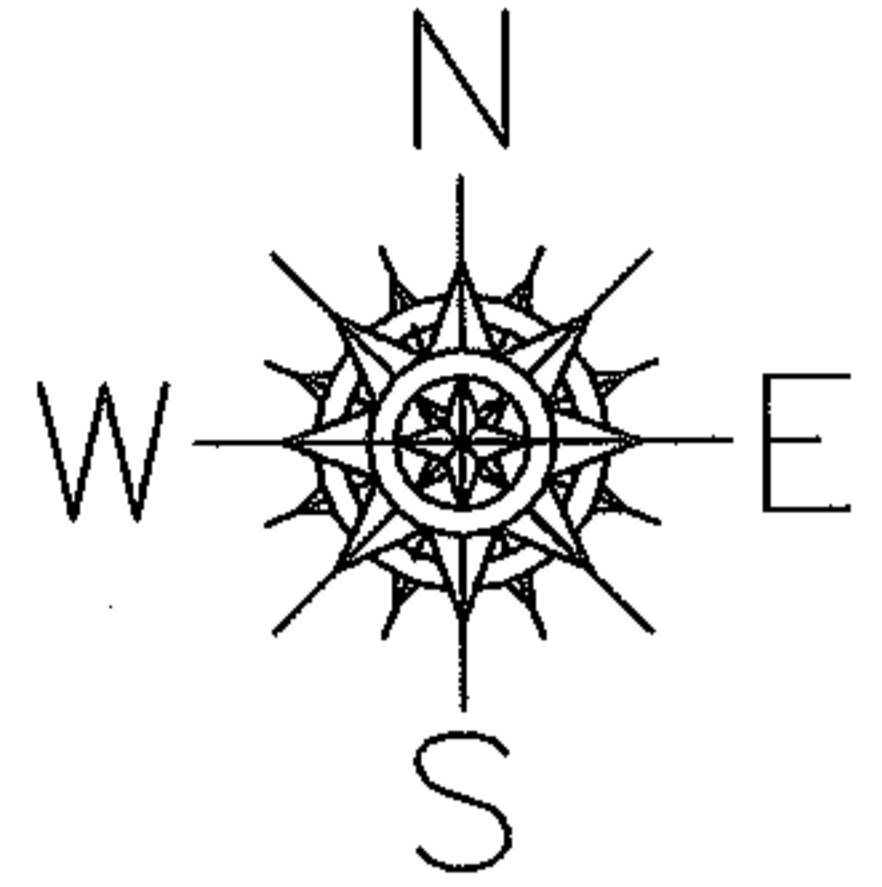

SPLITS/DEEDS PROCESSED
LORAIN COUNTY TAX MAP DEPARTMENT
226 MIDDLE AVE. ELYRIA, OHIO

SURVEYED BY: RICHARD CARLSON
CLOSURE: 0.00 : 10,000
MAP PAGE(S): 17-B
APPROVED BY: JAH DATE: 12-12-06
SCALE: 1" = 200 PRIOR INSTRUMENT: 20050061699