

RASTER

PARENT PARCEL: SEE BELOW
CHILD PARCEL: XX-XX-XXX-XXX-XXX
STARTING POINT: XXXXXX

11-02287-A

ACREAGE CORRECTION

12-00-033-000-065

~~17.53 A.~~

17.56 A.

12-00-034-000-056

~~17.97 A.~~



16.10 A.

12-00-047-103-003

~~21.64 A.~~

22.80 A.

CORR. PER
INST. #20010746427

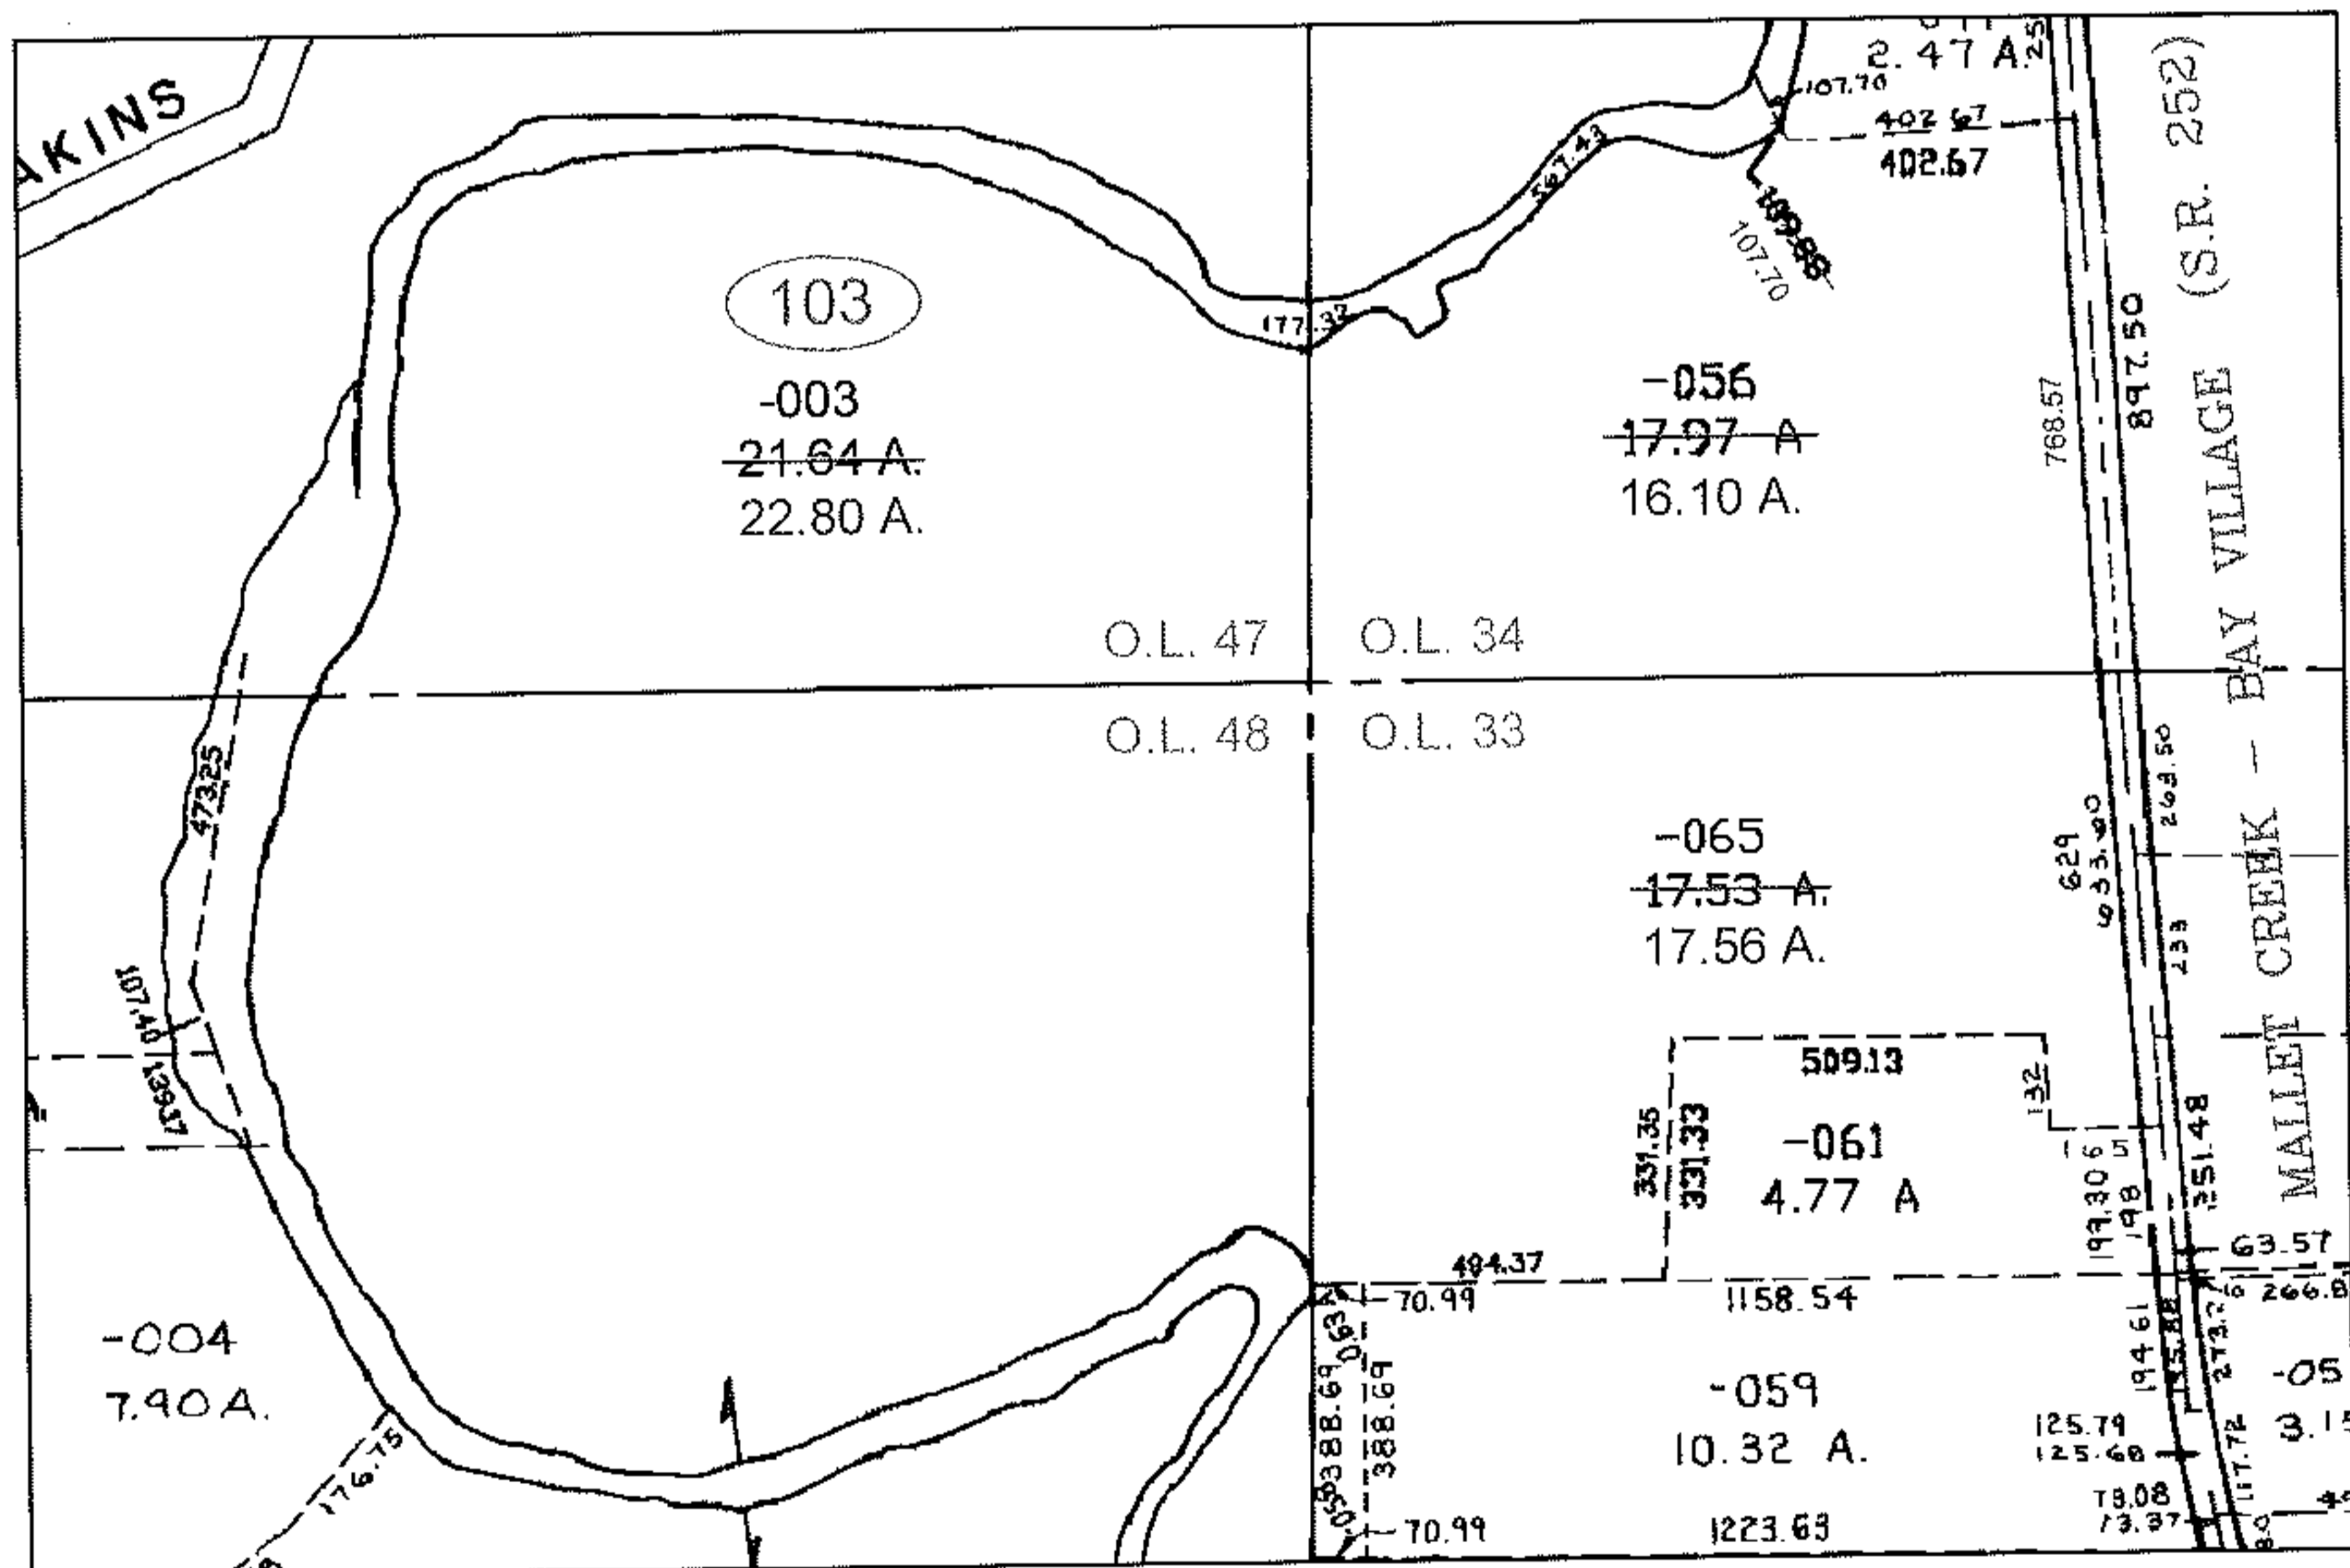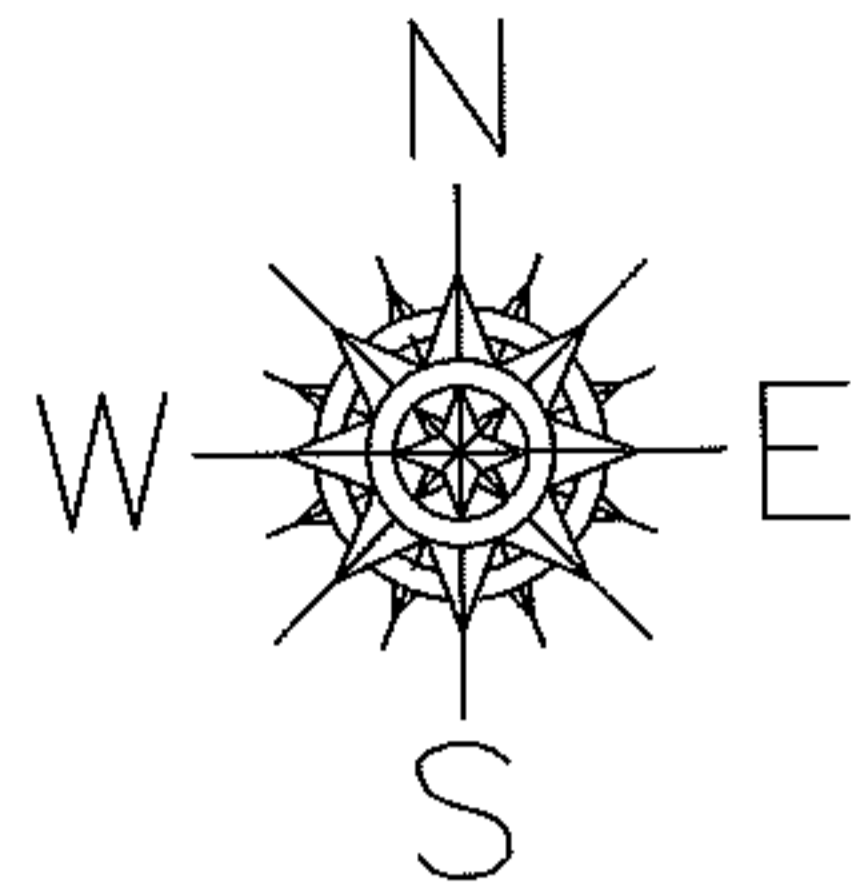

SPLITS/DEEDS PROCESSED

LORAIN COUNTY TAX MAP DEPARTMENT
226 MIDDLE AVE. ELYRIA, OHIO

SURVEYED BY: NONE
CLOSURE: NONE
MAP PAGE(S): 12-G & 12-00-047-B
APPROVED BY: TJS DATE: 5/19/11
SCALE: 1" = 500 PRIOR INST.: 20010746427