
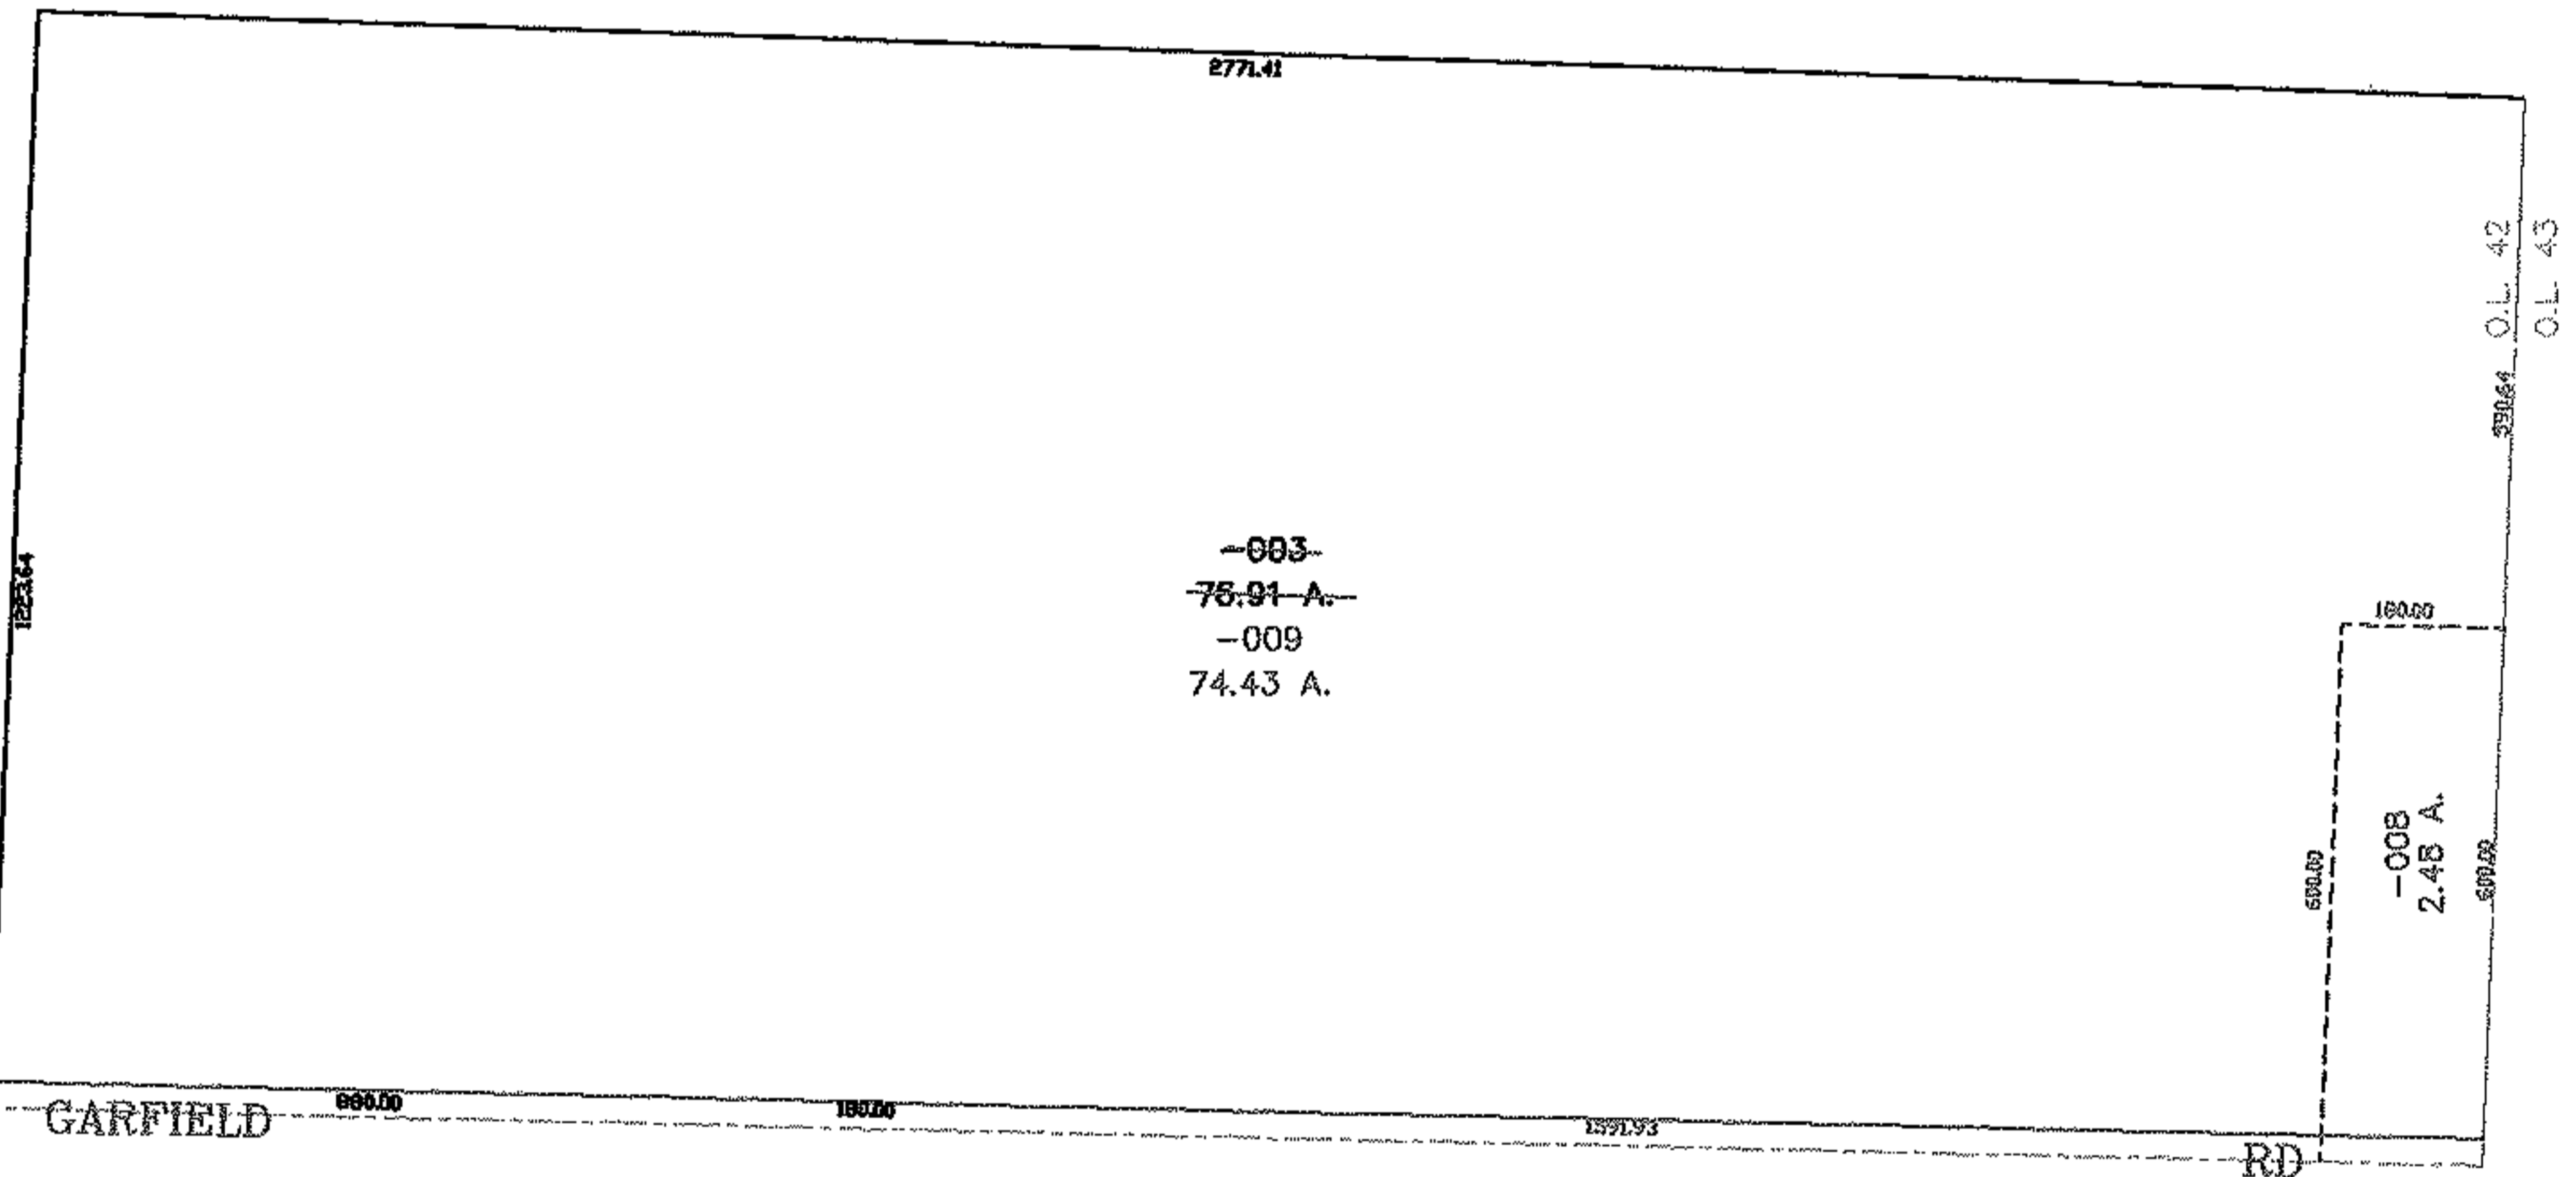


PARENT PARCEL: 09-00-042-000-003

CHILD PARCEL: 09-00-042-000-008, -009

STARTING POINT: CENTERLINE OF GARFIELD RD & O.L. 42

06-02287

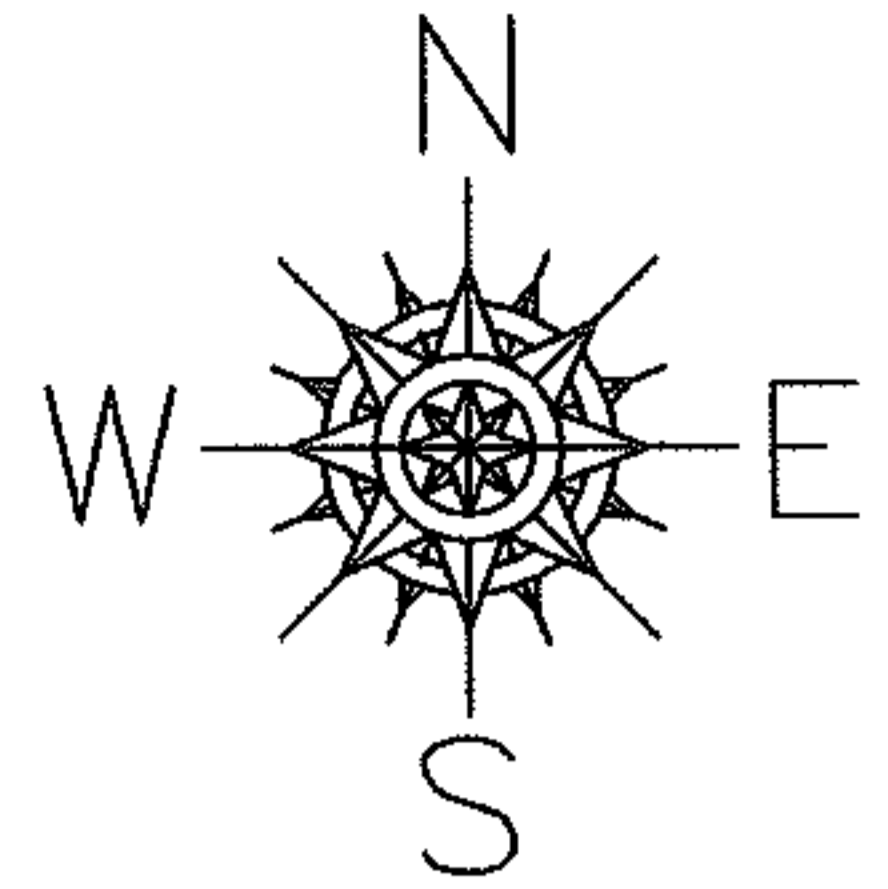

SPLITS/DEEDS PROCESSED

LORAIN COUNTY TAX MAP DEPARTMENT  
226 MIDDLE AVE. ELYRIA, OHIO

SURVEYED BY: DANE HAPONEK

CLOSURE: 0.00 : 10,000

MAP PAGE(S): 09-00-042-A

APPROVED BY: JAH DATE: 12-11-06

SCALE: 1" = 100' PRIOR INSTRUMENT: 1990118256