
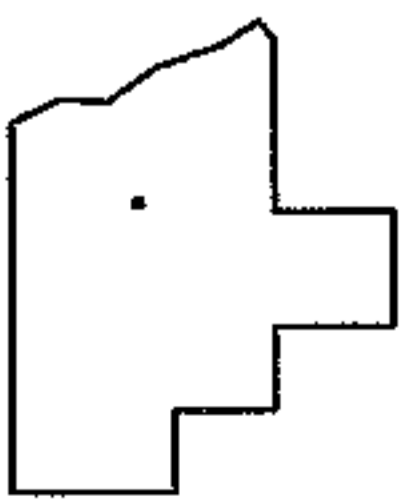
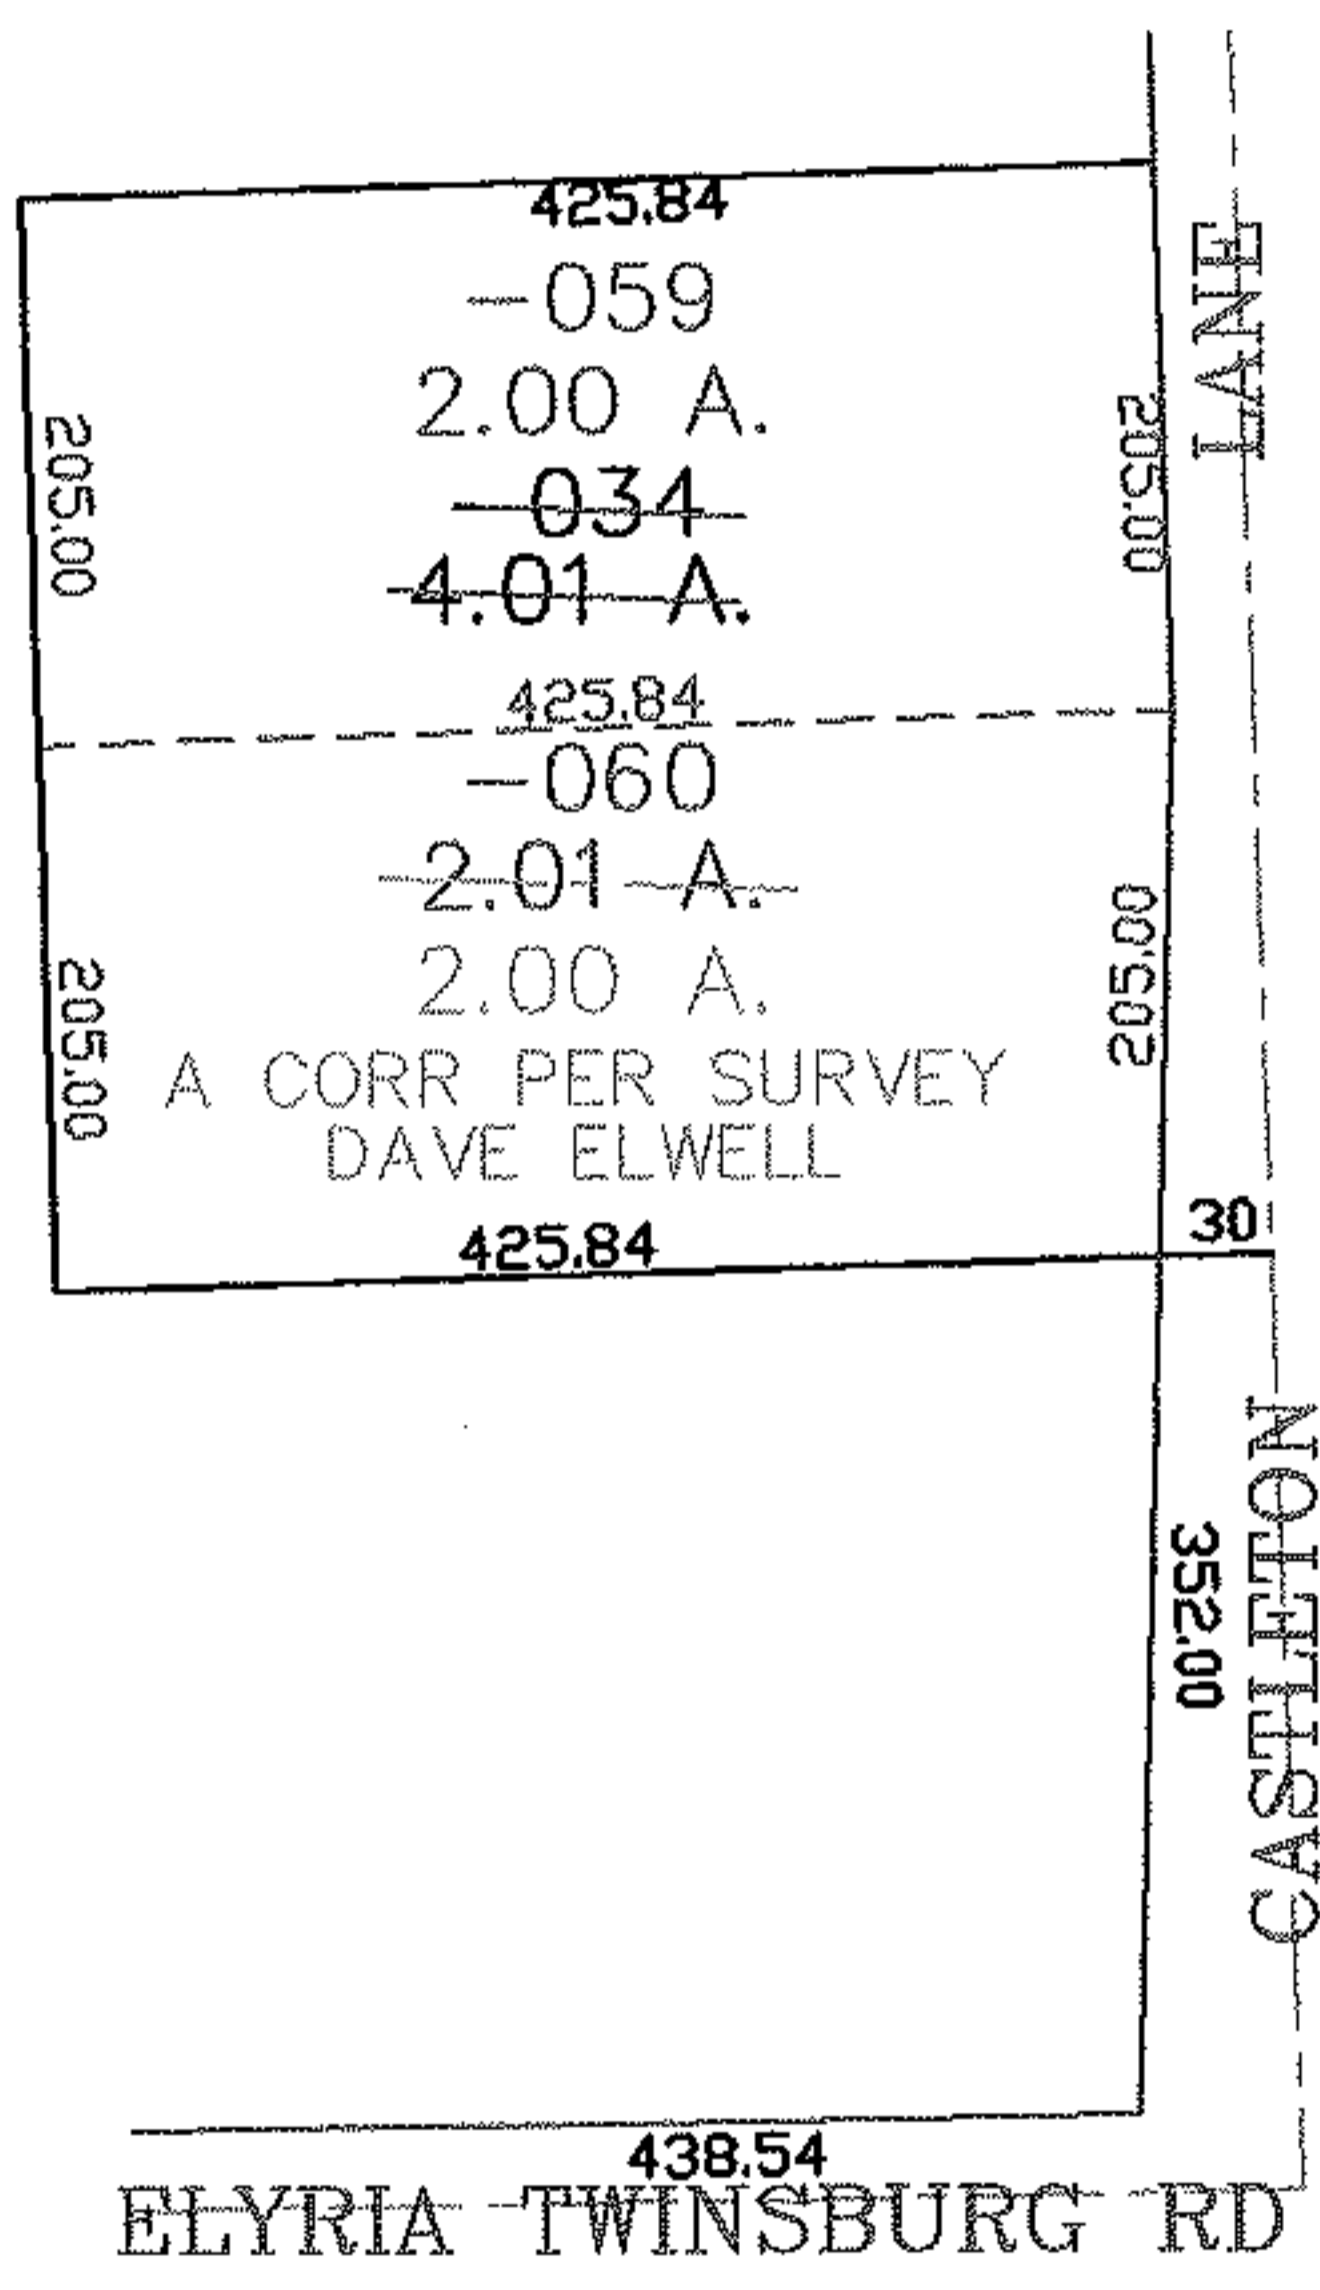


PARENT PARCEL: 11-00-086-000-034

CHILD PARCEL: 11-00-086-000-059, -060

STARTING POINT: CENTERLINE OF ELYRIA TWINSBURG RD & CASTLETON RD

06-02290

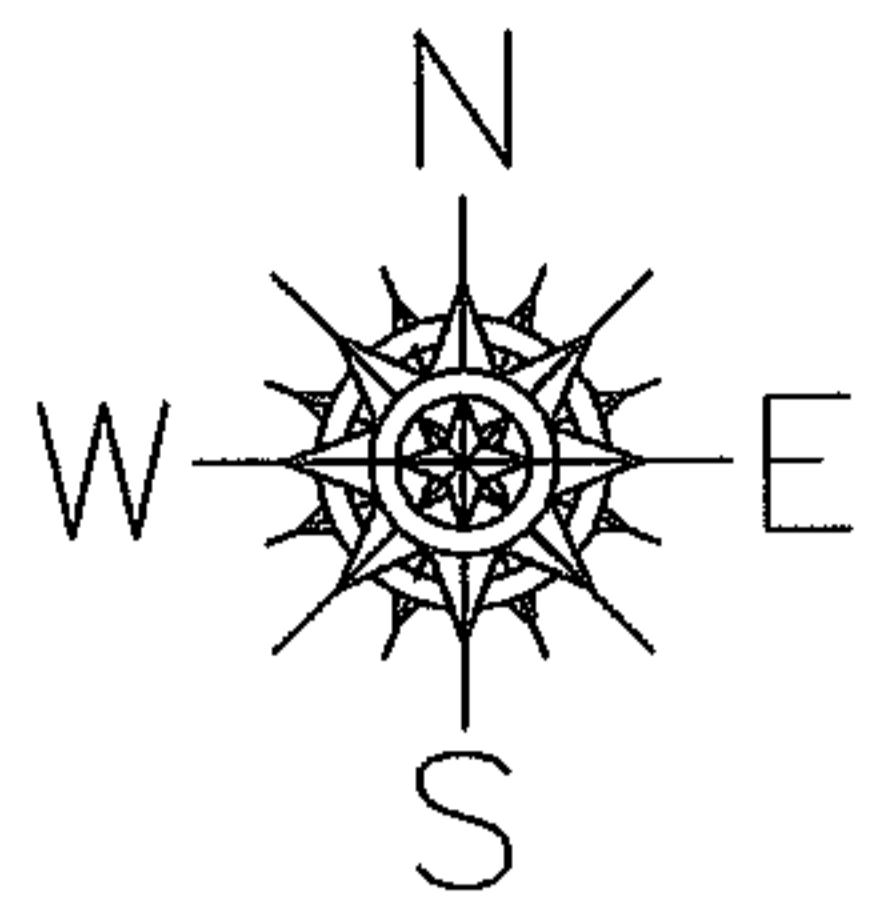

**SPLITS/DEEDS PROCESSED**  
**LORAIN COUNTY TAX MAP DEPARTMENT**  
 226 MIDDLE AVE. ELYRIA, OHIO

SURVEYED BY: DAVE ELWELL  
 CLOSURE: 0.00 : 10.000  
 MAP PAGE(S): 11-00-086-A  
 APPROVED BY: JAH DATE: 12-18-06  
 SCALE: 1" = 200 PRIOR INSTRUMENT: 20060150132