




RASTER

PARENT PARCEL: 07-00-015-110-046  
CHILD PARCEL:  
STARTING POINT: C/L OF ROOT RD. AT THE SOUTHWEST CORNER OF LAND CONVEYED TO  
GEORGE IVO FENN (DV 273/374)

11-02291-D

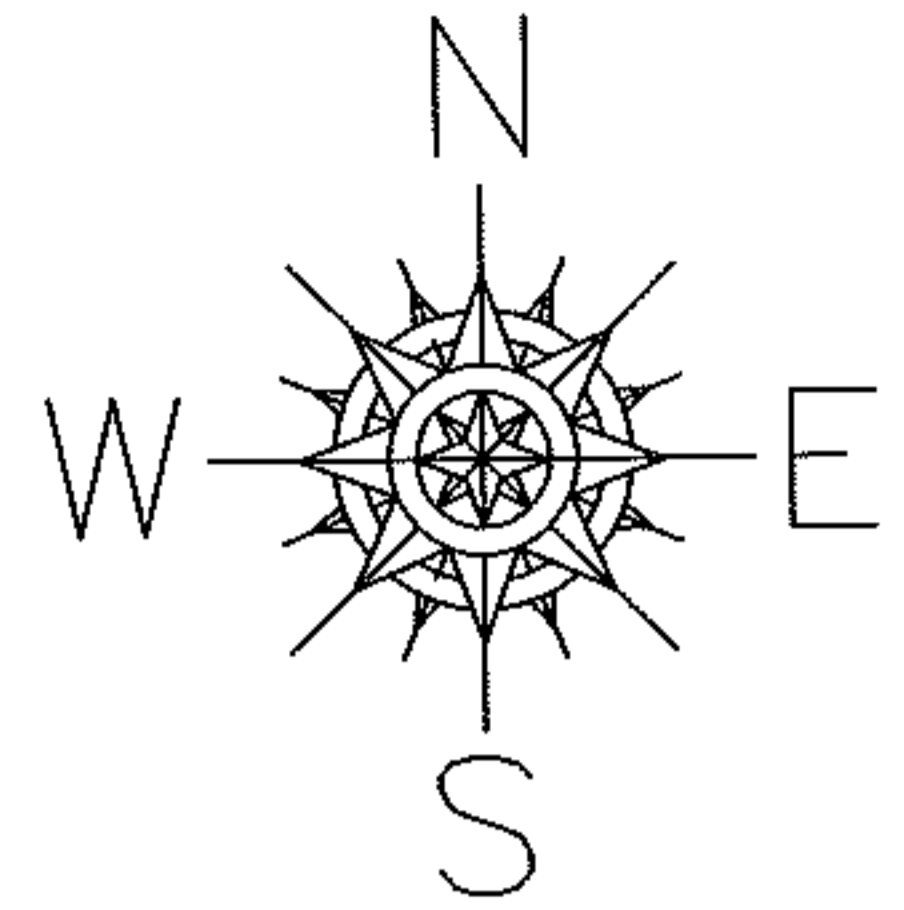

OHIO TURNPIKE

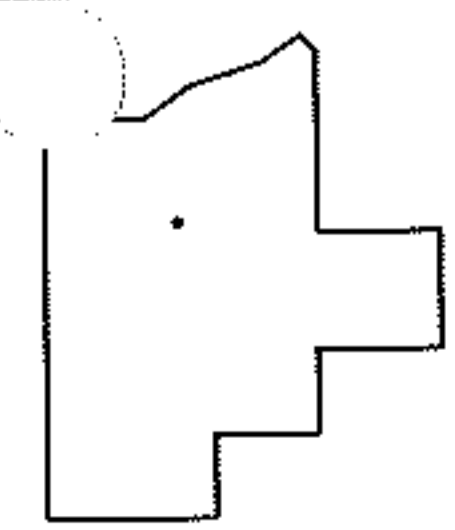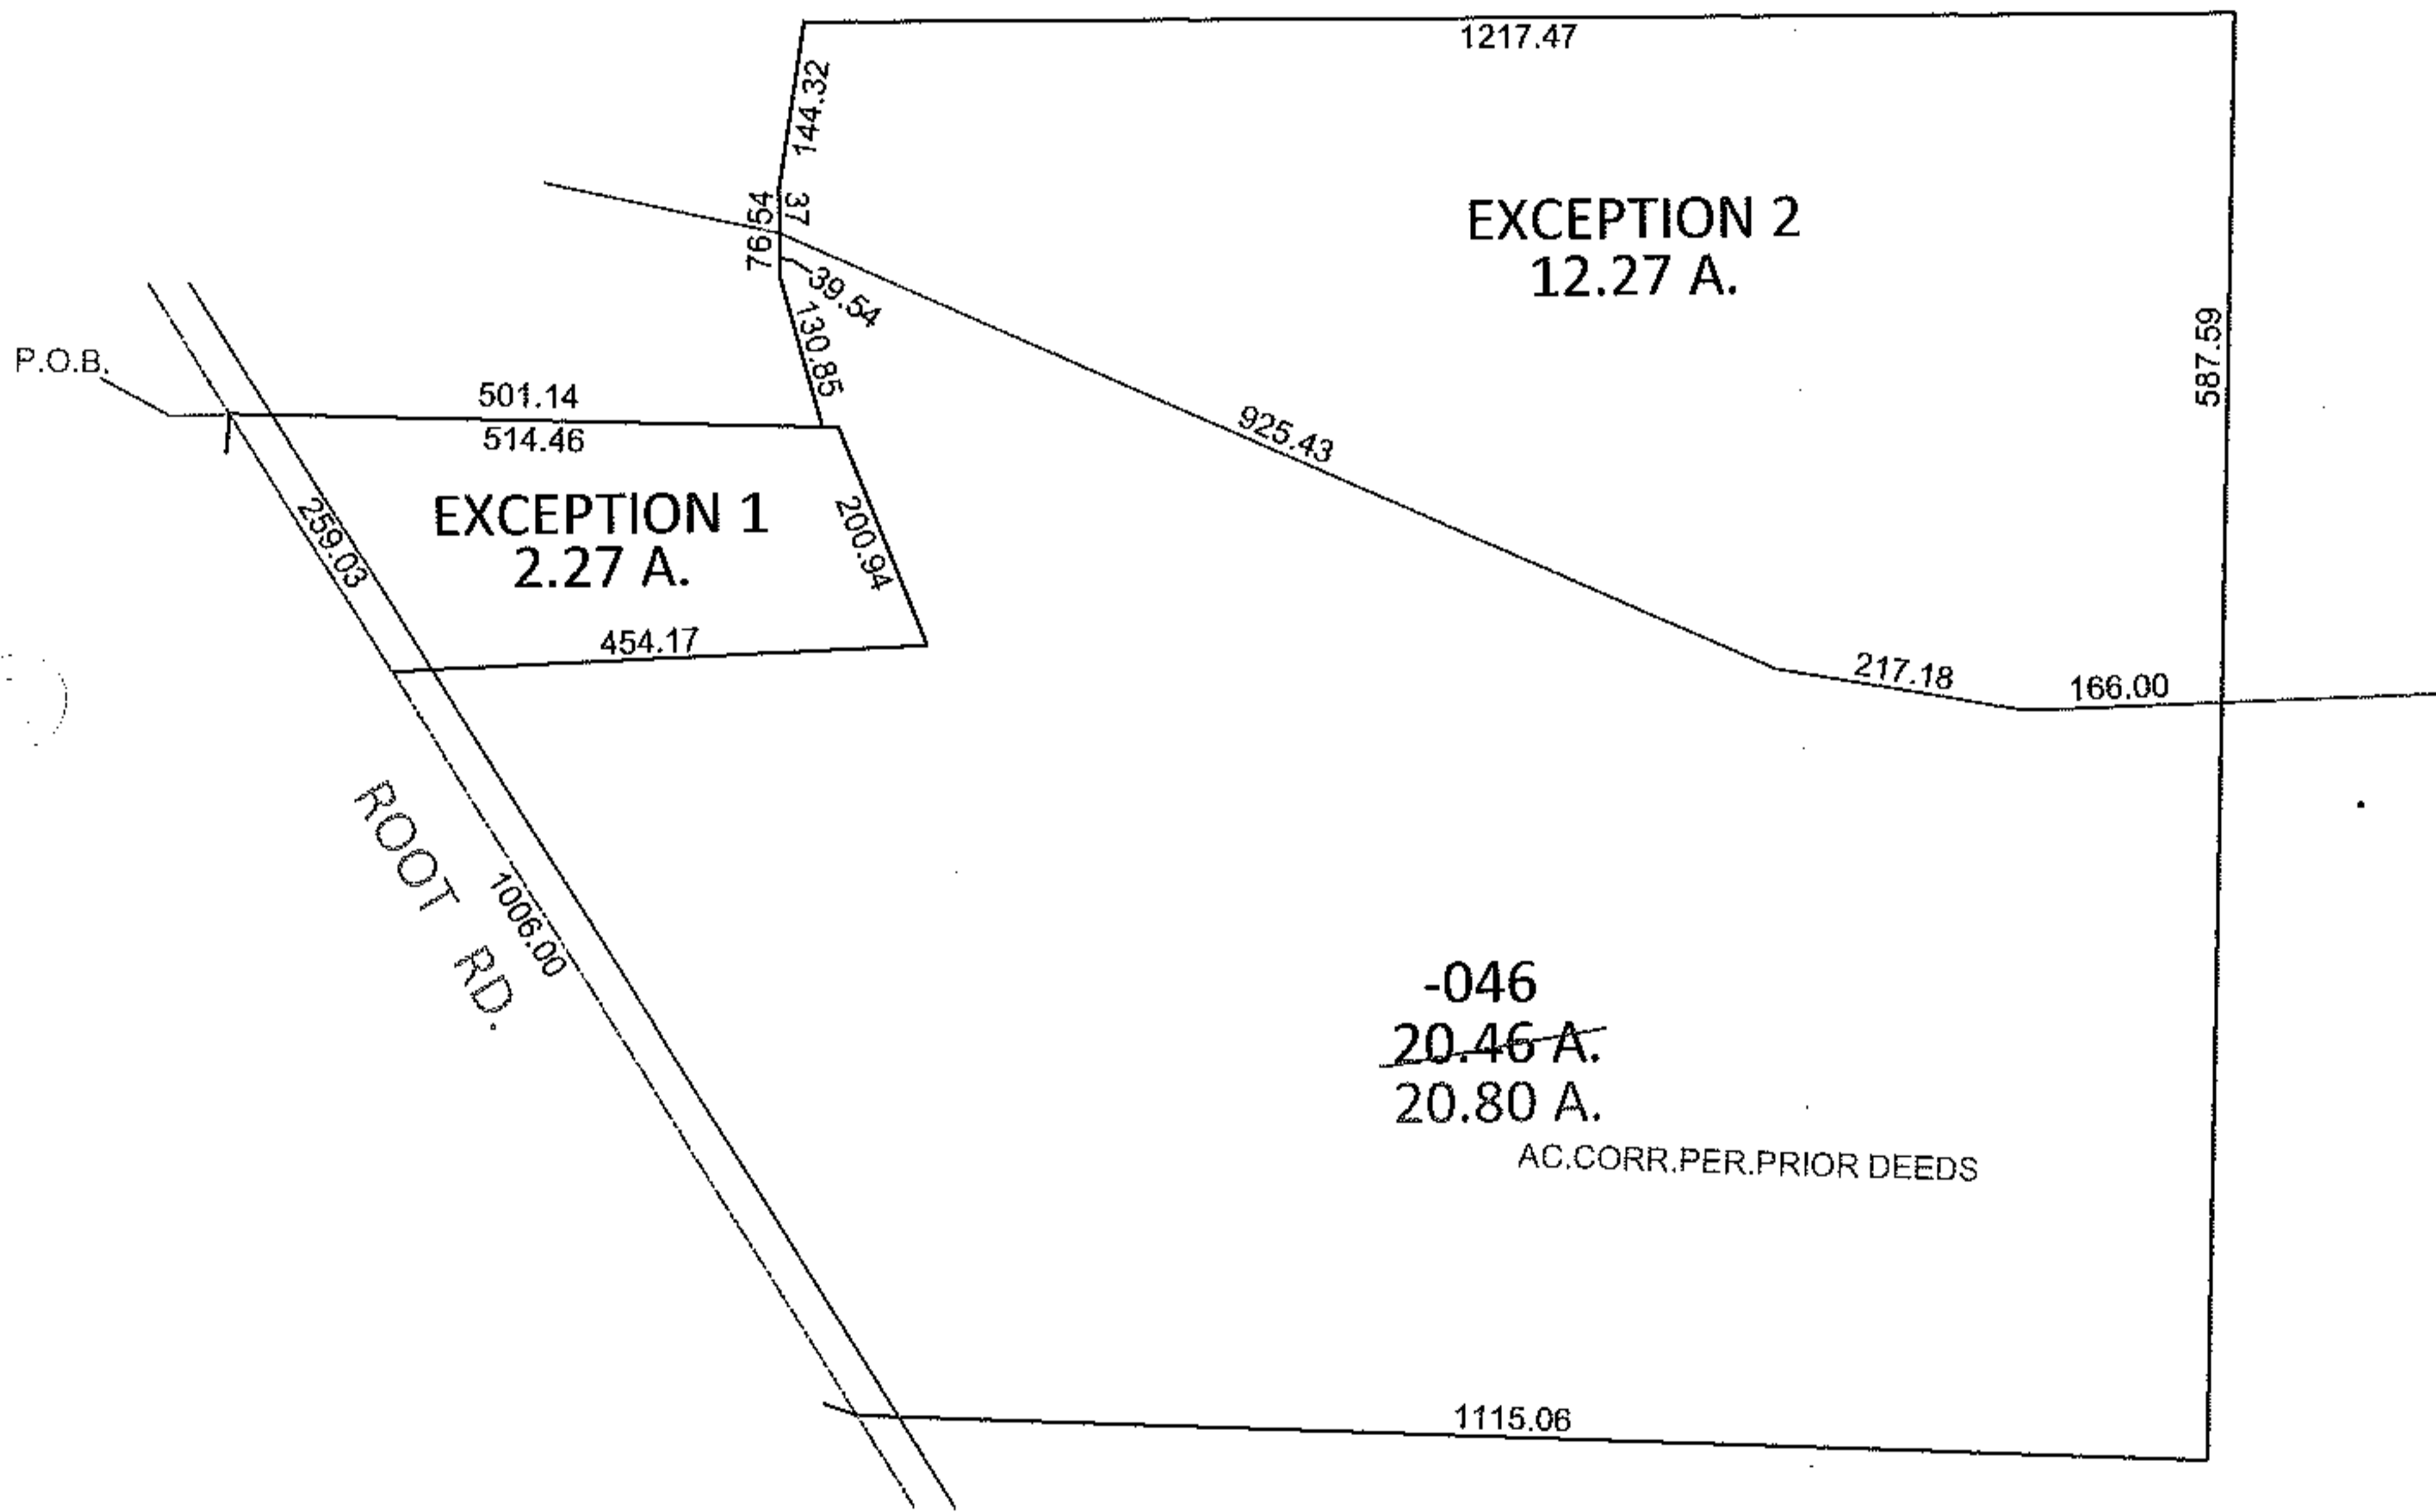

SPLITS/DEEDS PROCESSED

LORAIN COUNTY TAX MAP DEPARTMENT  
226 MIDDLE AVE. ELYRIA, OHIO

SURVEYED BY: N/A  
CLOSURE: .03:10,000  
MAP PAGE(S): 7-00-015-C  
APPROVED BY: RRM DATE: 5-9-11  
SCALE: 1"= 300 PRIOR INST.: DV 1248/156