




R A STER

PARENT PARCEL: 03-00-005-000-053, 03-00-006-000-212

CHILD PARCEL: 03-00-005-000-063, -064 03-00-006-000-216, -217

STARTING POINT: CENTERLINE OF ABBE RD & EVERGREEN PKWY

06-02291

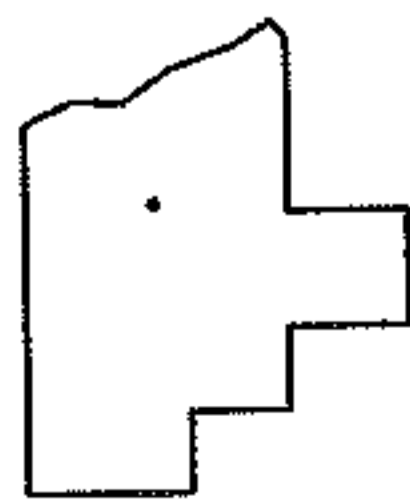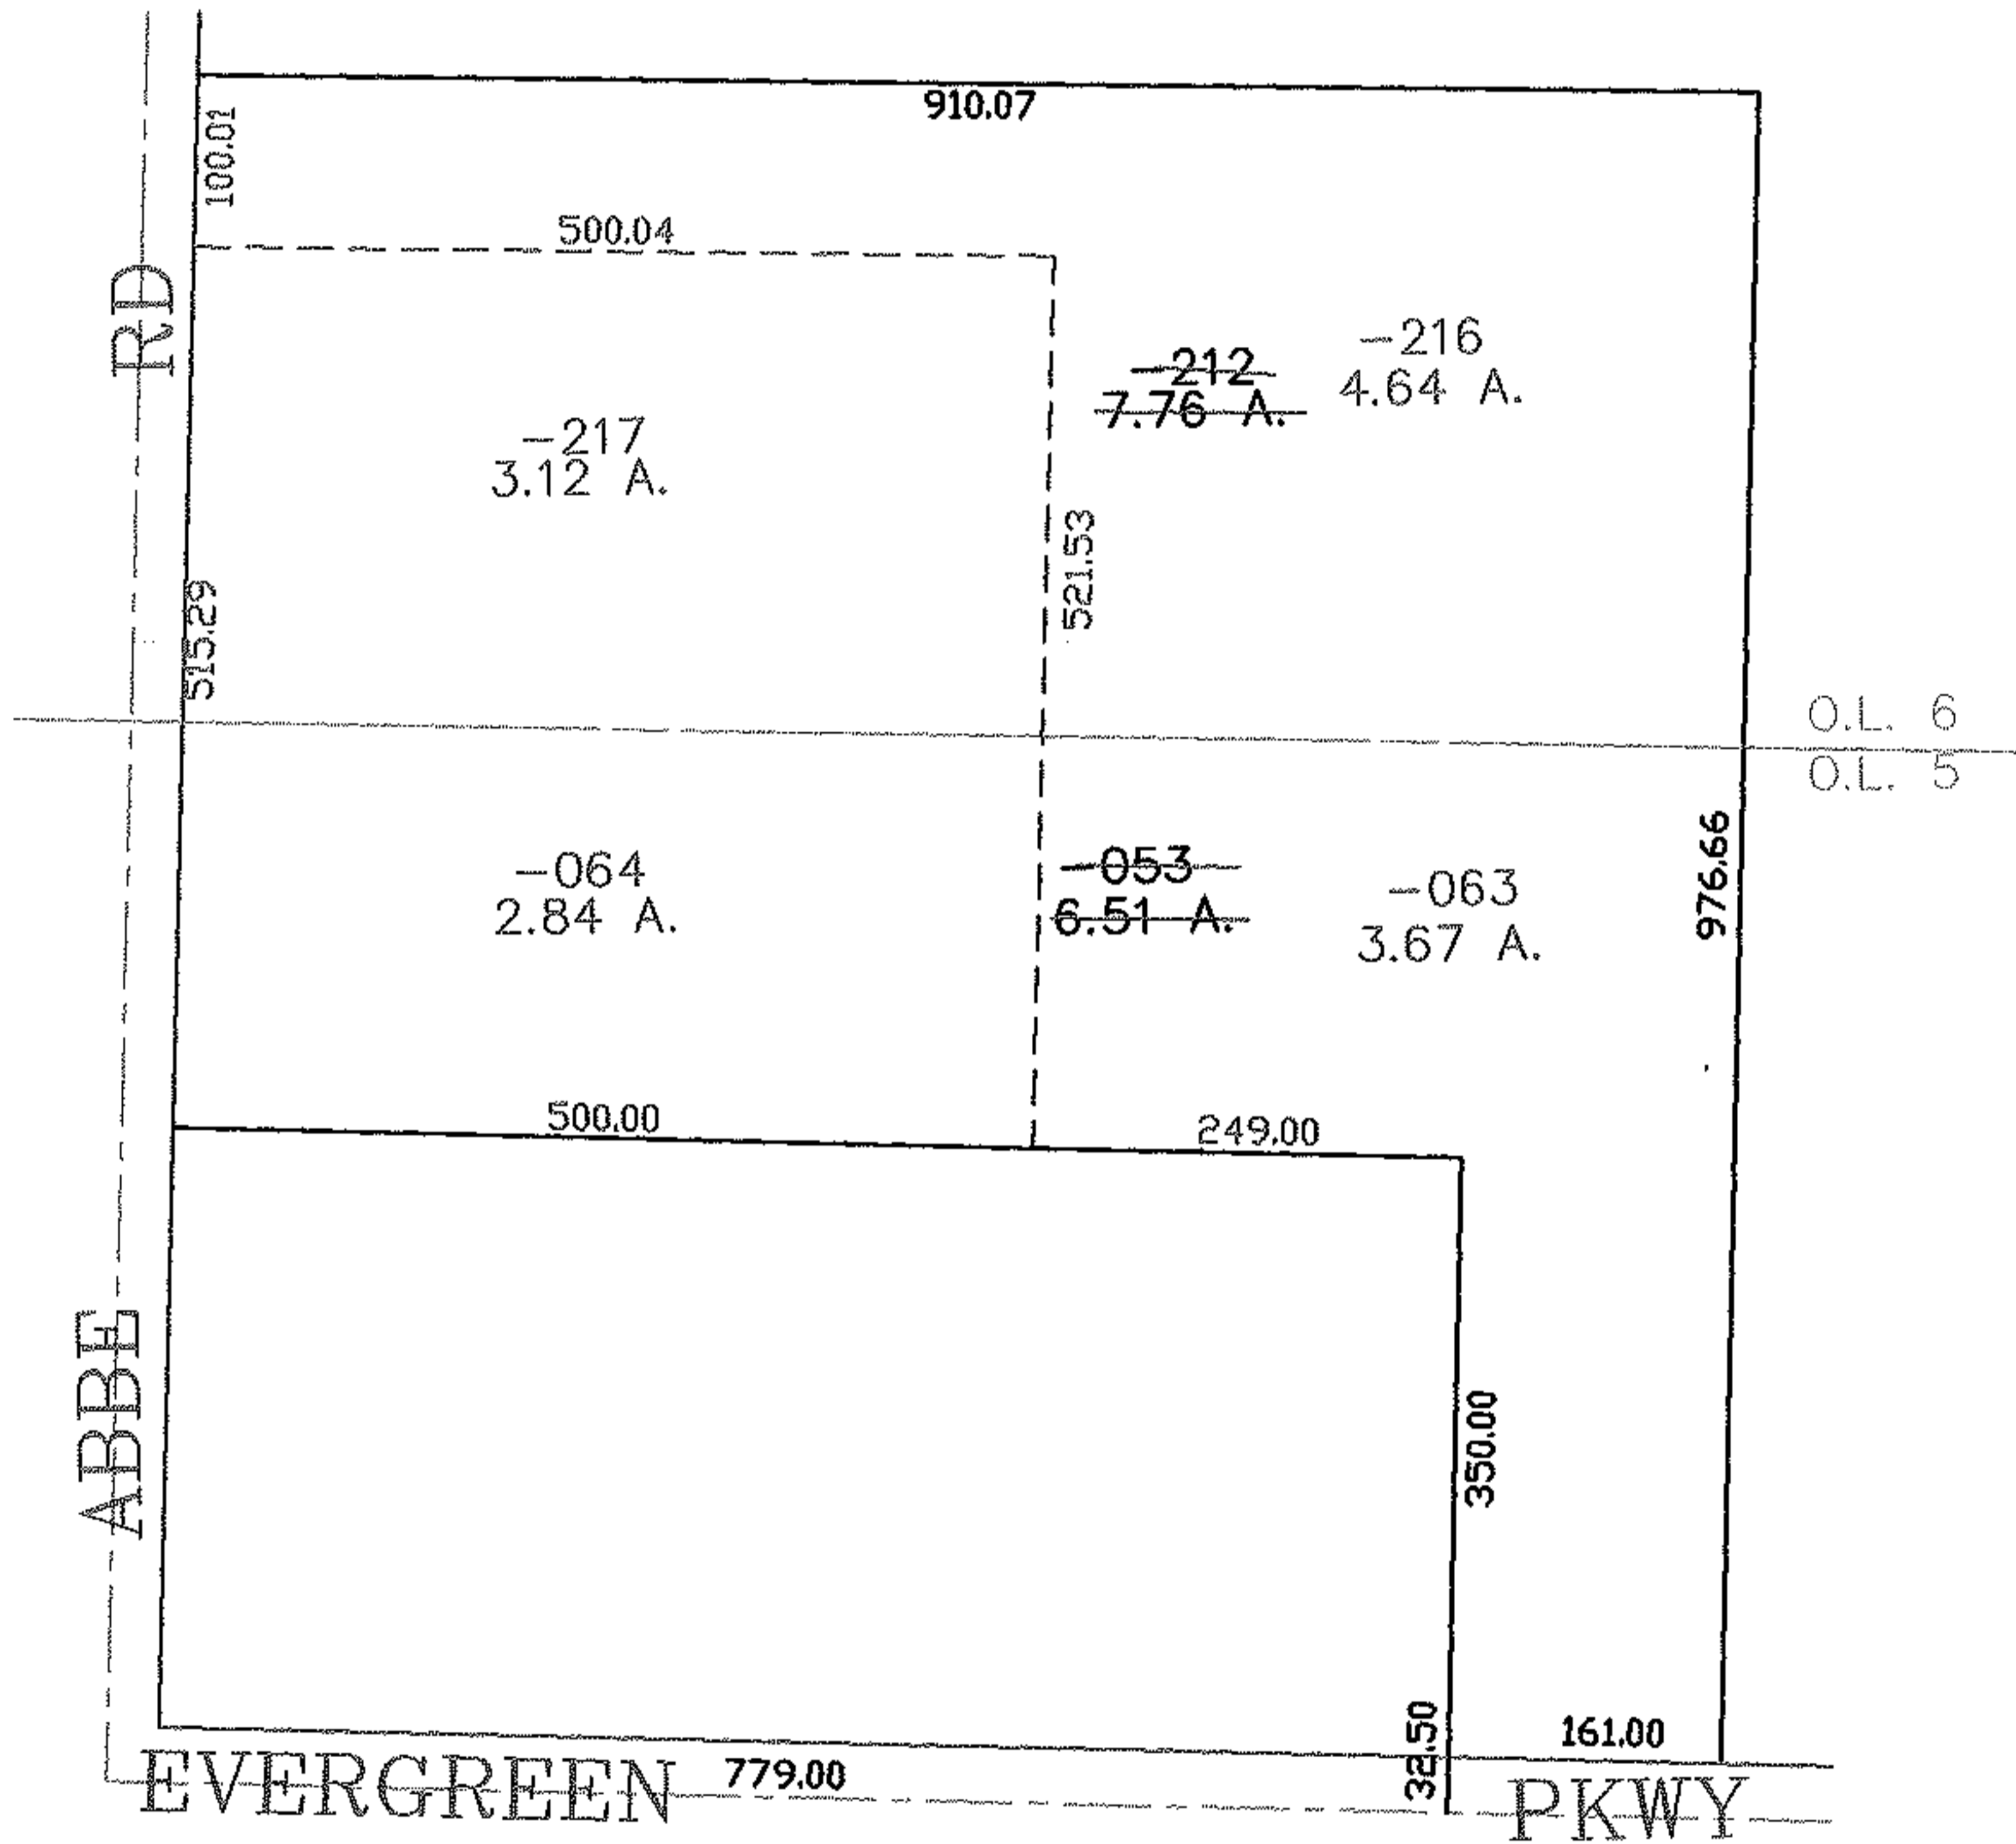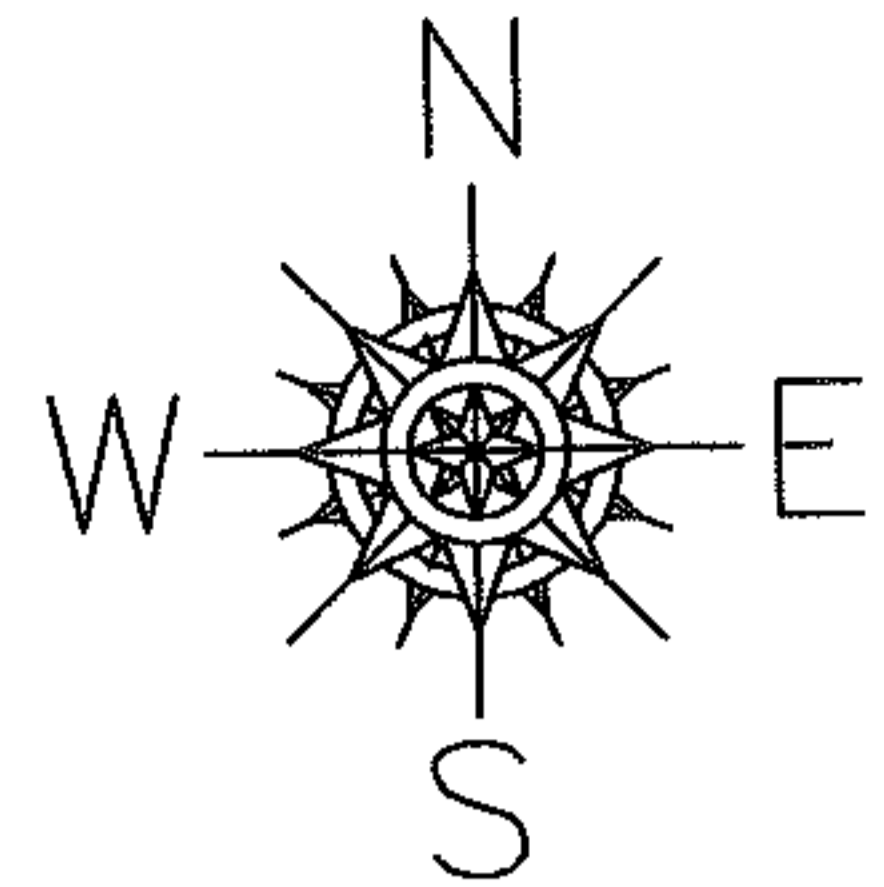

SPLITS/DEEDS PROCESSED
LORAIN COUNTY TAX MAP DEPARTMENT
 226 MIDDLE AVE. ELYRIA, OHIO

SURVEYED BY: THOMAS NEFF
 CLOSURE: 0.00 : 10.000
 MAP PAGE(S): 03-00-006-A 03-00-005-A
 APPROVED BY: JAH DATE: 12-18-06
 SCALE: 1" = 200' PRIOR INSTRUMENT: 19970508056