



RASTER

PARENT PARCEL: 02-02-012-103-003  
CHILD PARCEL: 02-02-012-103-038, -039  
STARTING POINT: PART OF S/L'S 54-55 IN KNEIRIM DR. HOMES ALLOT (VOL. 14 PG. 26)

11-02294-U

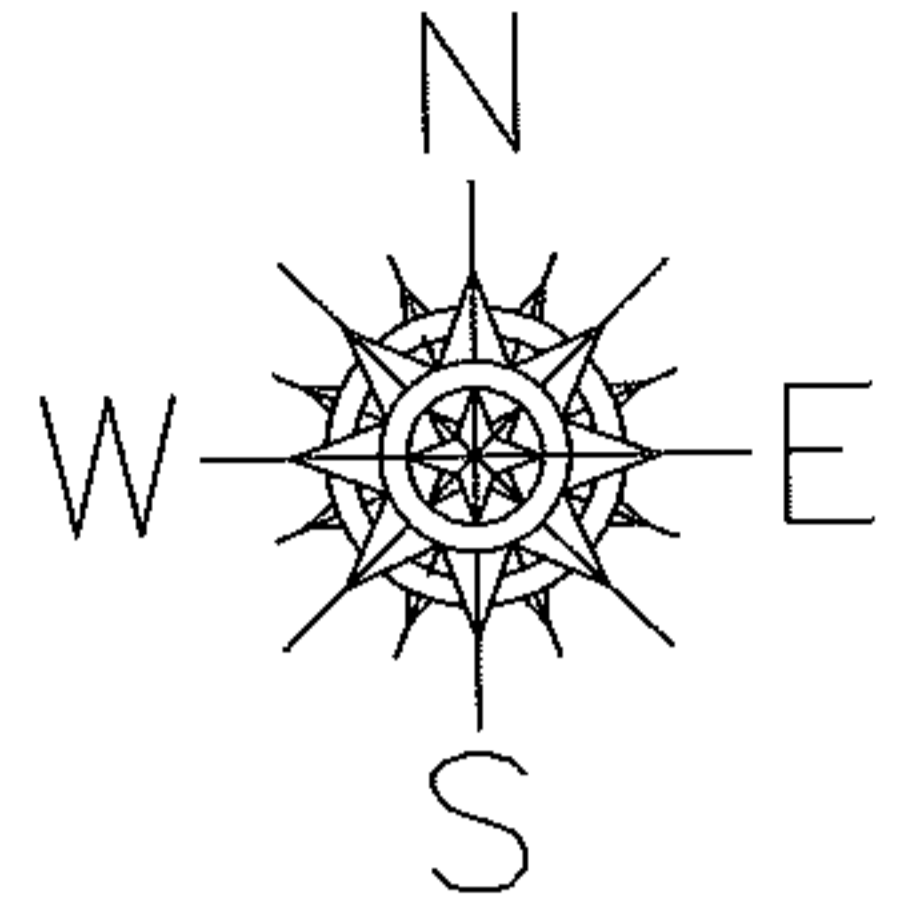

REINWALD RD.

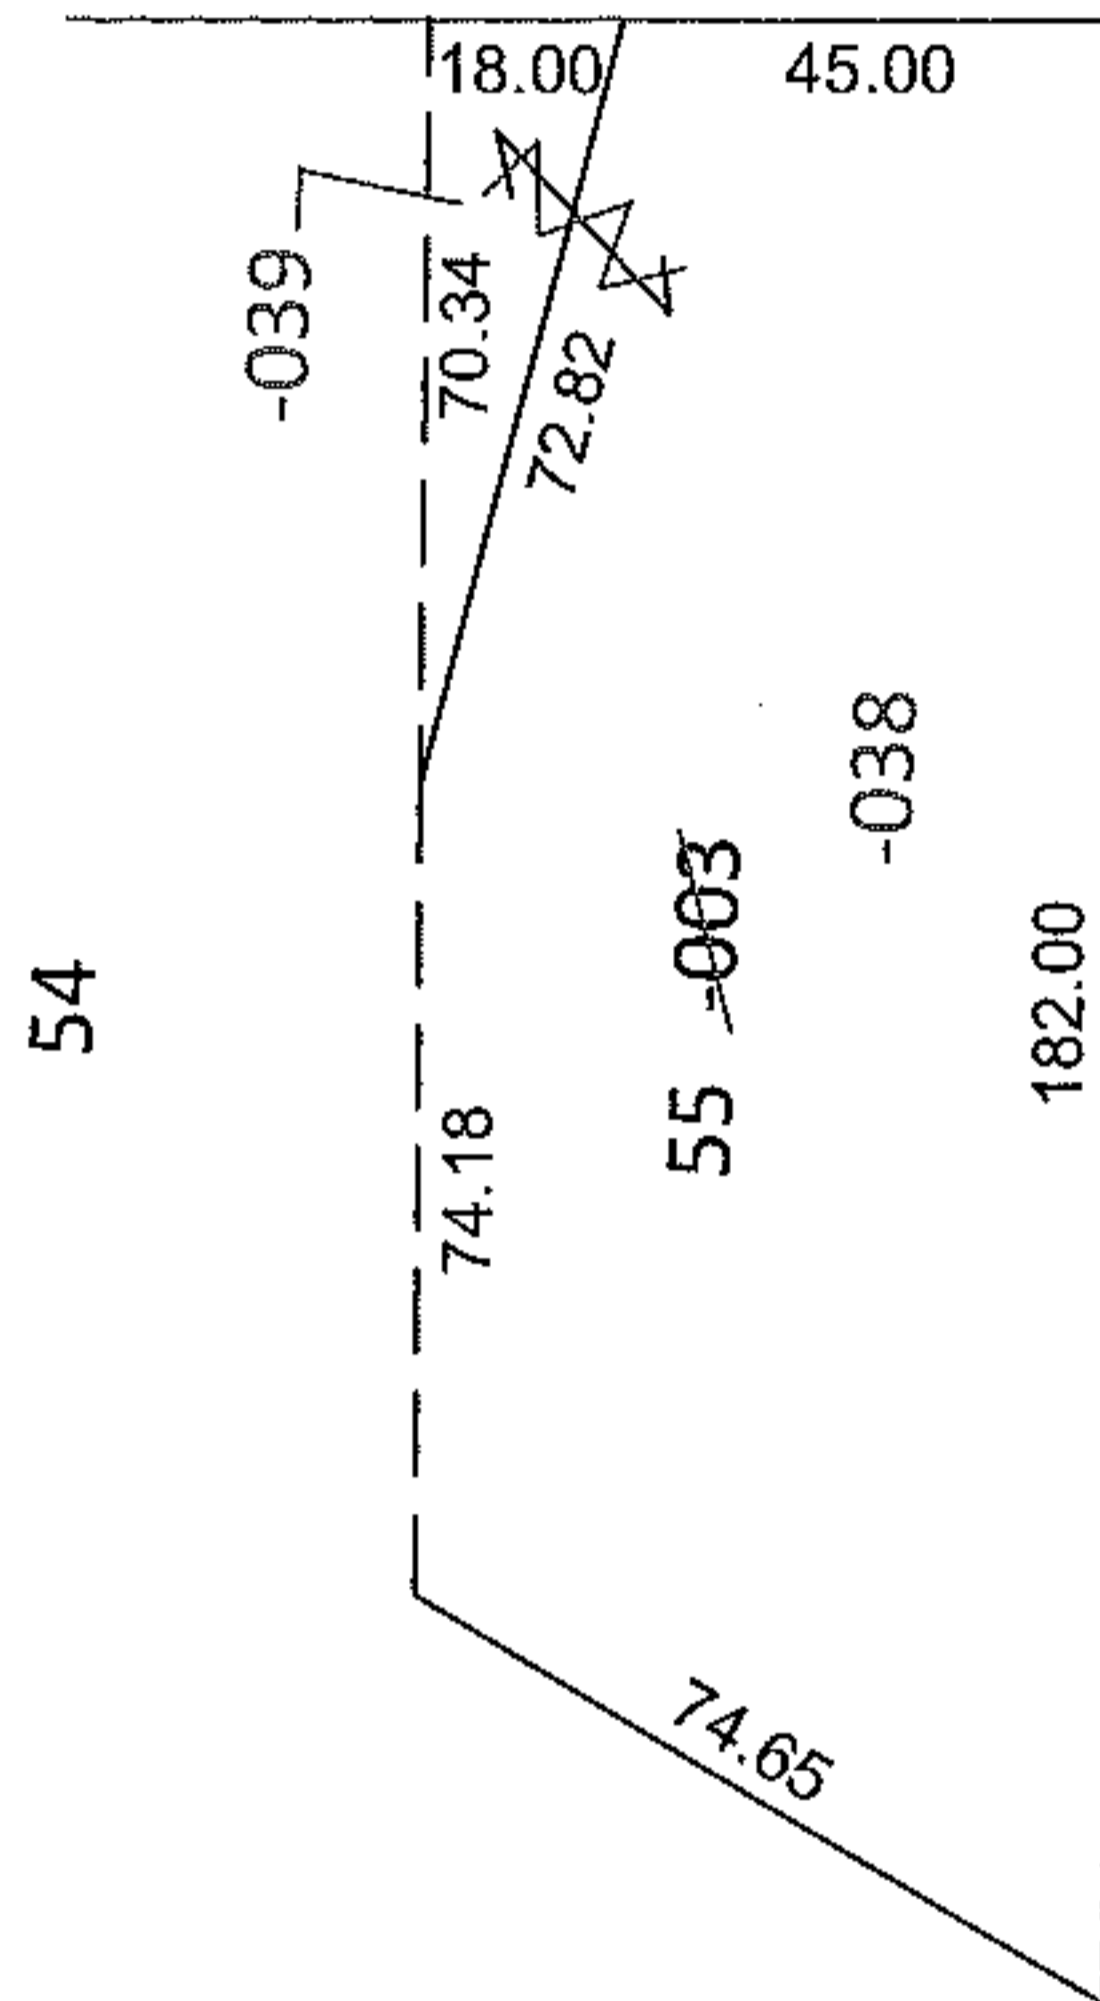

UNCOMBINATION

PER DEEDS

~~02-02-012-103-003~~

~~63 X 182~~

02-02-012-103-038  
45 X 182

02-02-012-103-039  
18 X 72.82 IRR

SPLITS/DEEDS PROCESSED

LORAIN COUNTY TAX MAP DEPARTMENT  
226 MIDDLE AVE. ELYRIA, OHIO

SURVEYED BY: N/A  
CLOSURE: .01:10,000  
MAP PAGE(S): 2-02-012-B  
APPROVED BY: RRM DATE: 5-6-11  
SCALE: 1"= 50' PRIOR INST.: 20100355526