



RASTER

PARENT PARCEL: 12-00-062-000-015

CHILD PARCEL: _____


STARTING POINT: INTERSECTION OF NORTH LINE OF ANTHONY & FRANCES DEMBOSKE
(DV 286/412) AND WESTERLY SIDE OF JAQUAY RD.

11-02296-C

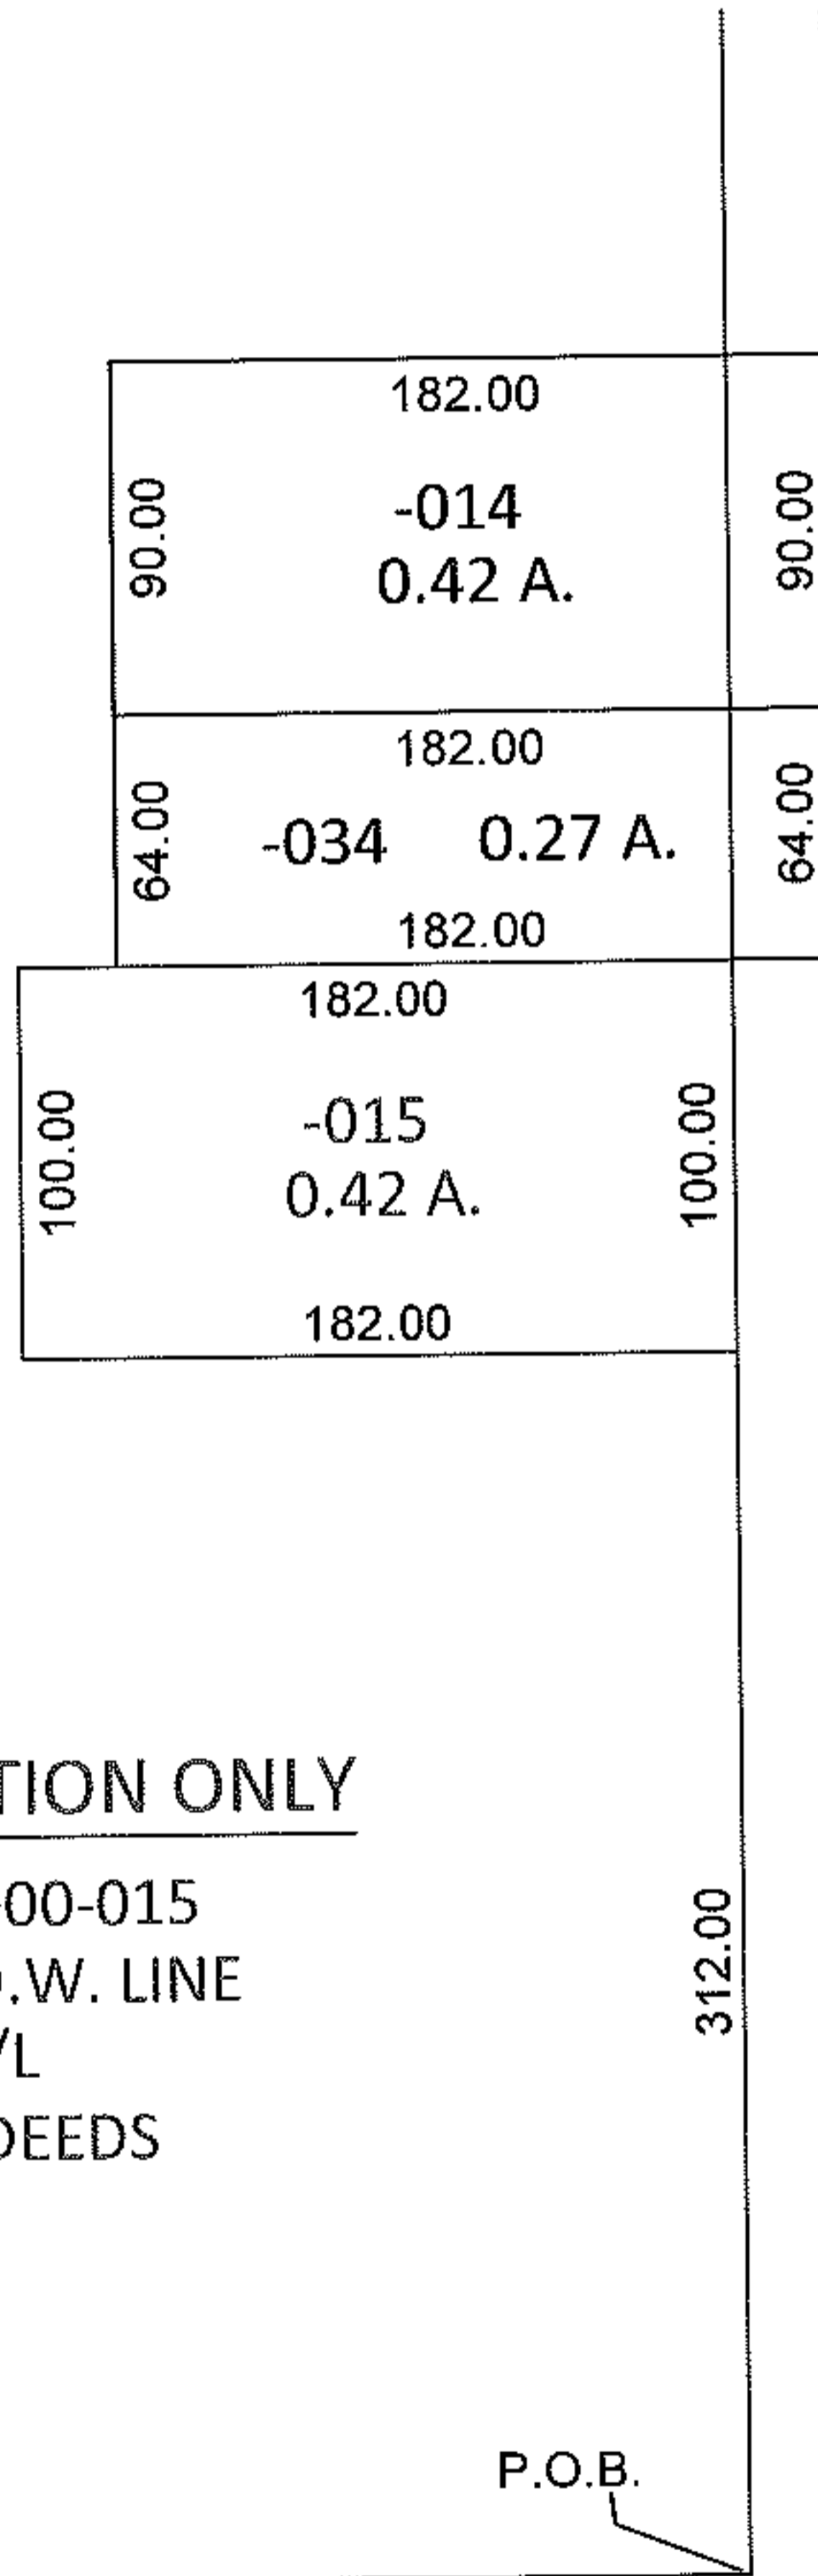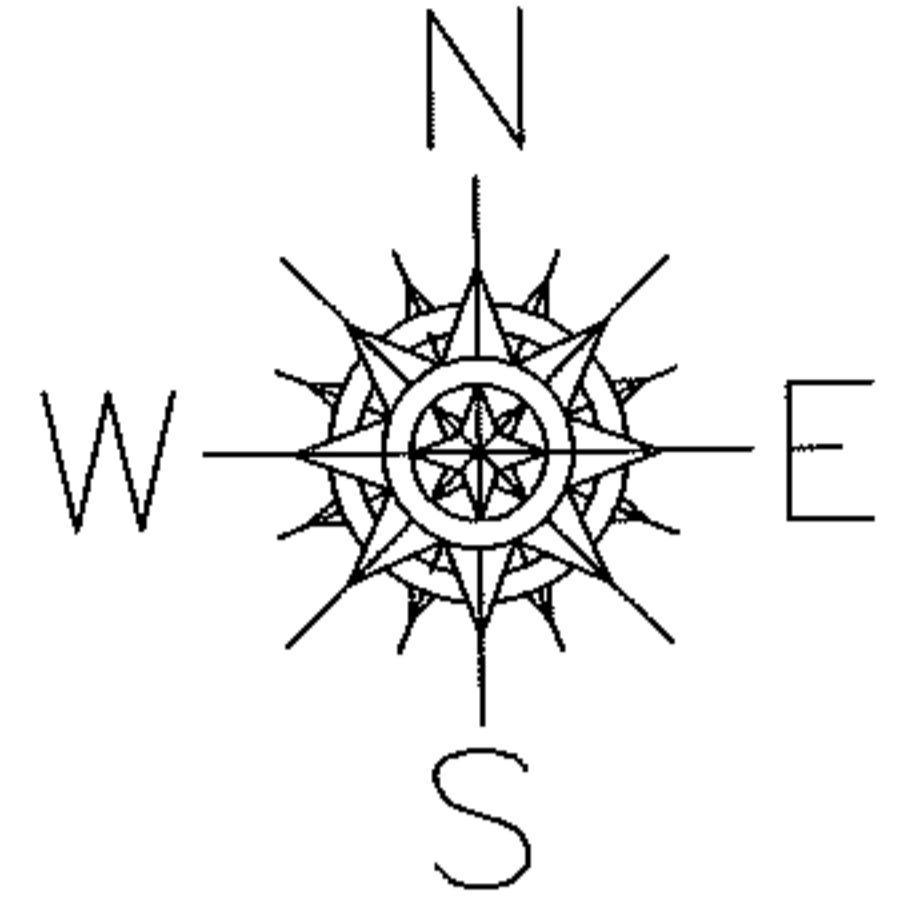

MAP CORRECTION ONLY

12-00-062-000-015
READS TO R.O.W. LINE
NOT C/L
PER PRIOR DEEDS

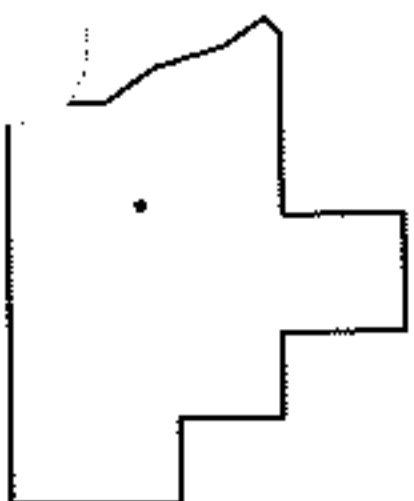

SPLITS/DEEDS PROCESSED

LORAIN COUNTY TAX MAP DEPARTMENT
226 MIDDLE AVE. ELYRIA, OHIO

SURVEYED BY: N/A

CLOSURE: N/A

MAP PAGE(S): 12-00-062-B

APPROVED BY: RRM DATE: 5-10-11

SCALE: 1"= 100 PRIOR INST.: DV 922/249