



RASTER

PARENT PARCEL: 06-25-023-103-024

11-02297-C

CHILD PARCEL: \_\_\_\_\_

STARTING POINT: S/L 1 IN BLOCK 66 OF CITY FARMS ALLOT (VOL.9 PG.3)

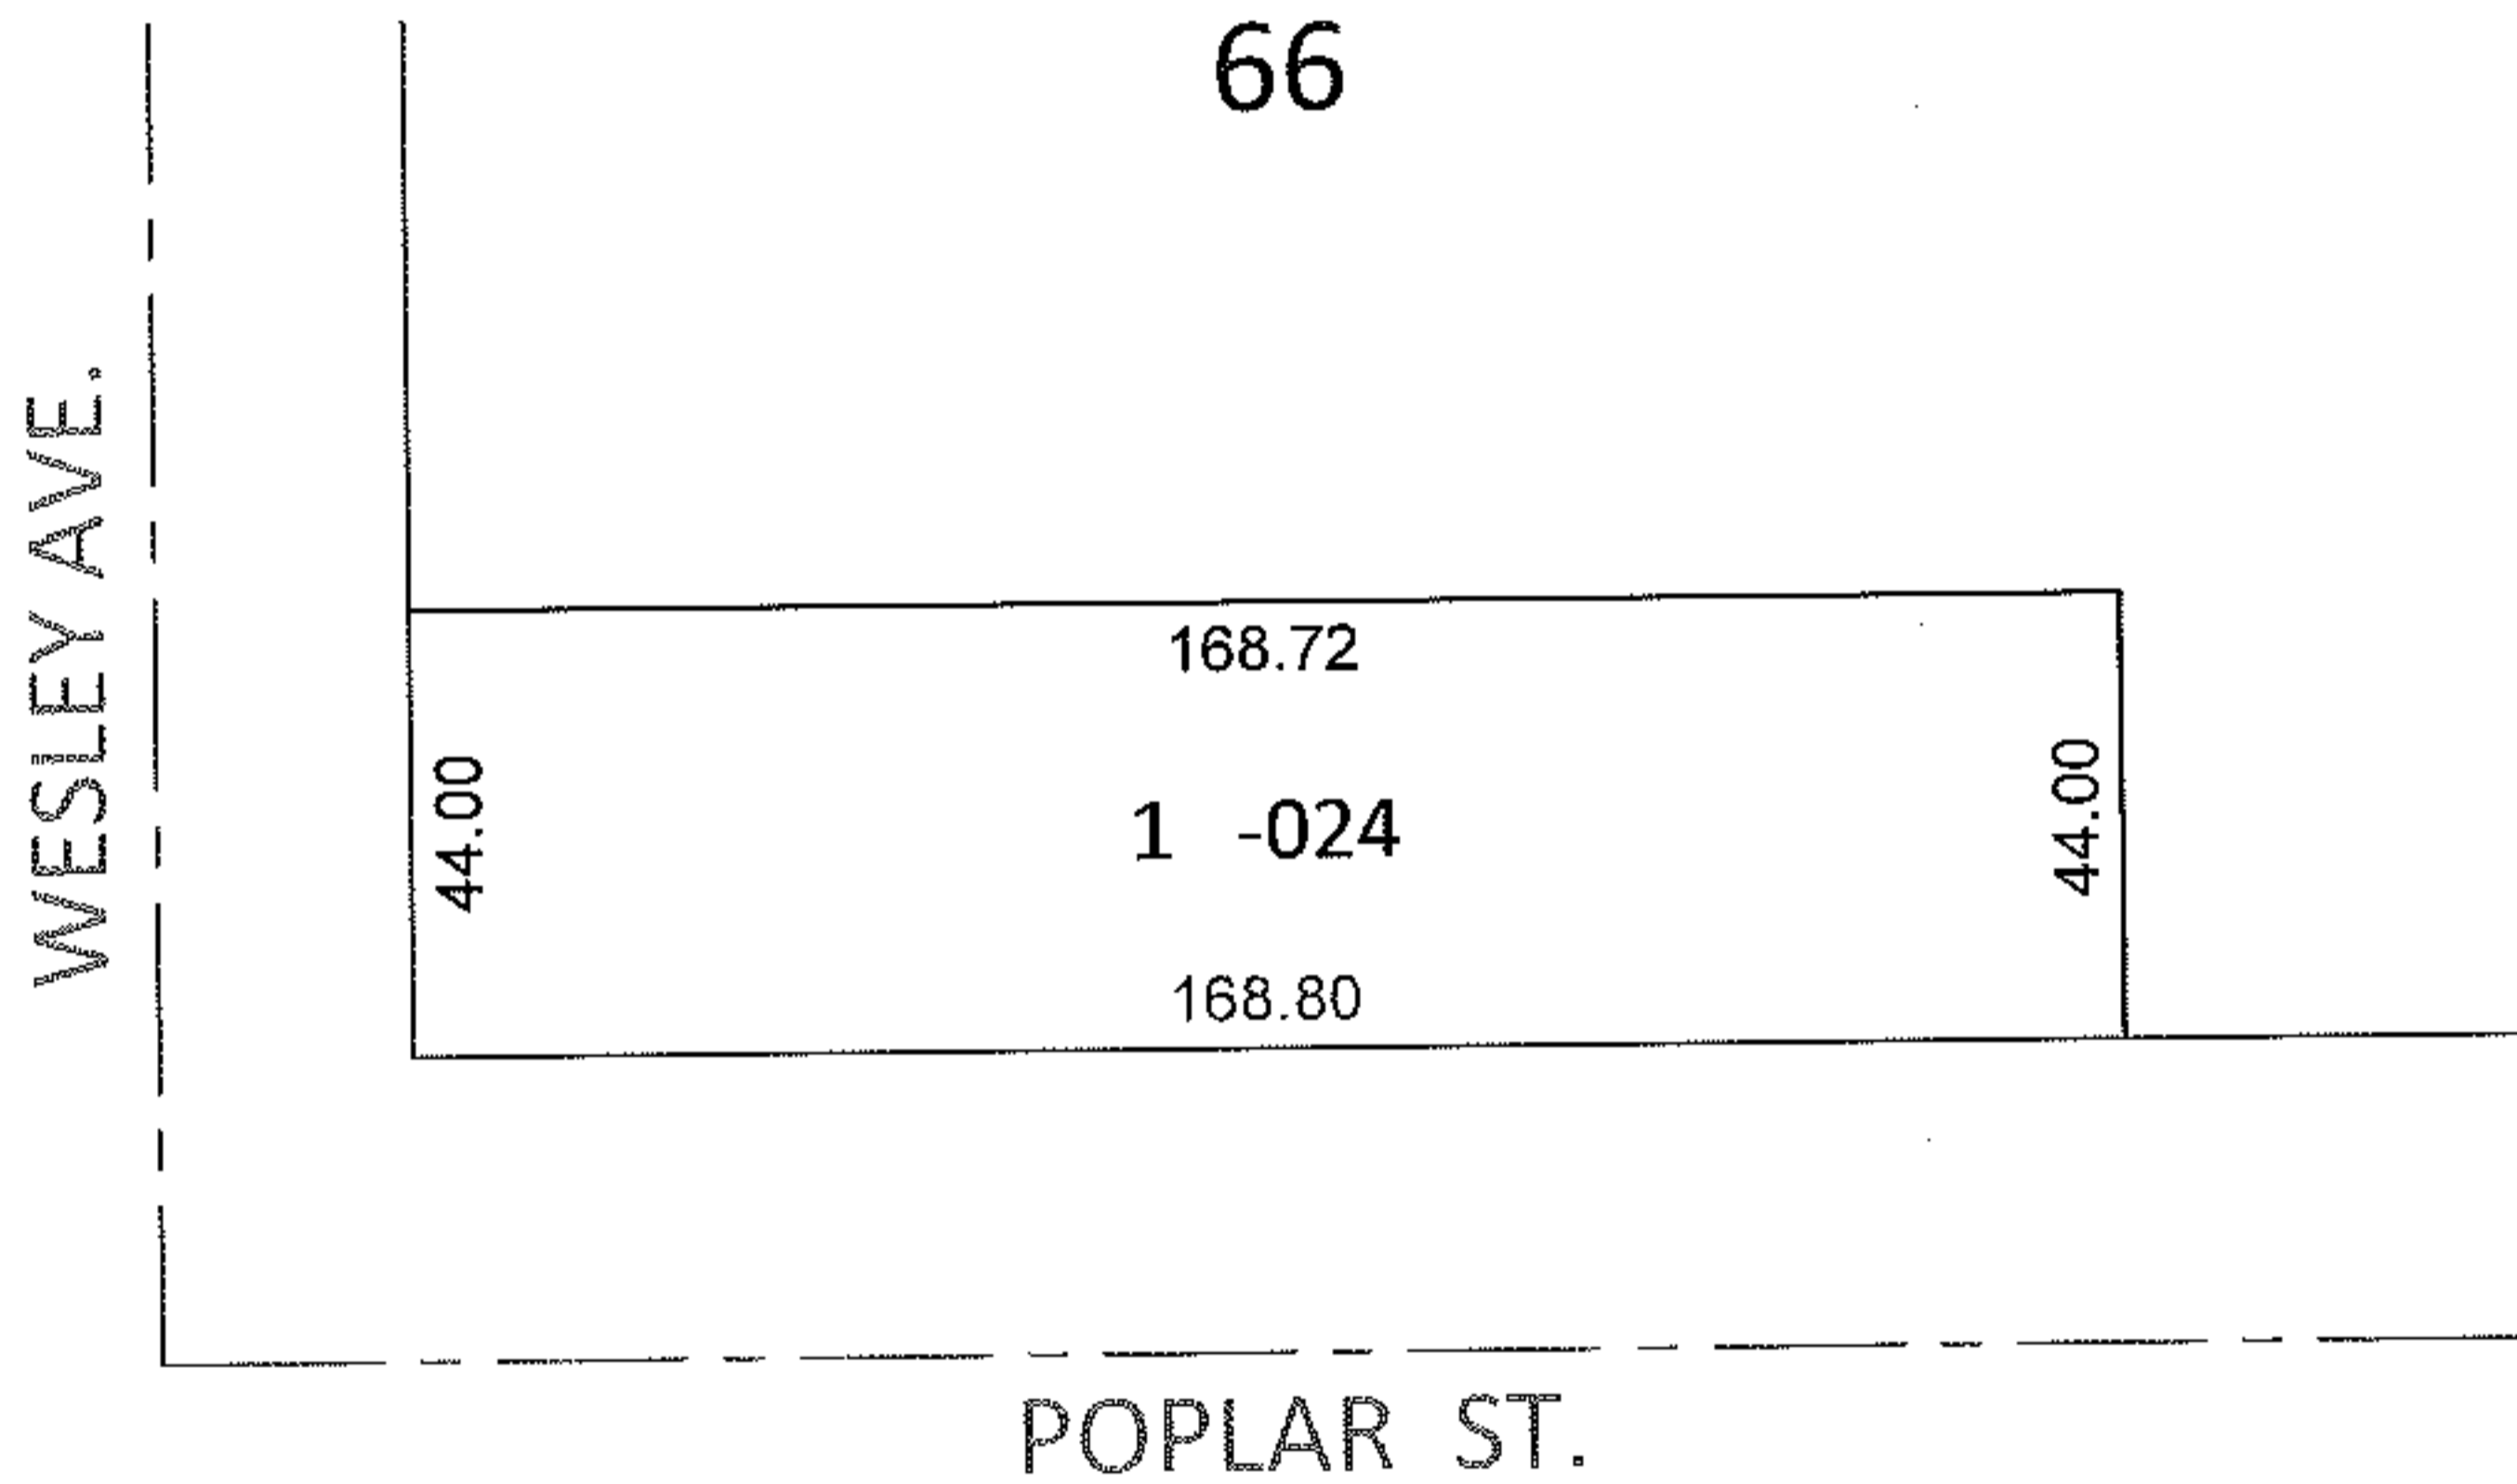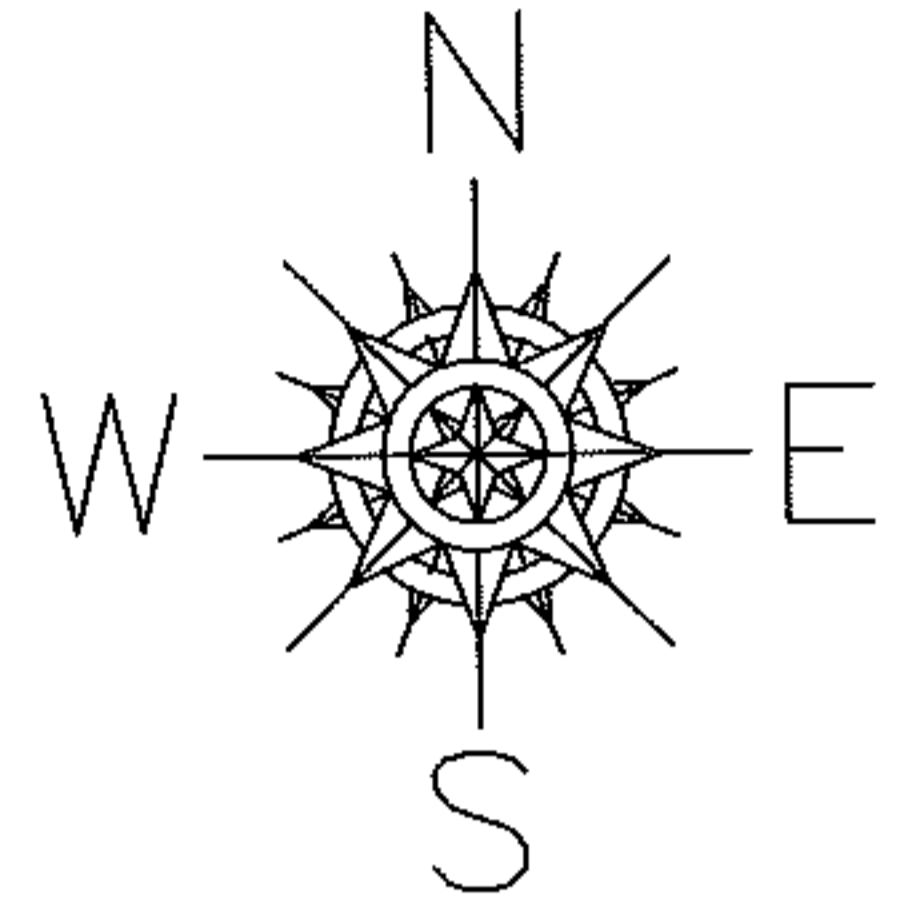


DEPTH CORRECTION

06-25-023-103-024

168.80  
44 X ~~169~~

PER PRIOR DEEDS

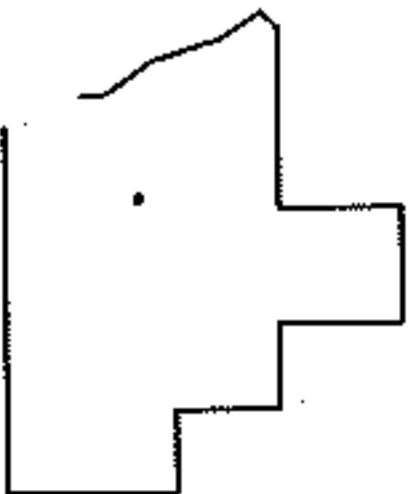

SPLITS/DEEDS PROCESSED

LORAIN COUNTY TAX MAP DEPARTMENT  
226 MIDDLE AVE. ELYRIA, OHIO

SURVEYED BY: N/A

CLOSURE: N/A

MAP PAGE(S): 6-89

APPROVED BY: RRM DATE: 5-24-11

SCALE: 1"= 50' PRIOR INST.: 20100341978