
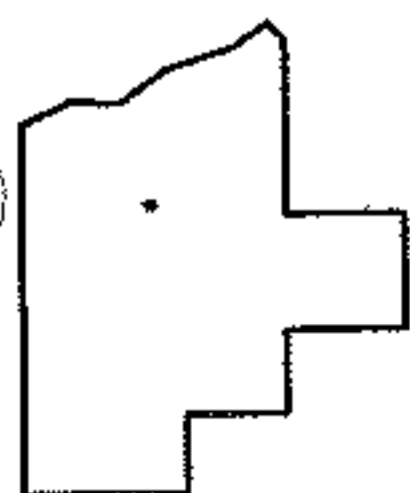
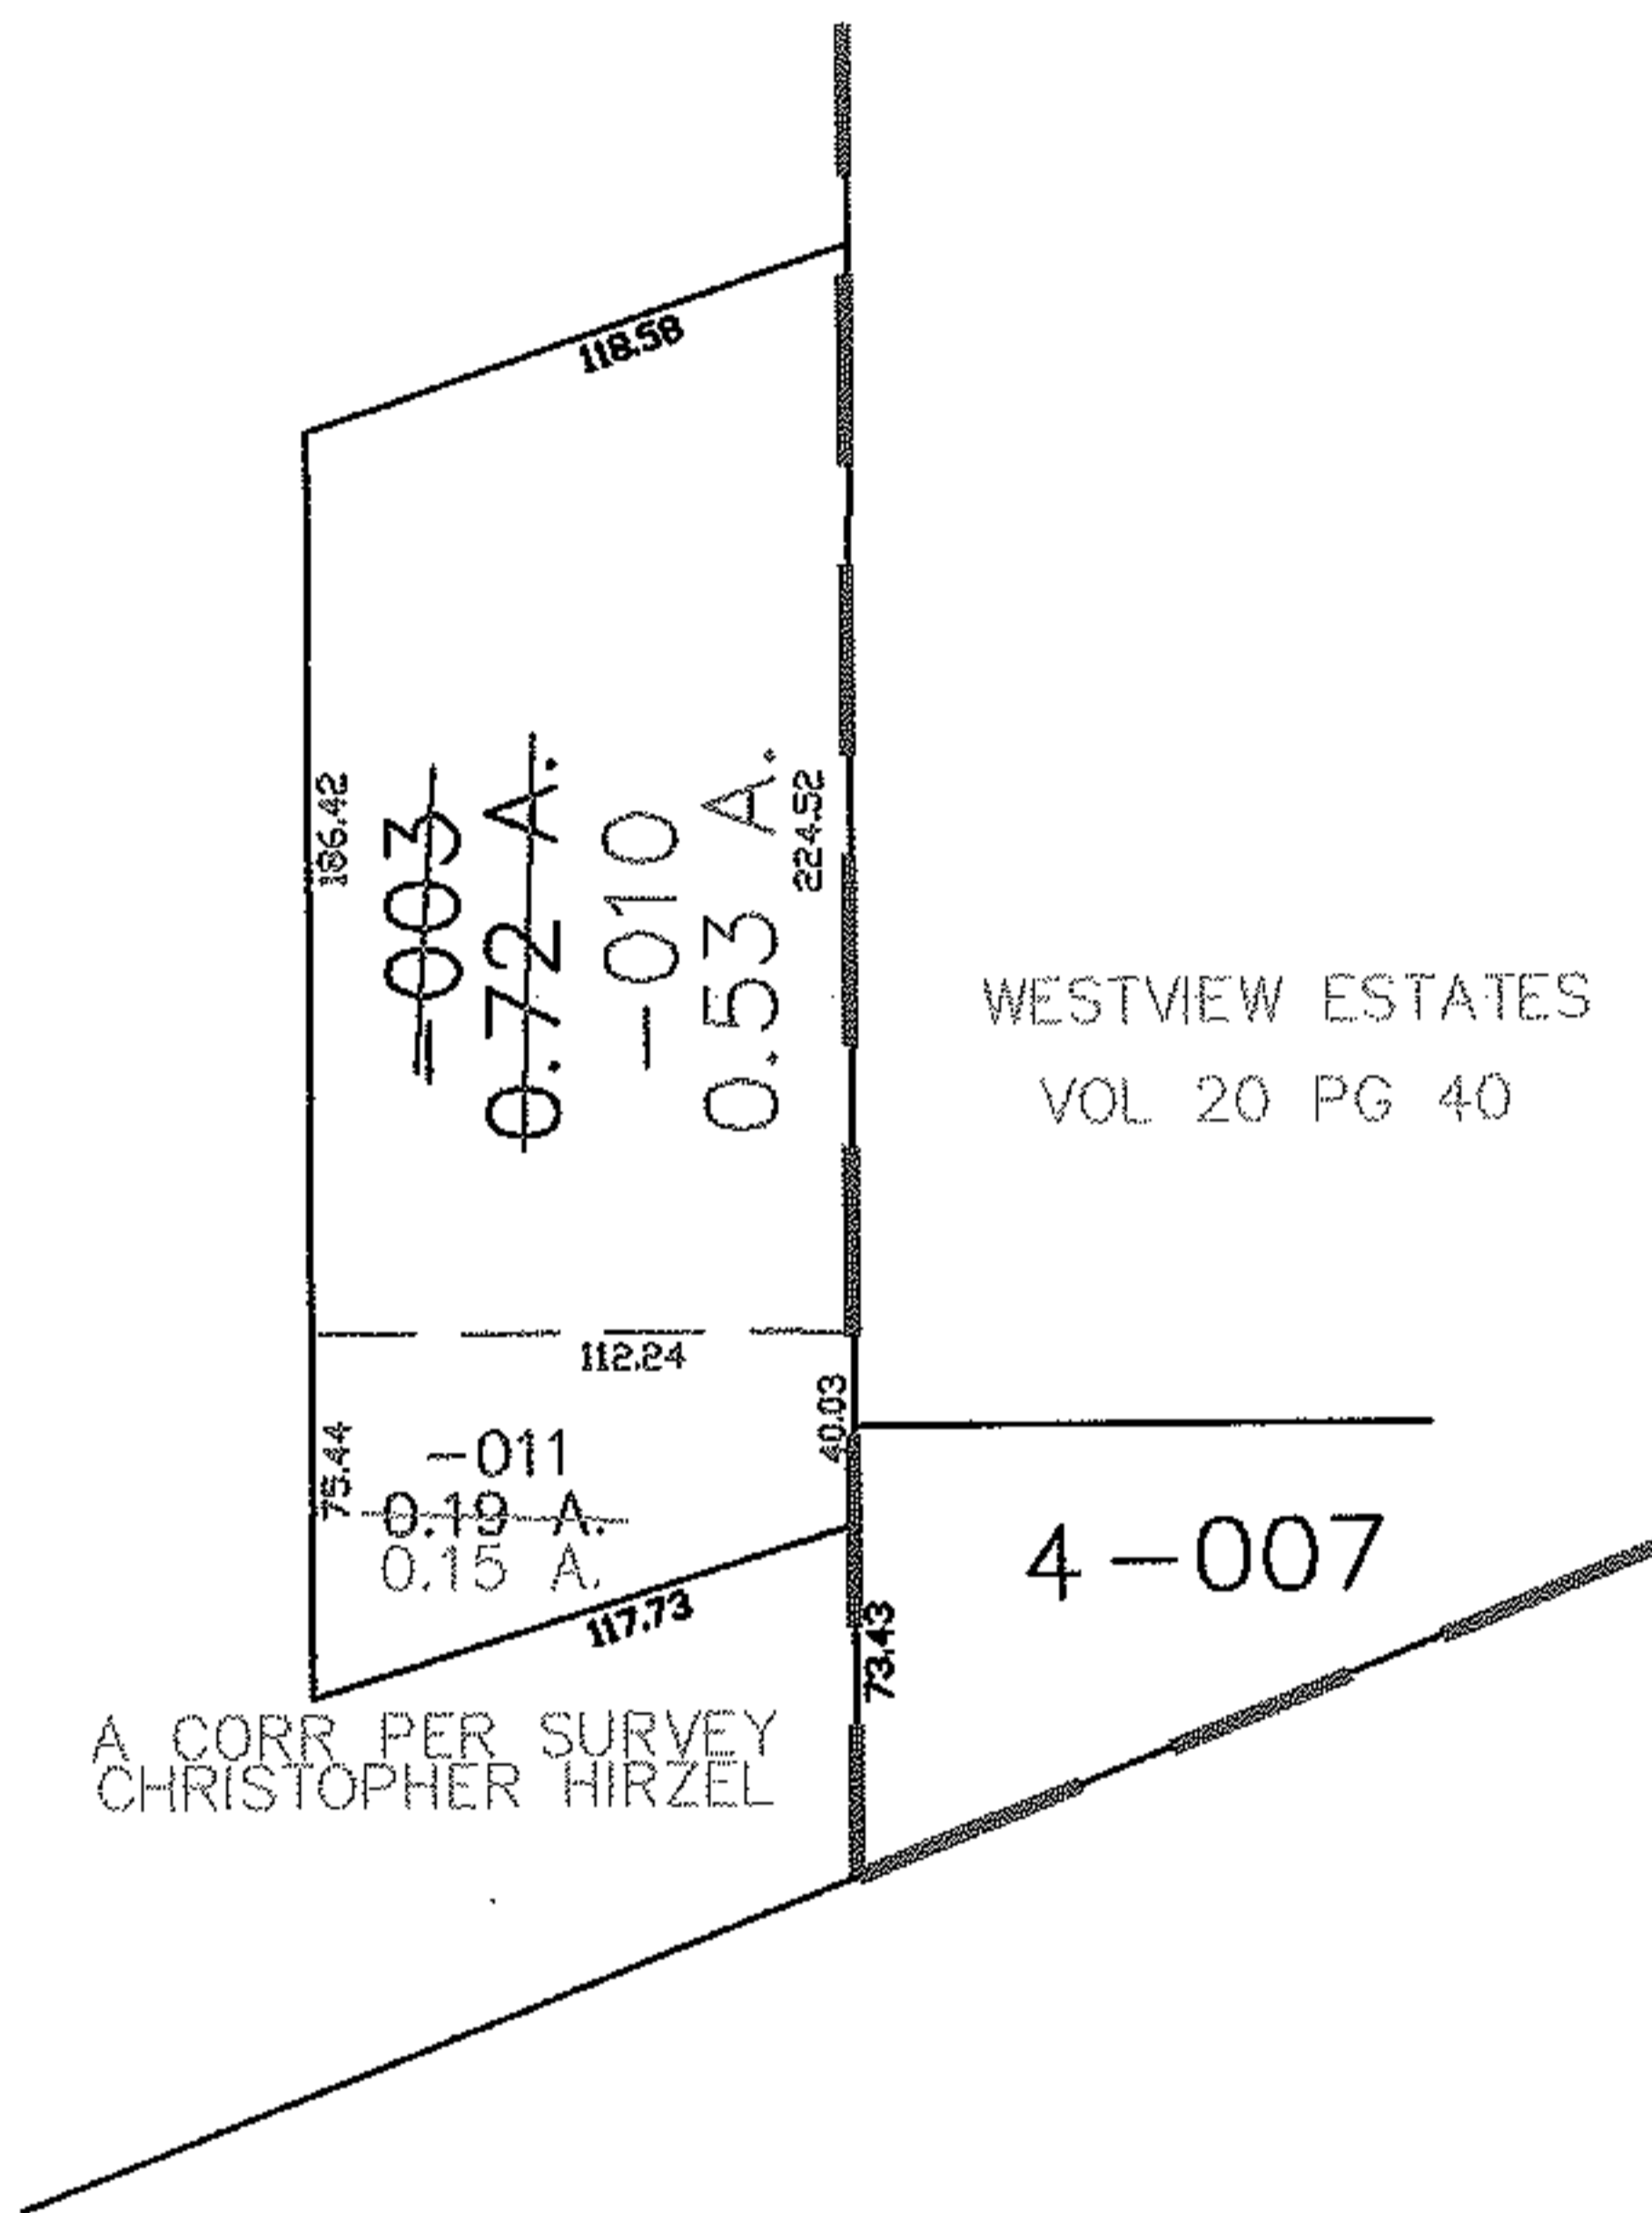


PARENT PARCEL: 03-00-033-106-003

CHILD PARCEL: 03-00-033-106-010, -011

STARTING POINT: SOUTHWEST CORNER OF S/L 4 IN WESTVIEW ESTATES

06-02297

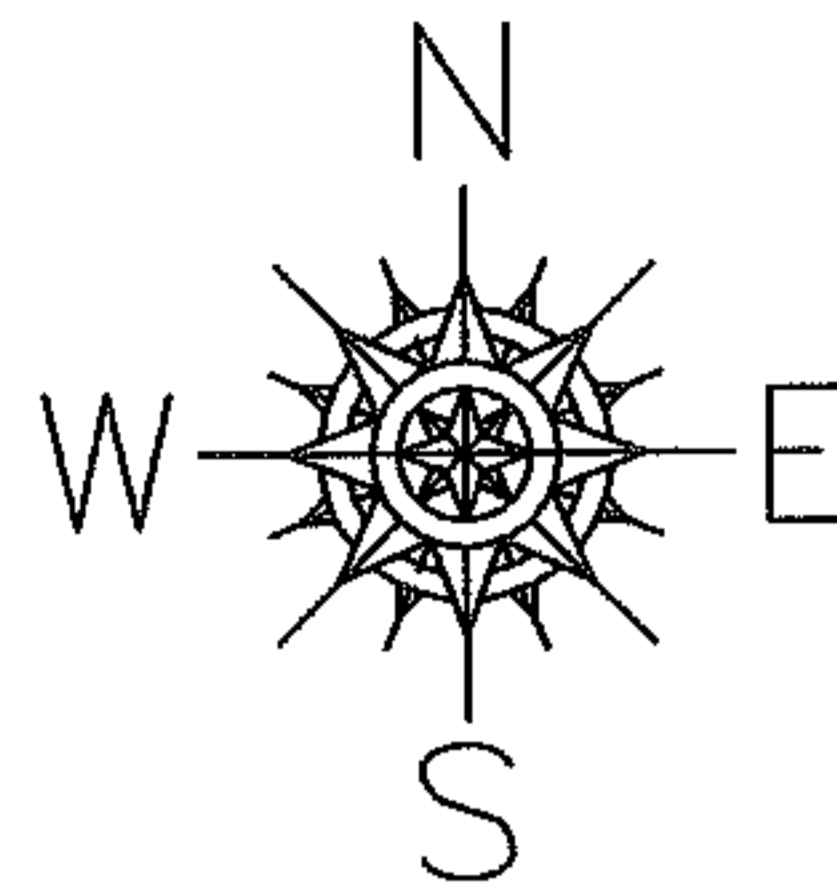

**SPLITS/DEEDS PROCESSED**

LORAIN COUNTY TAX MAP DEPARTMENT  
226 MIDDLE AVE. ELYRIA, OHIO

SURVEYED BY: CHRISTOPHER HIRZEL  
 CLOSURE: 0.00 : 10.000  
 MAP PAGE(S): 03-00-033-A  
 APPROVED BY: JAH DATE: 12-20-06  
 SCALE: 1" = 100 PRIOR INSTRUMENT: OR 103/462