




RASTER

PARENT PARCEL: 04-00-022-102-005

11-02299-A

CHILD PARCEL:

STARTING POINT: SOUTHEAST CORNER OF ARTHUR CHRIST FARM

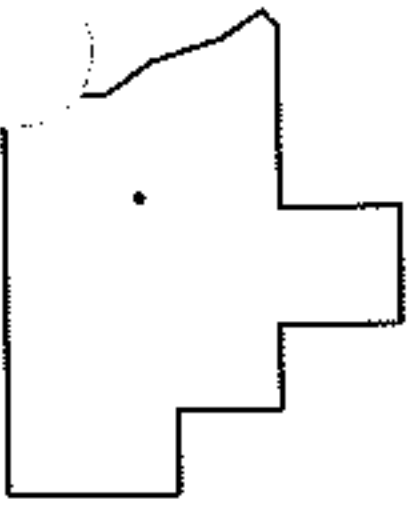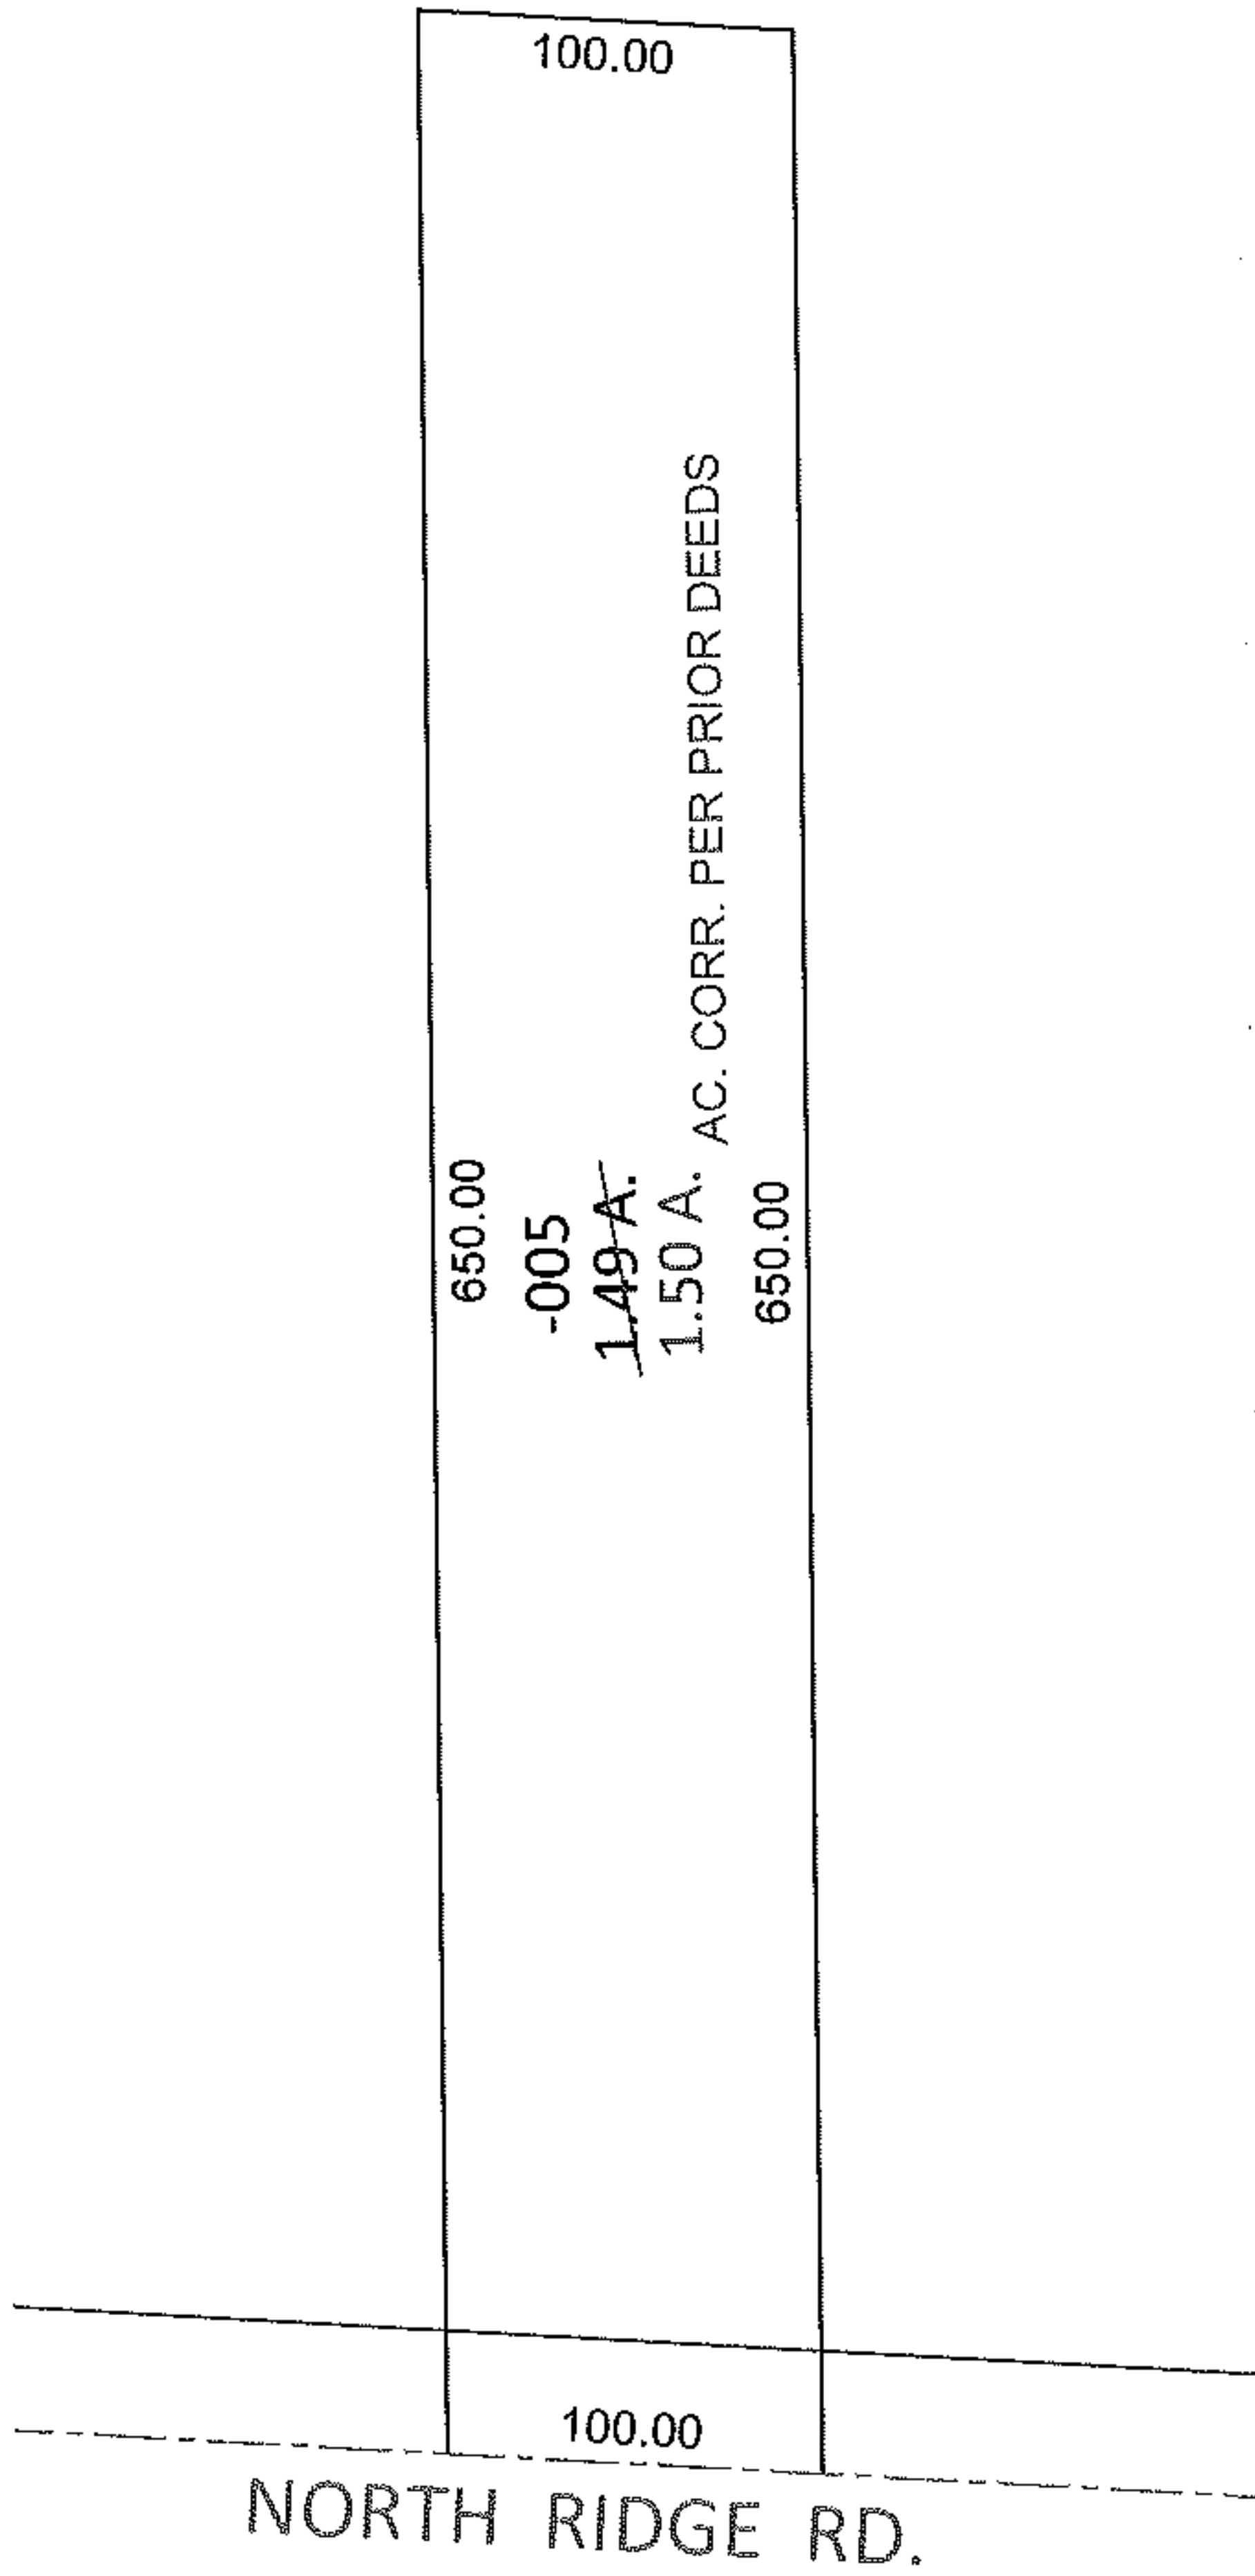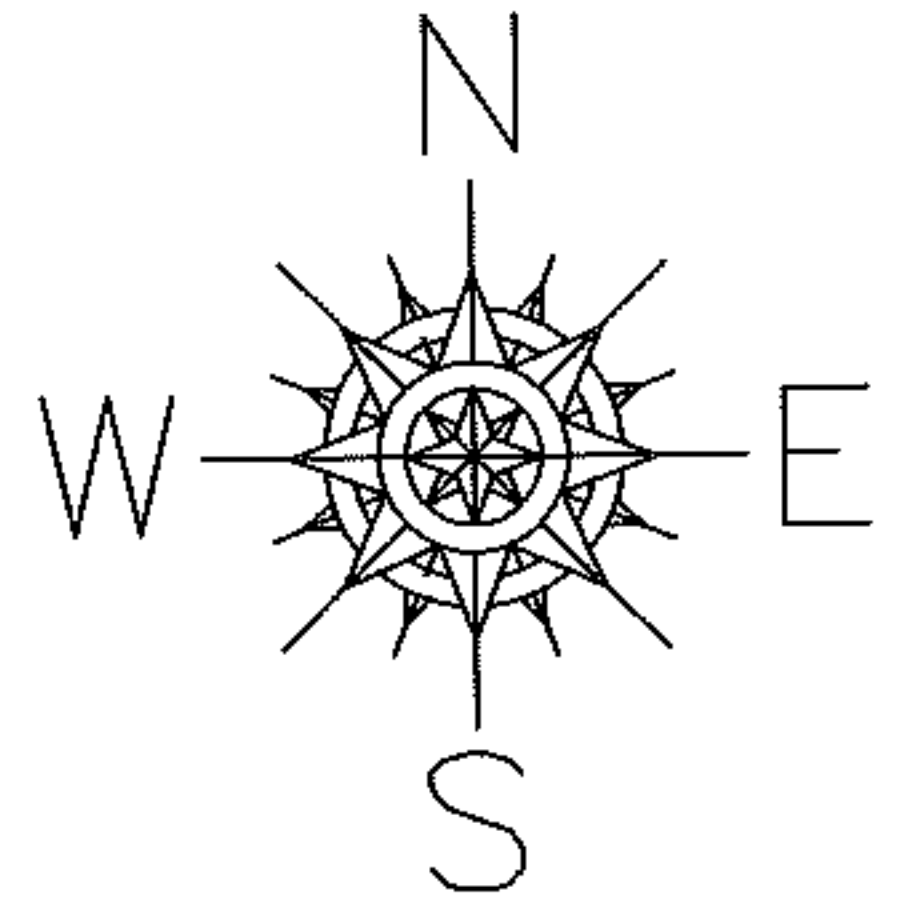

**SPLITS/DEEDS PROCESSED**

LORAIN COUNTY TAX MAP DEPARTMENT  
226 MIDDLE AVE. ELYRIA, OHIO

SURVEYED BY: N/A

CLOSURE: N/A

MAP PAGE(S): 4-00-022-G

APPROVED BY: RRM DATE: 5-24-11

SCALE: 1"= 100 PRIOR INST.: 19990659384