
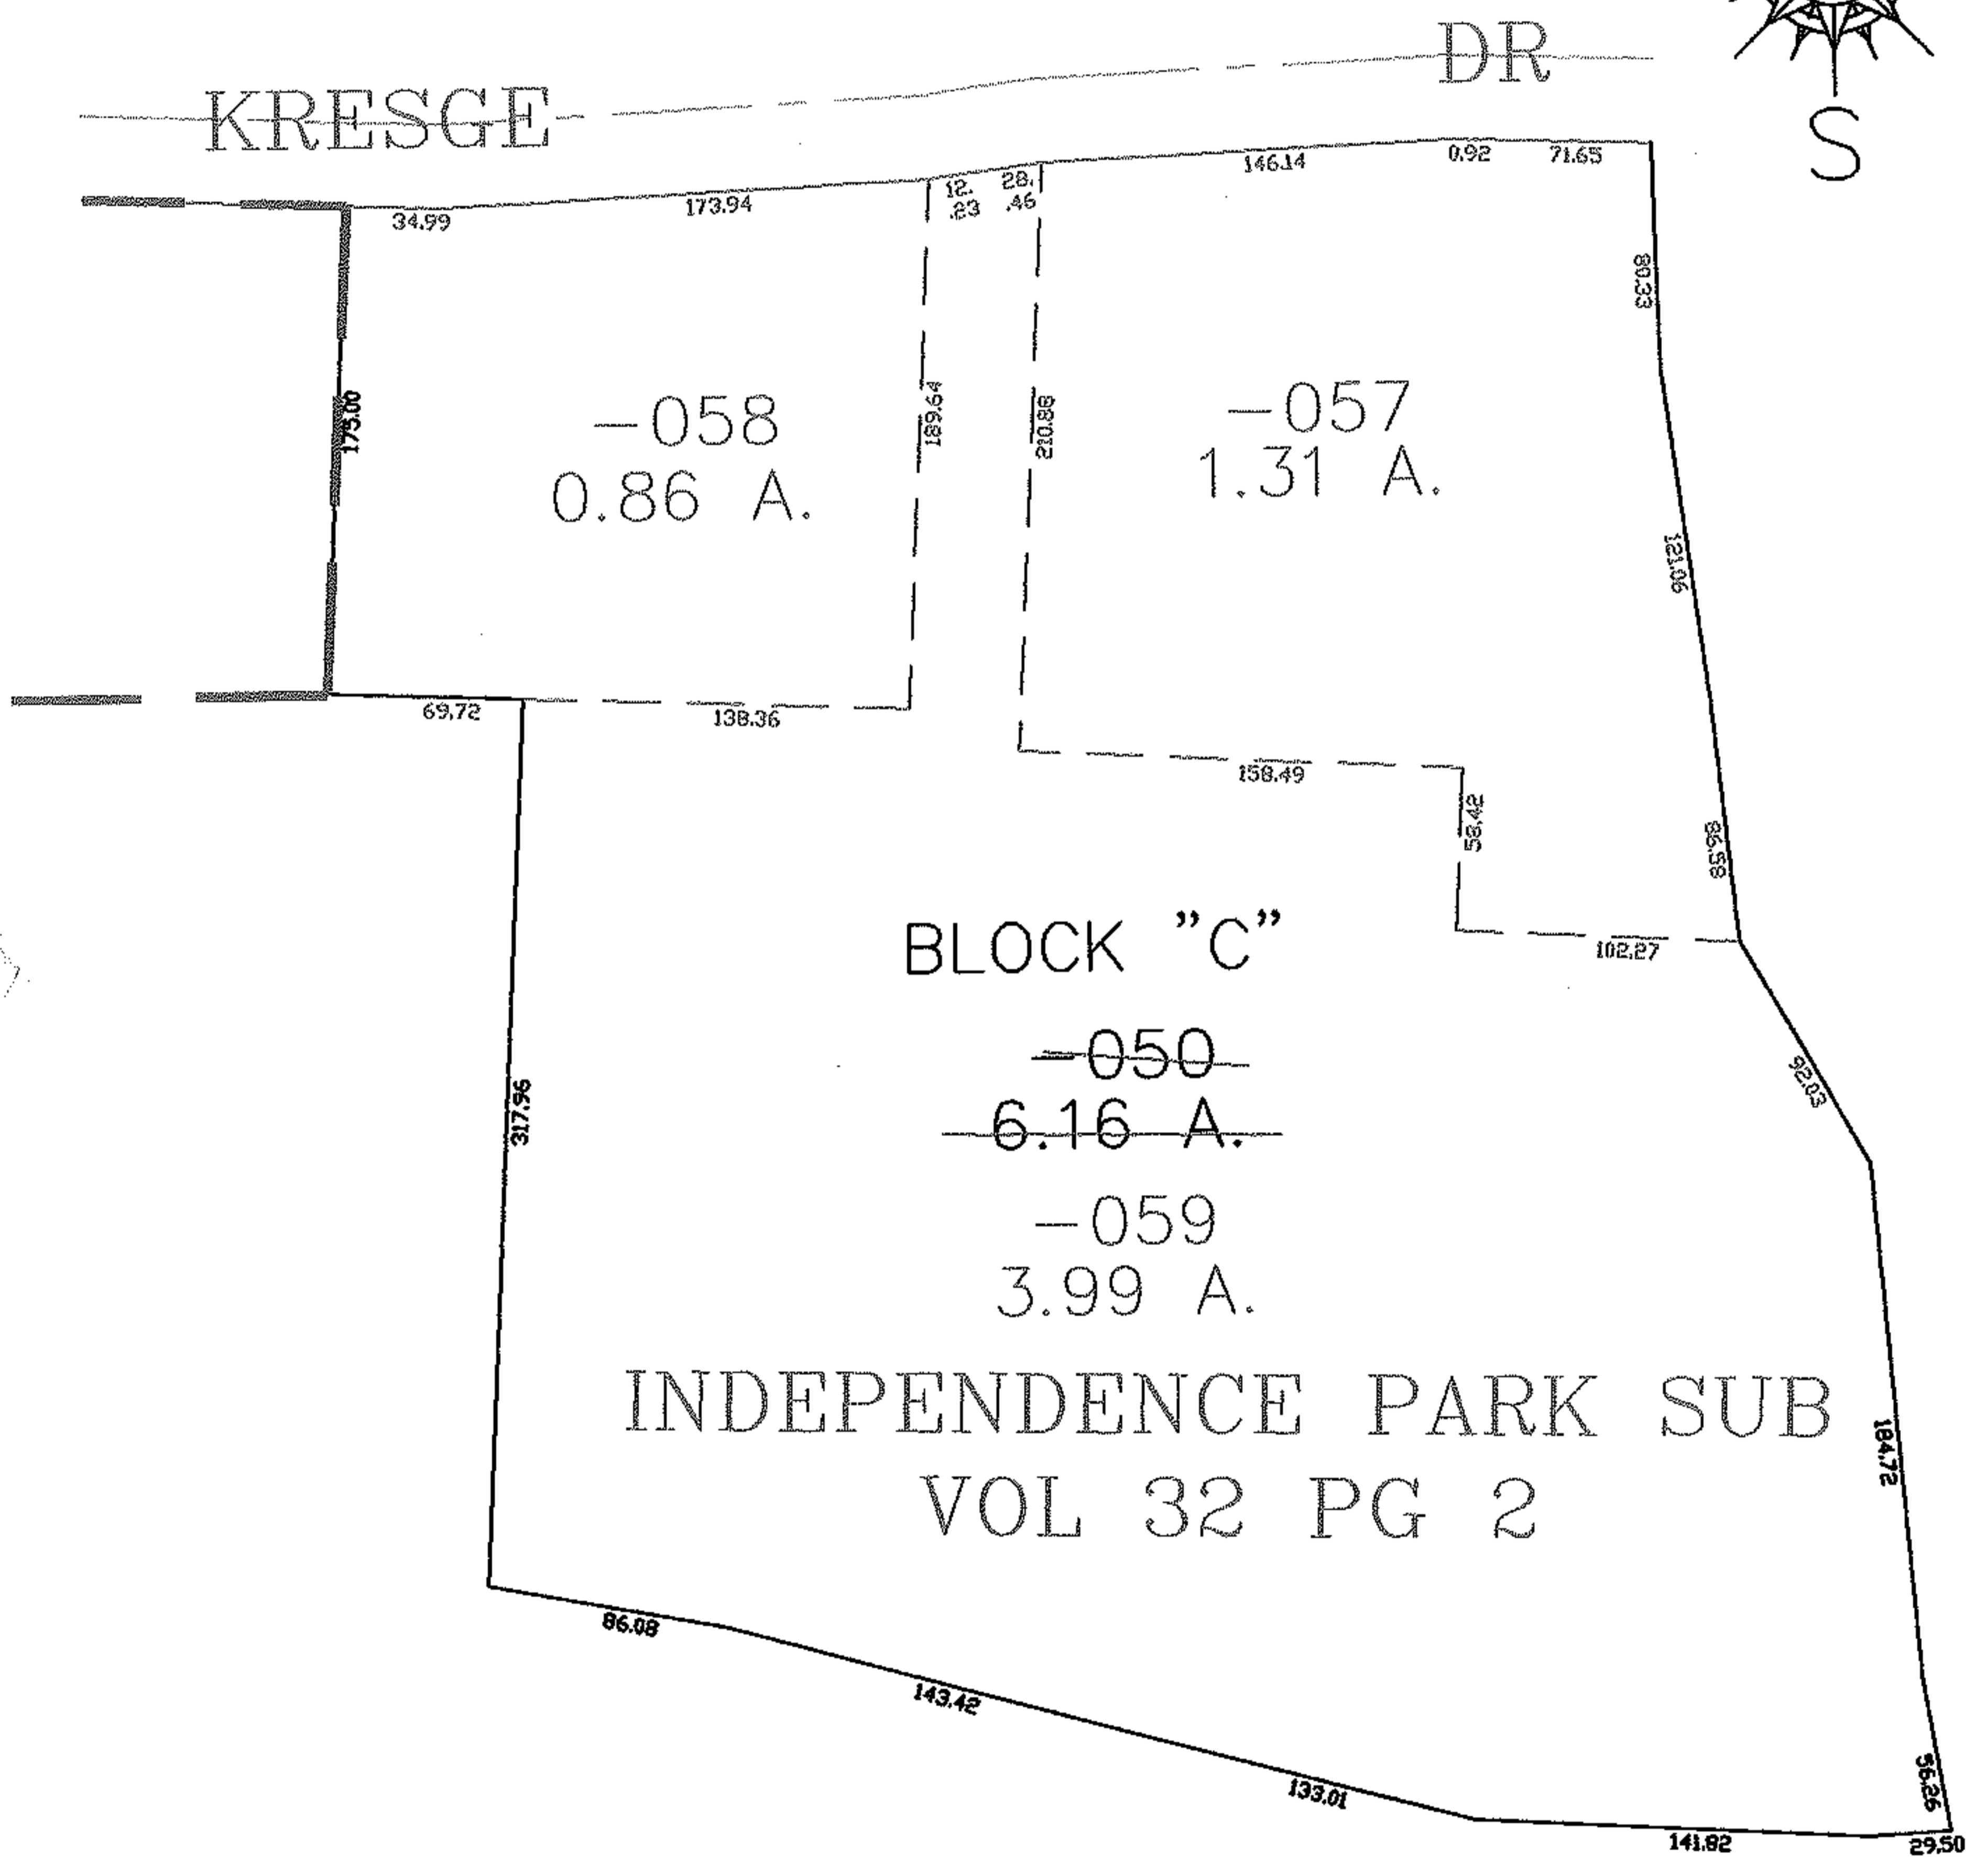


PARENT PARCEL: 05-00-041-110-050

CHILD PARCEL: 05-00-041-110-057 THRU -059

STARTING POINT: SOUTH LINE OF KRESGE DR & NE CORNER BLOCK C IN INDEPENDENCE PARK

06-02300

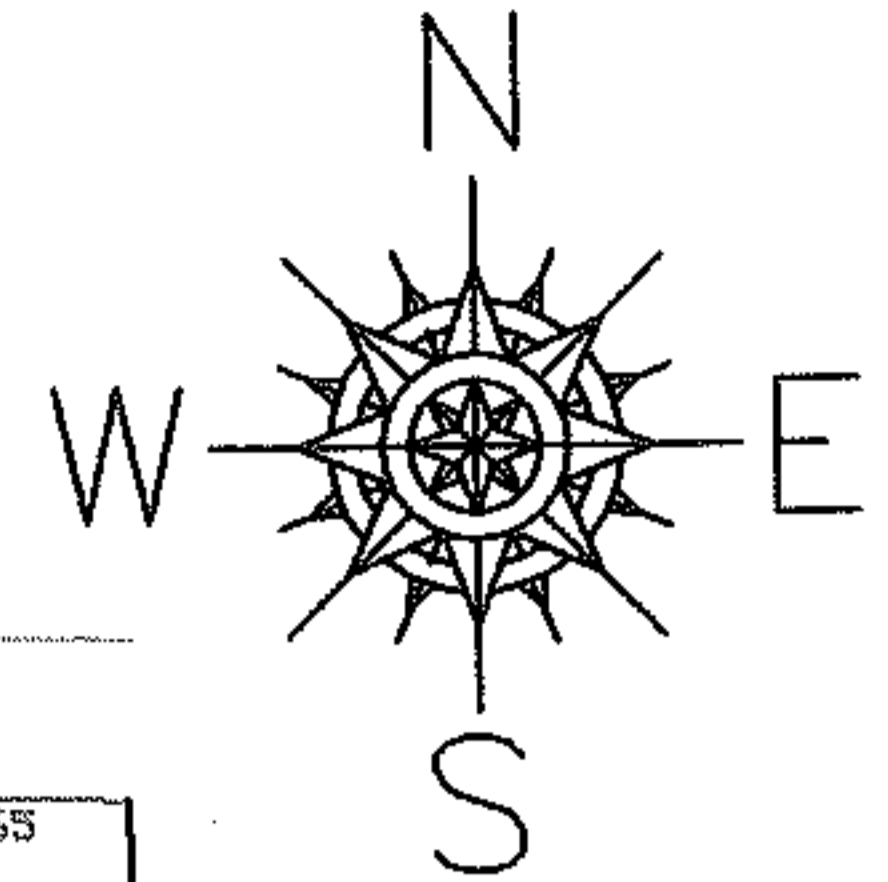

**SPLITS/DEEDS PROCESSED**  
 LORAIN COUNTY TAX MAP DEPARTMENT  
 226 MIDDLE AVE. ELYRIA, OHIO

SURVEYED BY: DALE HAYWOOD  
 CLOSURE: 0.00 : 10.000  
 MAP PAGE(S): 05-00-041-A  
 APPROVED BY: JAH DATE: 12-28-06  
 SCALE: 1" = 100 PRIOR INSTRUMENT: 20000703733