



RASTER

PARENT PARCEL: 04-00-007-104-032

11-02302-C

CHILD PARCEL:

STARTING POINT: INTERSECTION OF C/L OF LAKE RD. AND WEST LINE OF LAND CONVEYED TO HENRY MOORE

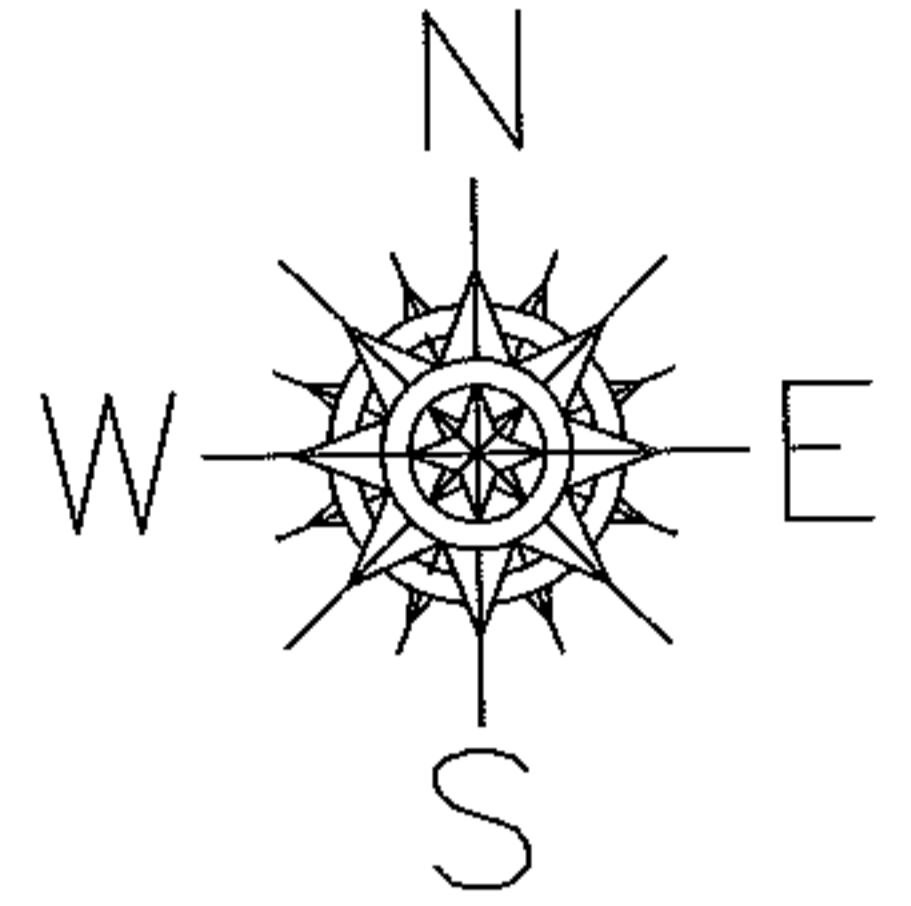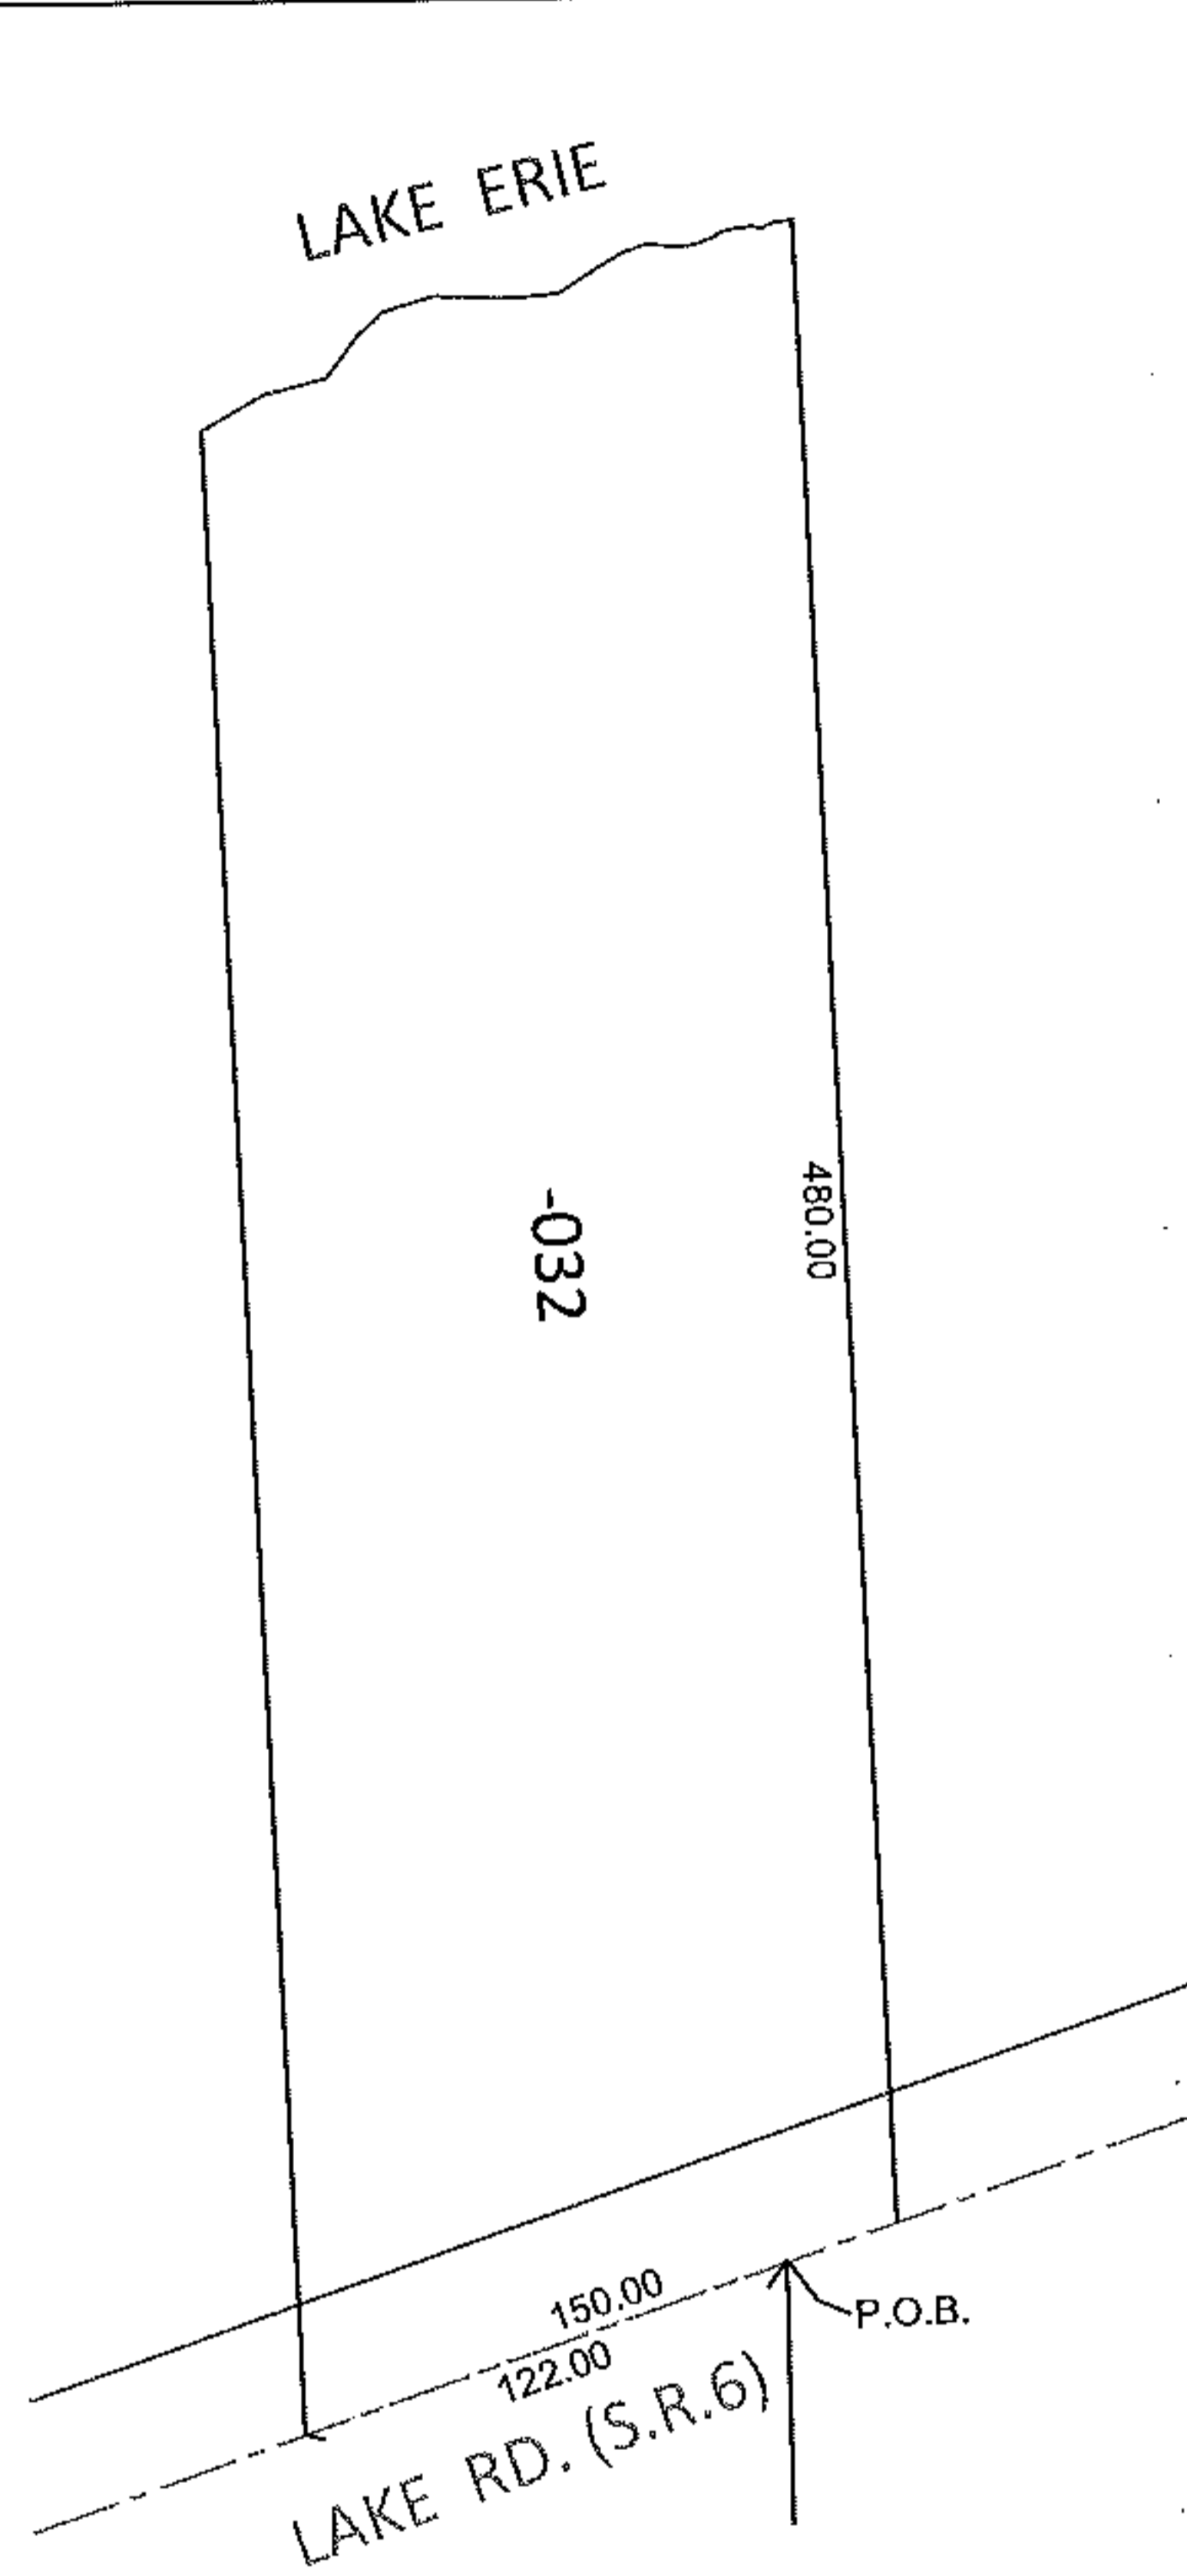

ACREAGE TO FRONTAGE AND DEPTH CORRECTION


04-00-007-104-032

150 X 480

~~1.65 A.~~

CORR. PER PRIOR DEEDS

AC. WAS NEVER LISTED ON PRIOR DEEDS

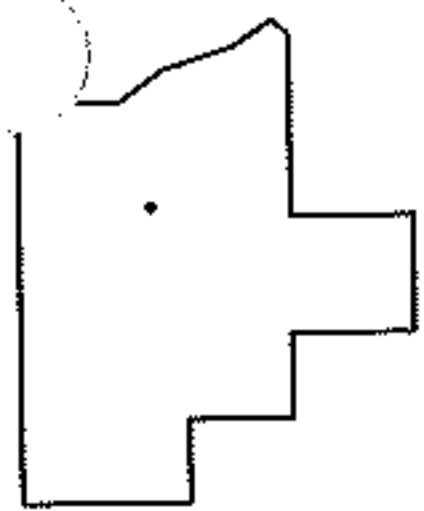

SPLITS/DEEDS PROCESSED

LORAIN COUNTY TAX MAP DEPARTMENT
226 MIDDLE AVE. ELYRIA, OHIO

SURVEYED BY: N/A

CLOSURE: N/A

MAP PAGE(S): 4-00-007-D

APPROVED BY: RRM DATE: 9-1-11

SCALE: 1"=100 PRIOR INST.: DV 1399/775