
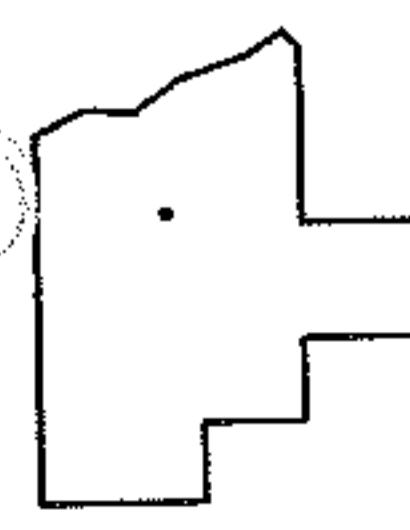
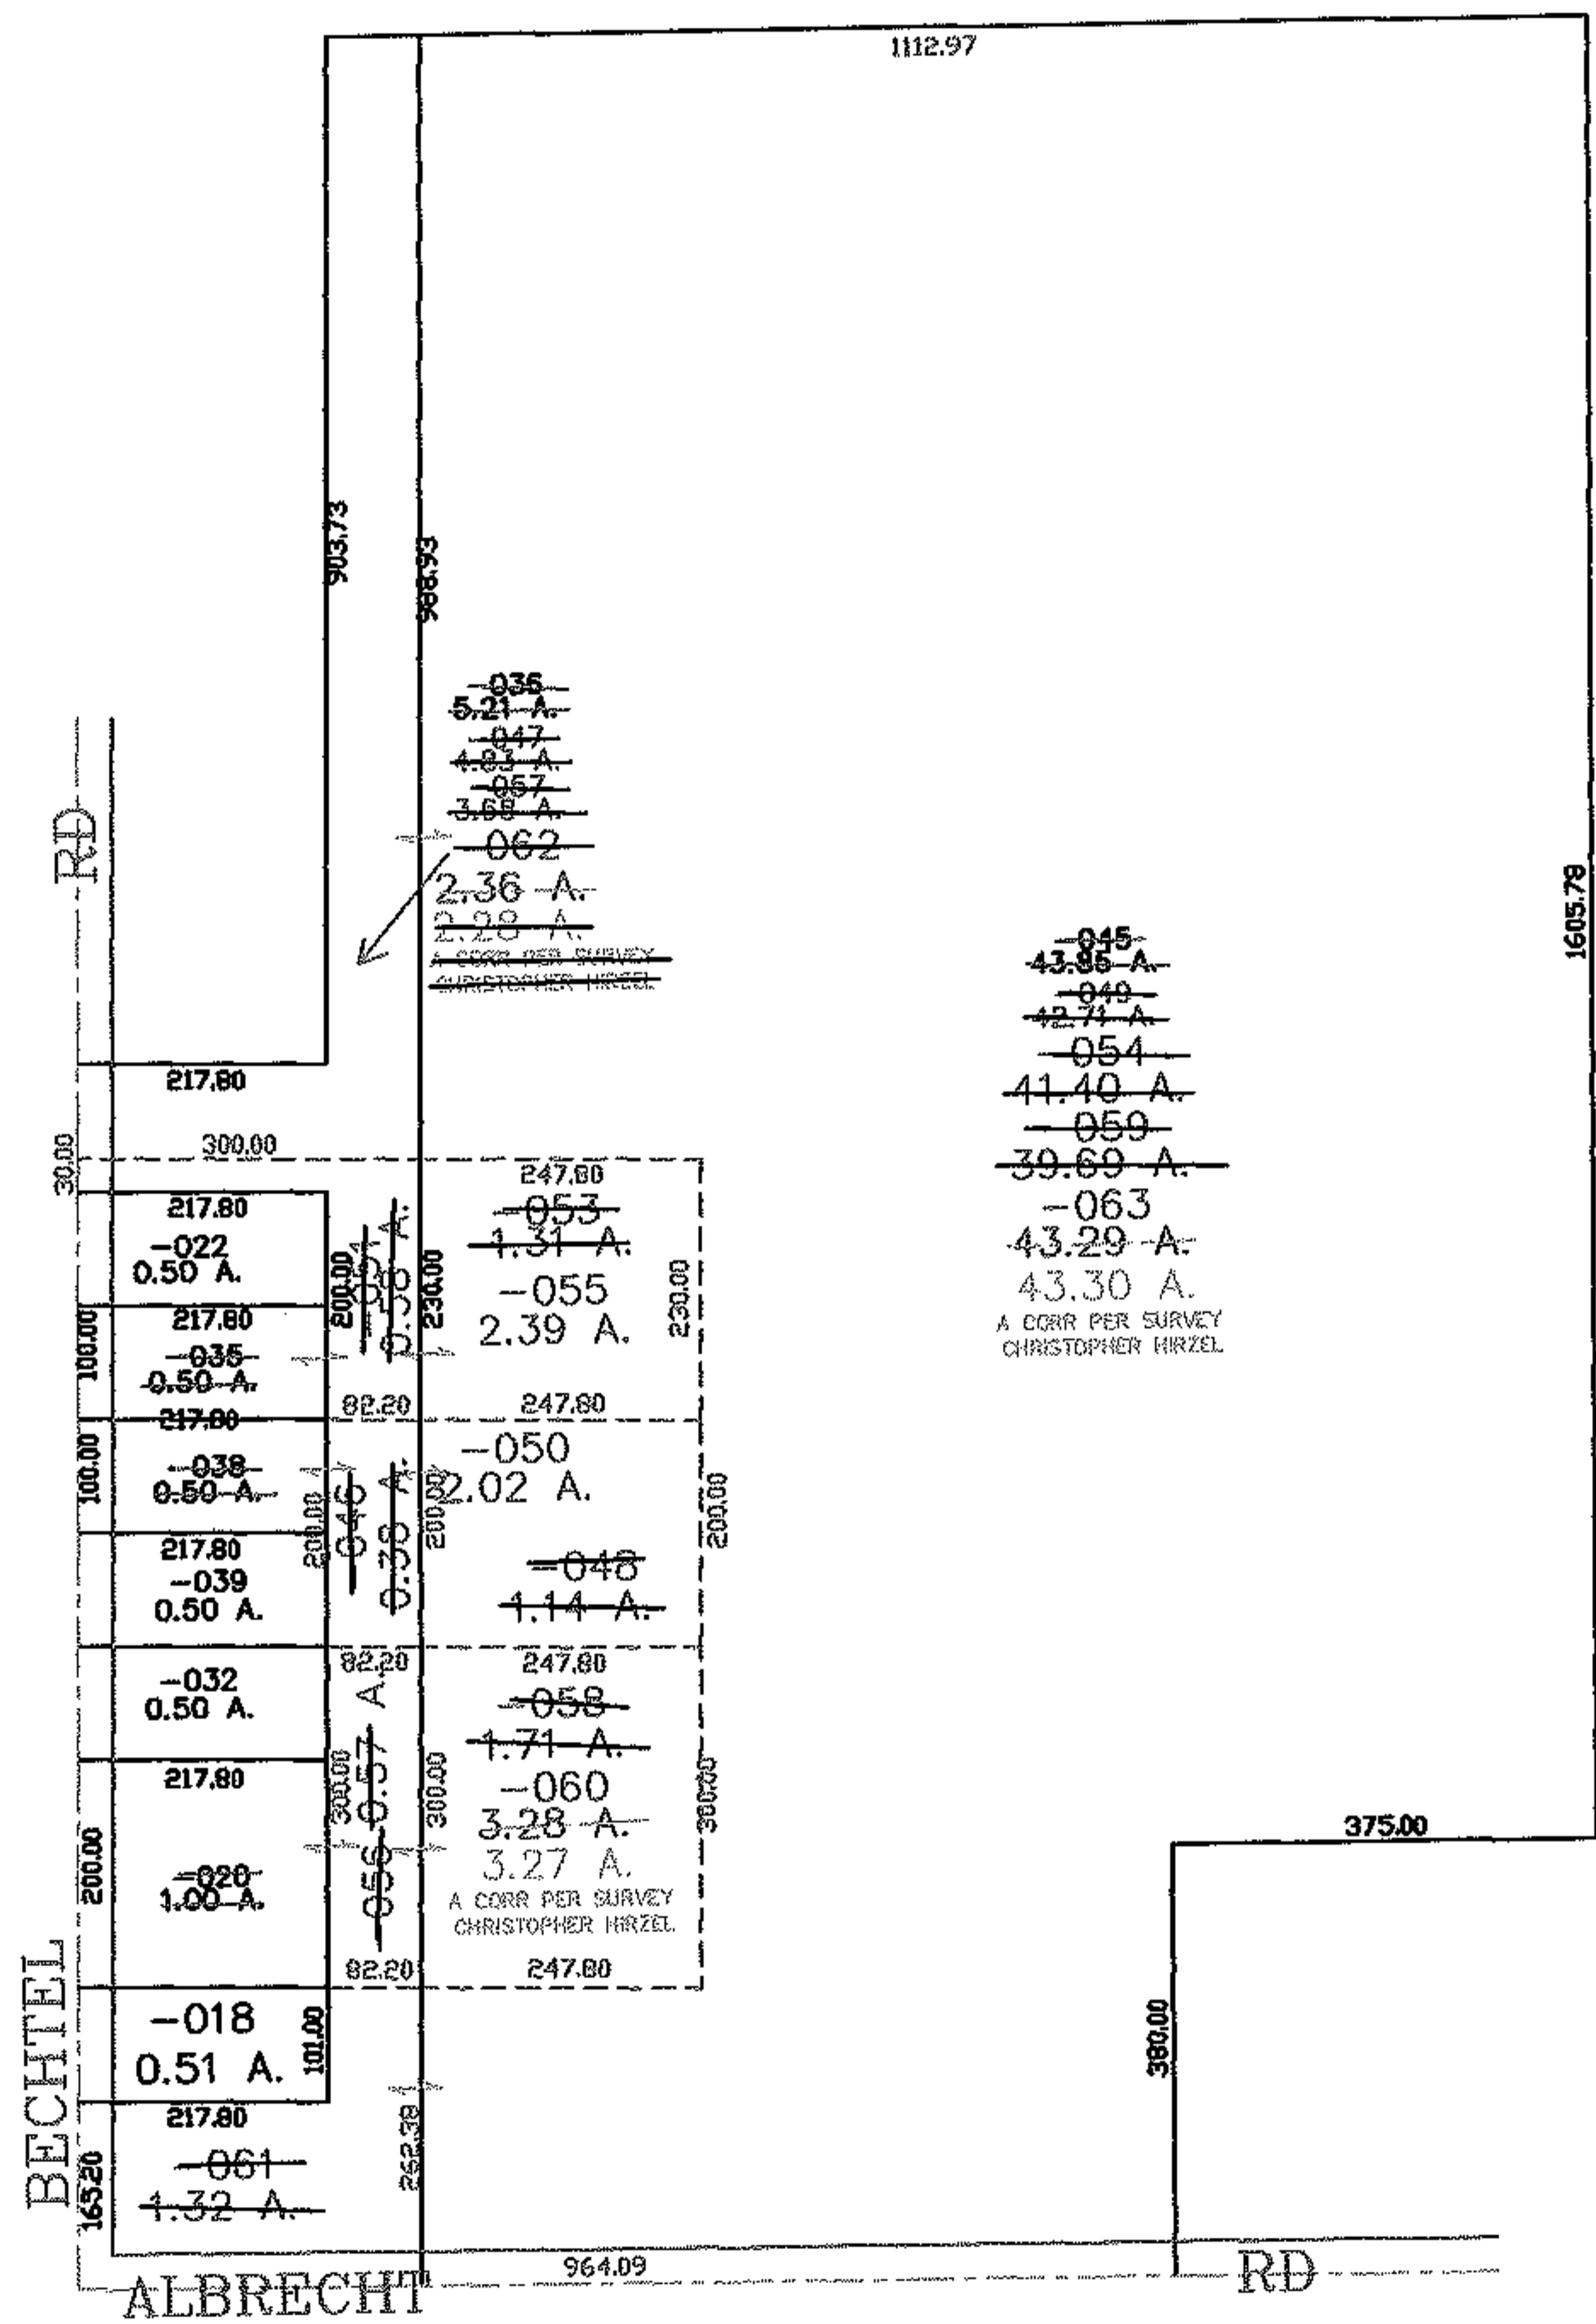


PARENT PARCEL: 05-00-071-000-036, -045, -038, -035, -020

CHILD PARCEL: 05-00-071-000-046 THRU -063

STARTING POINT: CENTERLINE OF BECHTEL RD & ALBRECHT RD

06-02302

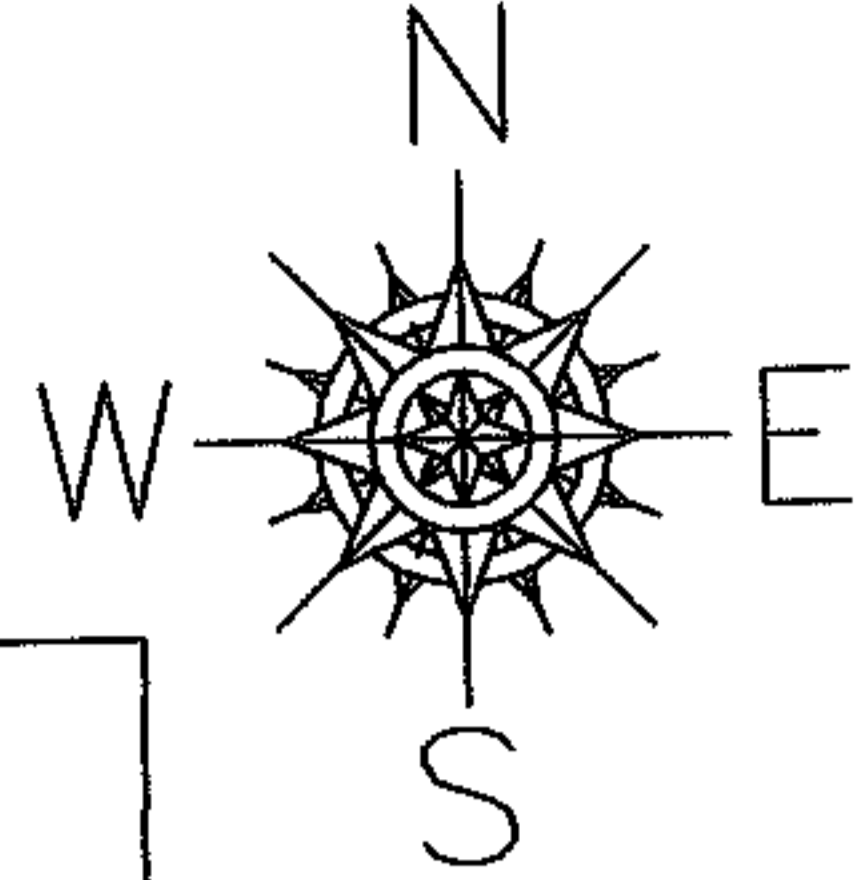

SPLITS/DEEDS PROCESSED
LORAIN COUNTY TAX MAP DEPARTMENT
 226 MIDDLE AVE. ELYRIA, OHIO

SURVEYED BY: CHRISTOPHER HIRZEL
 CLOSURE: 0.00 : 10.000
 MAP PAGE(S): 05-00-071-B
 APPROVED BY: JAH DATE: 1-3-07
 SCALE: 1" = 300 PRIOR INSTRUMENT: 19980532119