
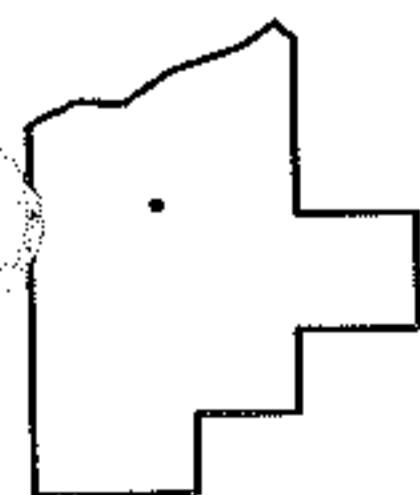
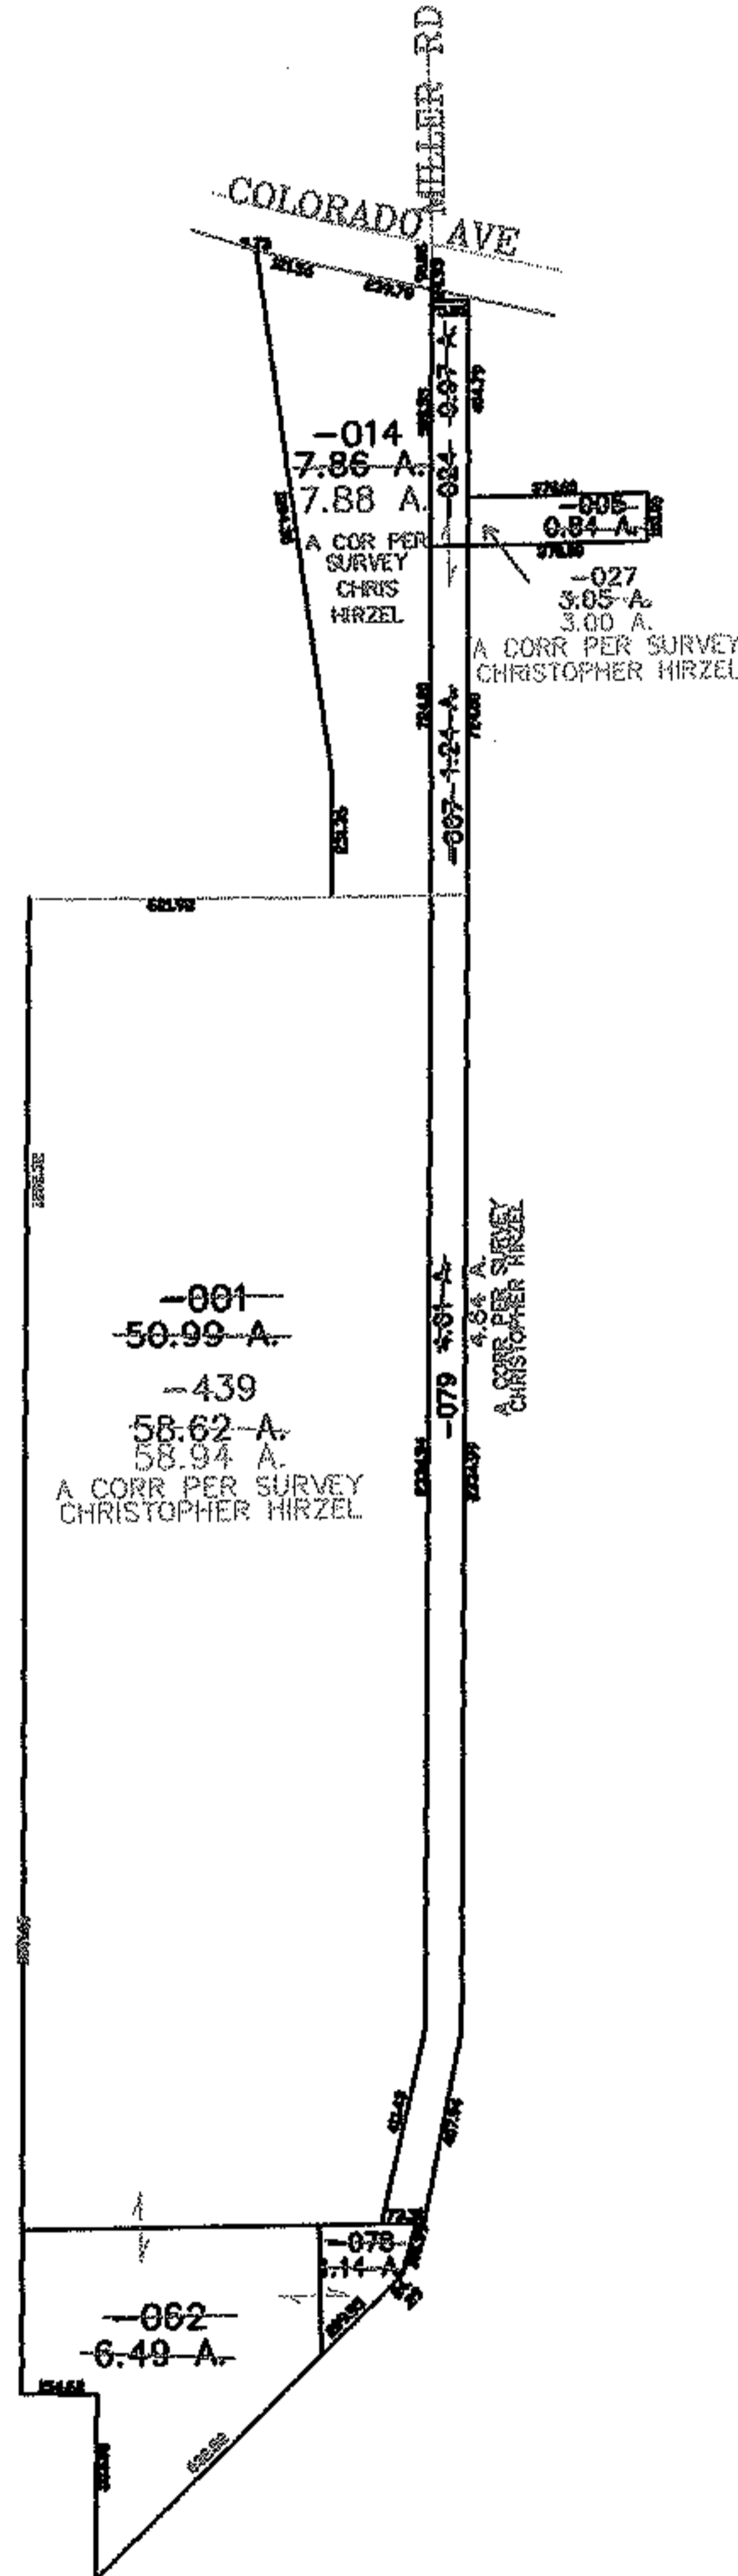


RASTER

PARENT PARCEL: 04-00-004-103-024 -005 -007 -014 04-00-003-101-062 -078 001 079  
CHILD PARCEL: 04-00-003-101-439 04-00-004-103-027  
STARTING POINT: CENTERLINE OF COLORADO AVE & MILLER RD

06-02304

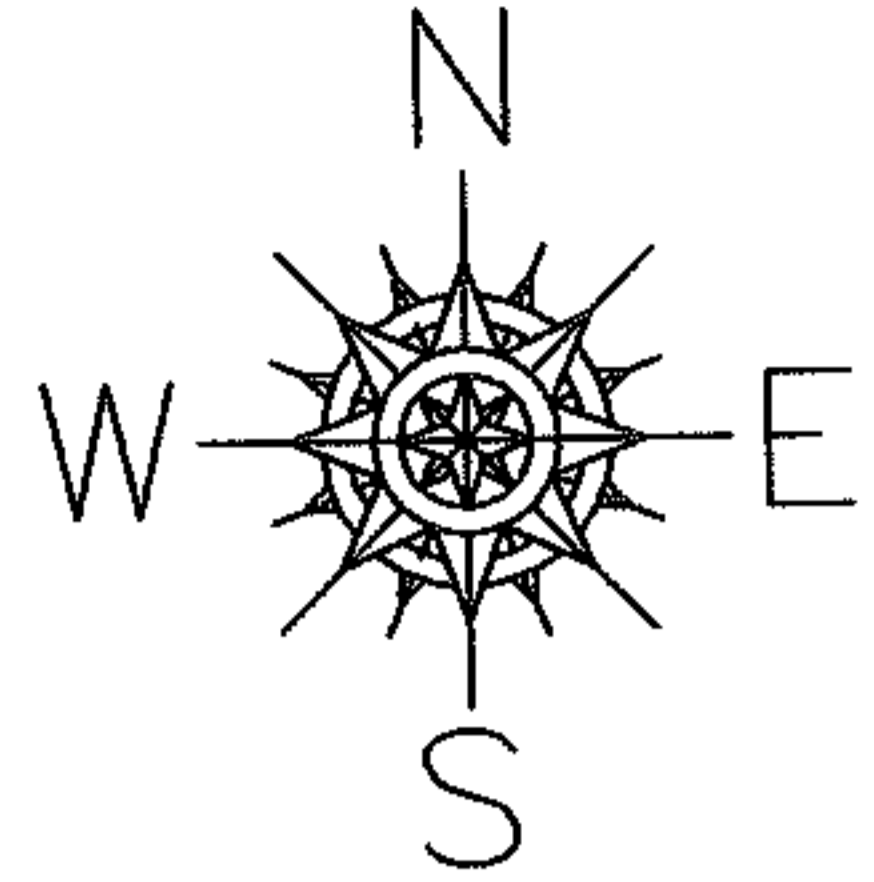

**SPLITS/DEEDS PROCESSED**

LORAIN COUNTY TAX MAP DEPARTMENT  
226 MIDDLE AVE. ELYRIA, OHIO

SURVEYED BY: CHRISTOPHER HIRZEL  
CLOSURE: 0.00 : 10.000  
MAP PAGE(S): 04-00-003-A  
APPROVED BY: JAH DATE: 01-05-07  
SCALE: 1" = 700 PRIOR INSTRUMENT: DV 958/28