




RASTER

PARENT PARCEL: 04-00-017-101-092

06-02306

CHILD PARCEL: 04-00-017-101-193, -194

STARTING POINT: CENTERLINE OF WALKER RD \* O.L. 17

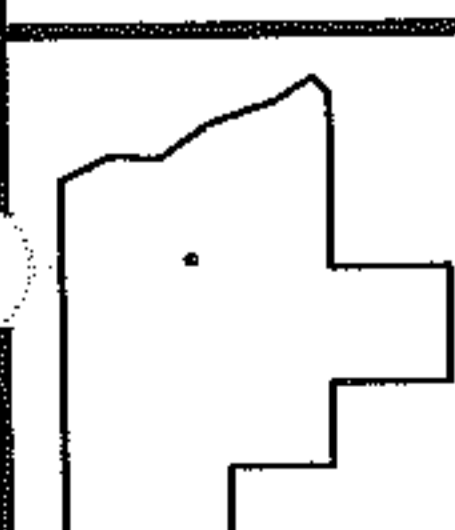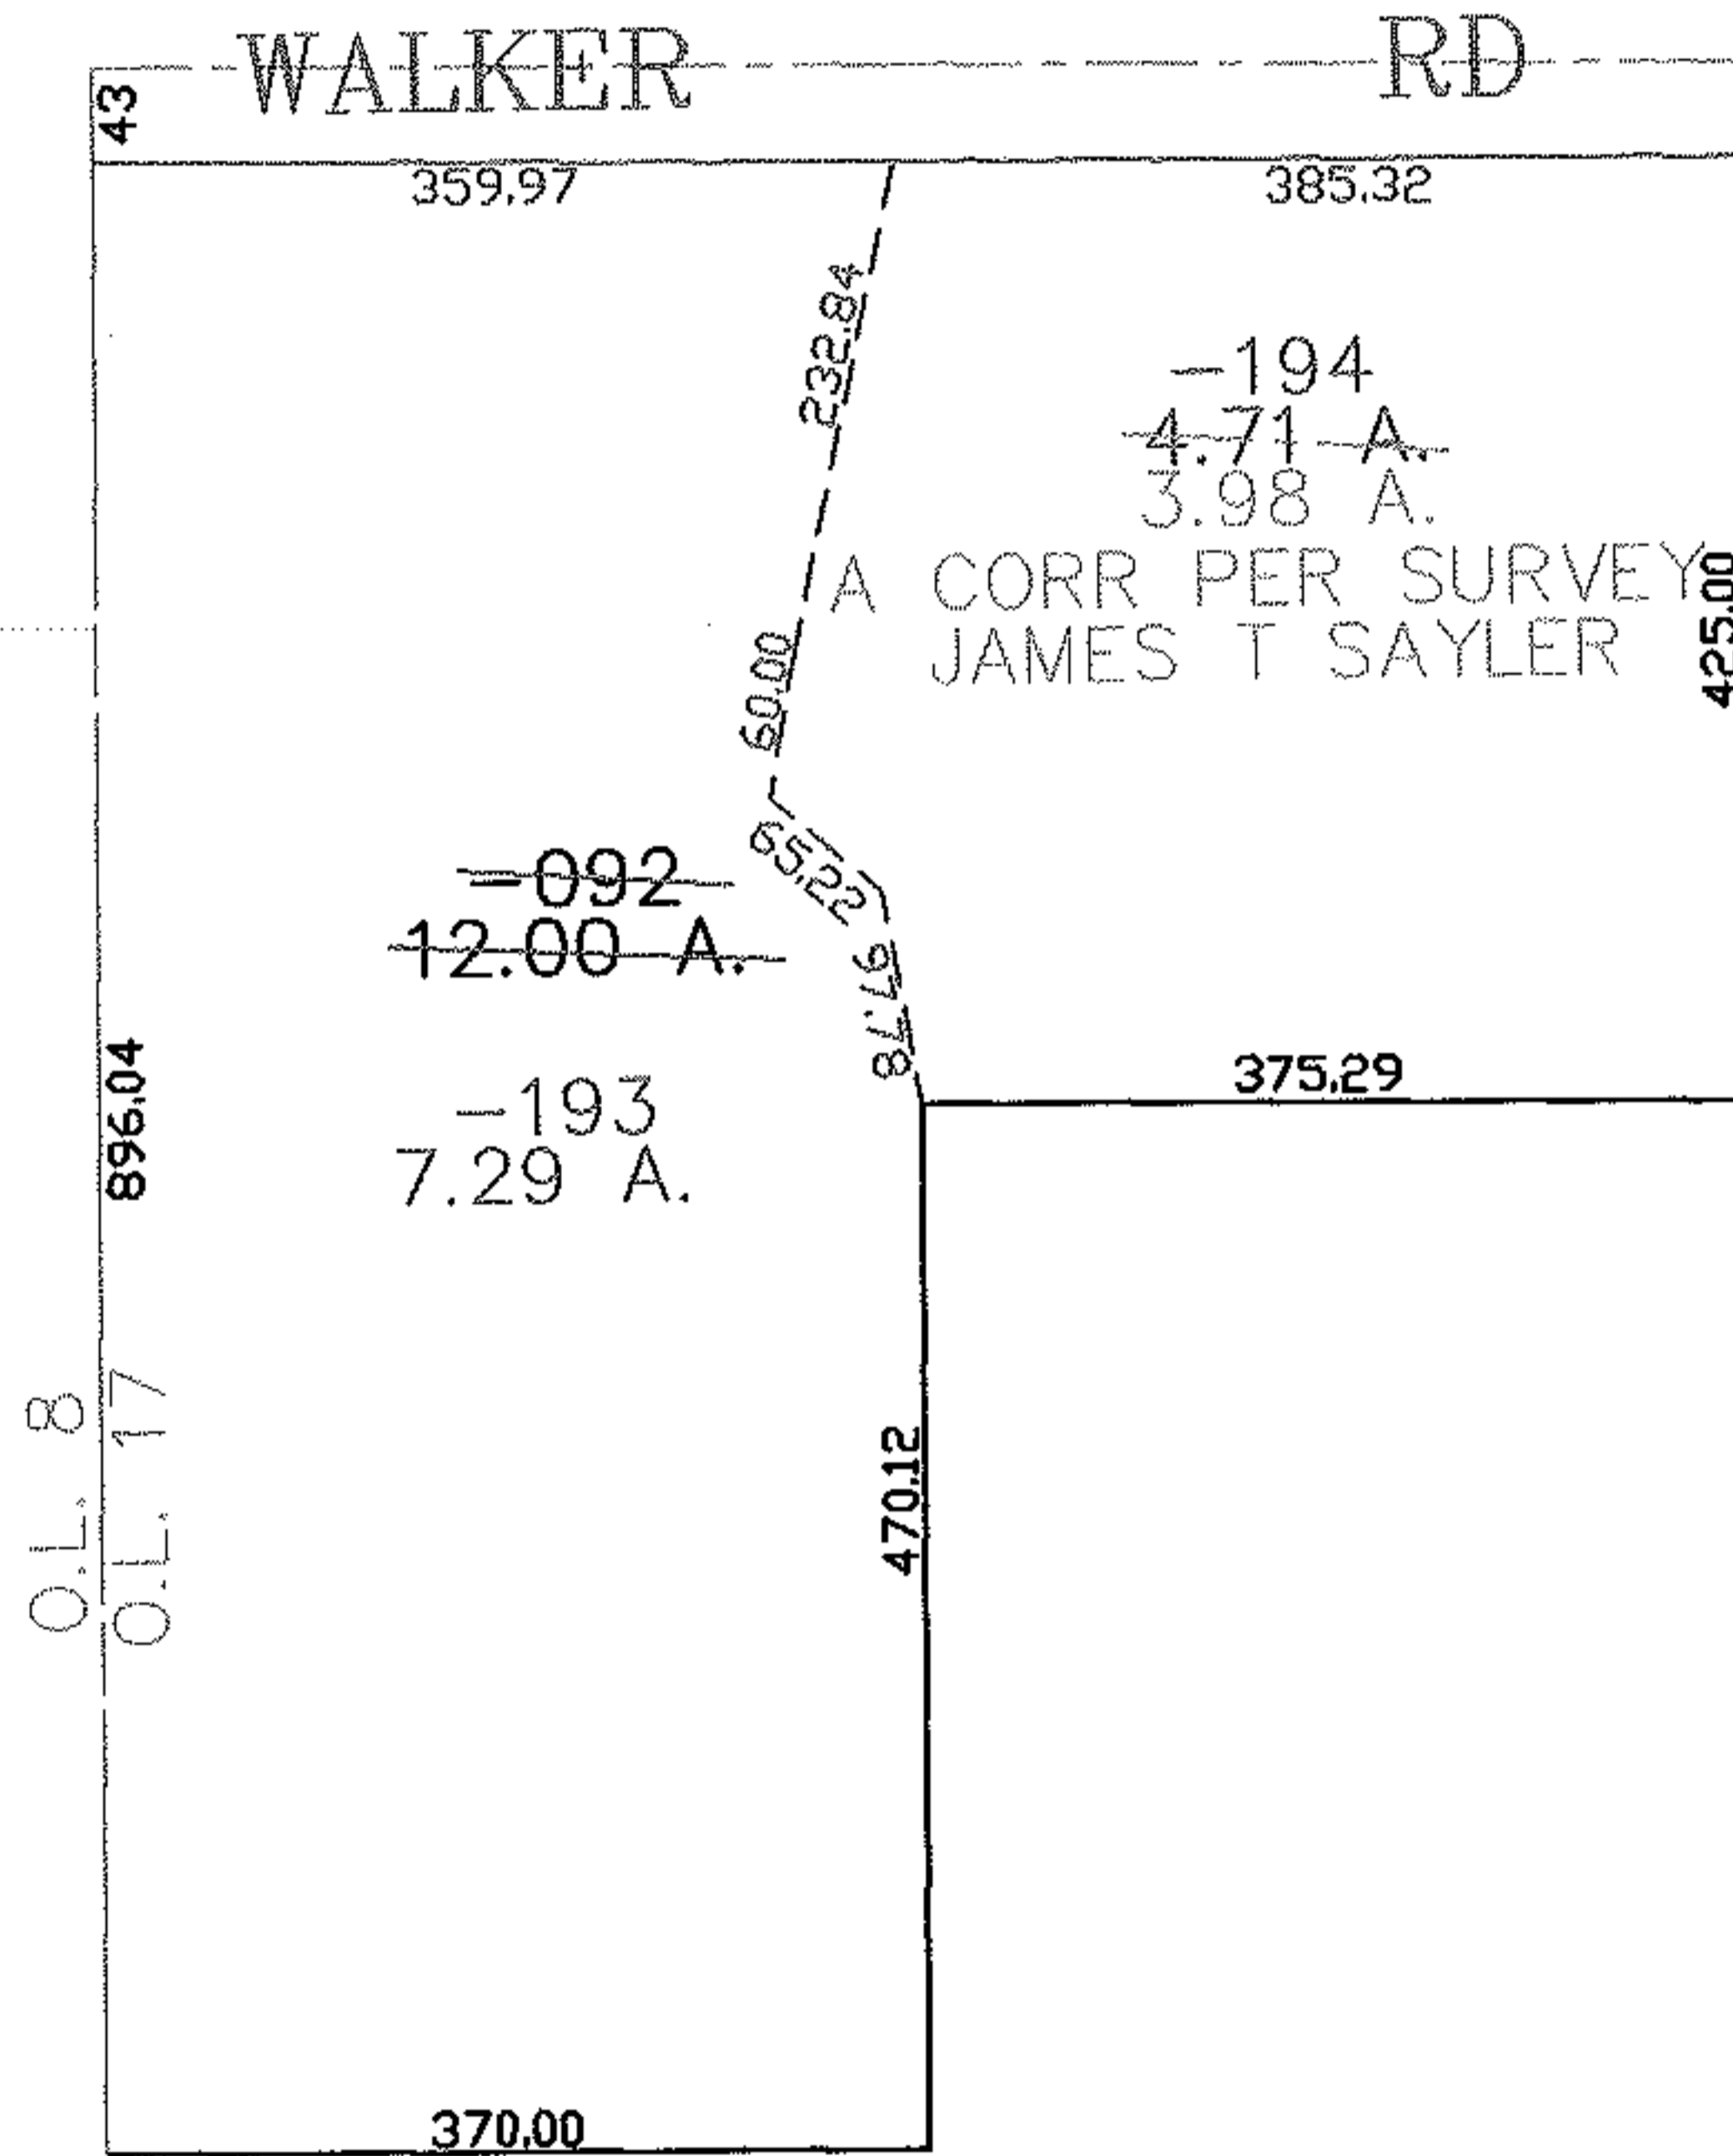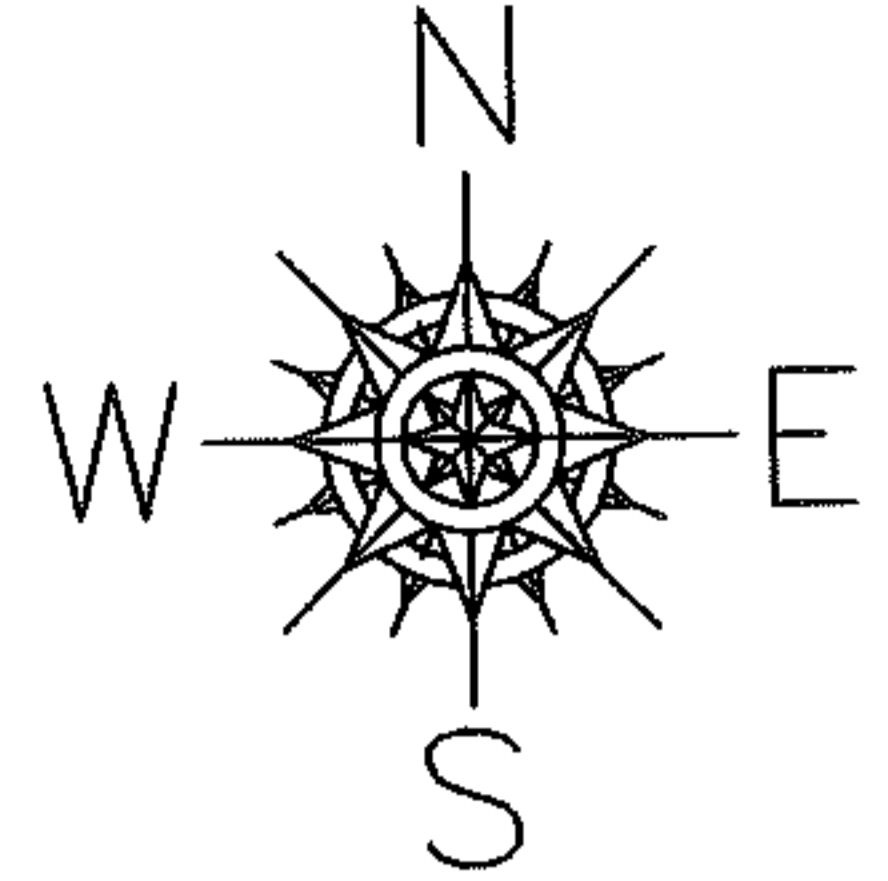

**SPLITS/DEEDS PROCESSED**

LORAIN COUNTY TAX MAP DEPARTMENT  
226 MIDDLE AVE. ELYRIA, OHIO

SURVEYED BY: JAMES T SAYLER

CLOSURE: 0.00 : 10.000

MAP PAGE(S): 04-00-017-A

APPROVED BY: JAH DATE: 1-8-07

SCALE: 1" = 200 PRIOR INSTRUMENT: OR 338/34