



RASTER

PARENT PARCEL: 04-00-022-101-137, 04-00-022-800-016


07-02308

CHILD PARCEL: 04-00-022-101-139, -140 04-00-022-800-018, -019

STARTING POINT: CENTERLINE OF DETROIT RD & O.L. 22

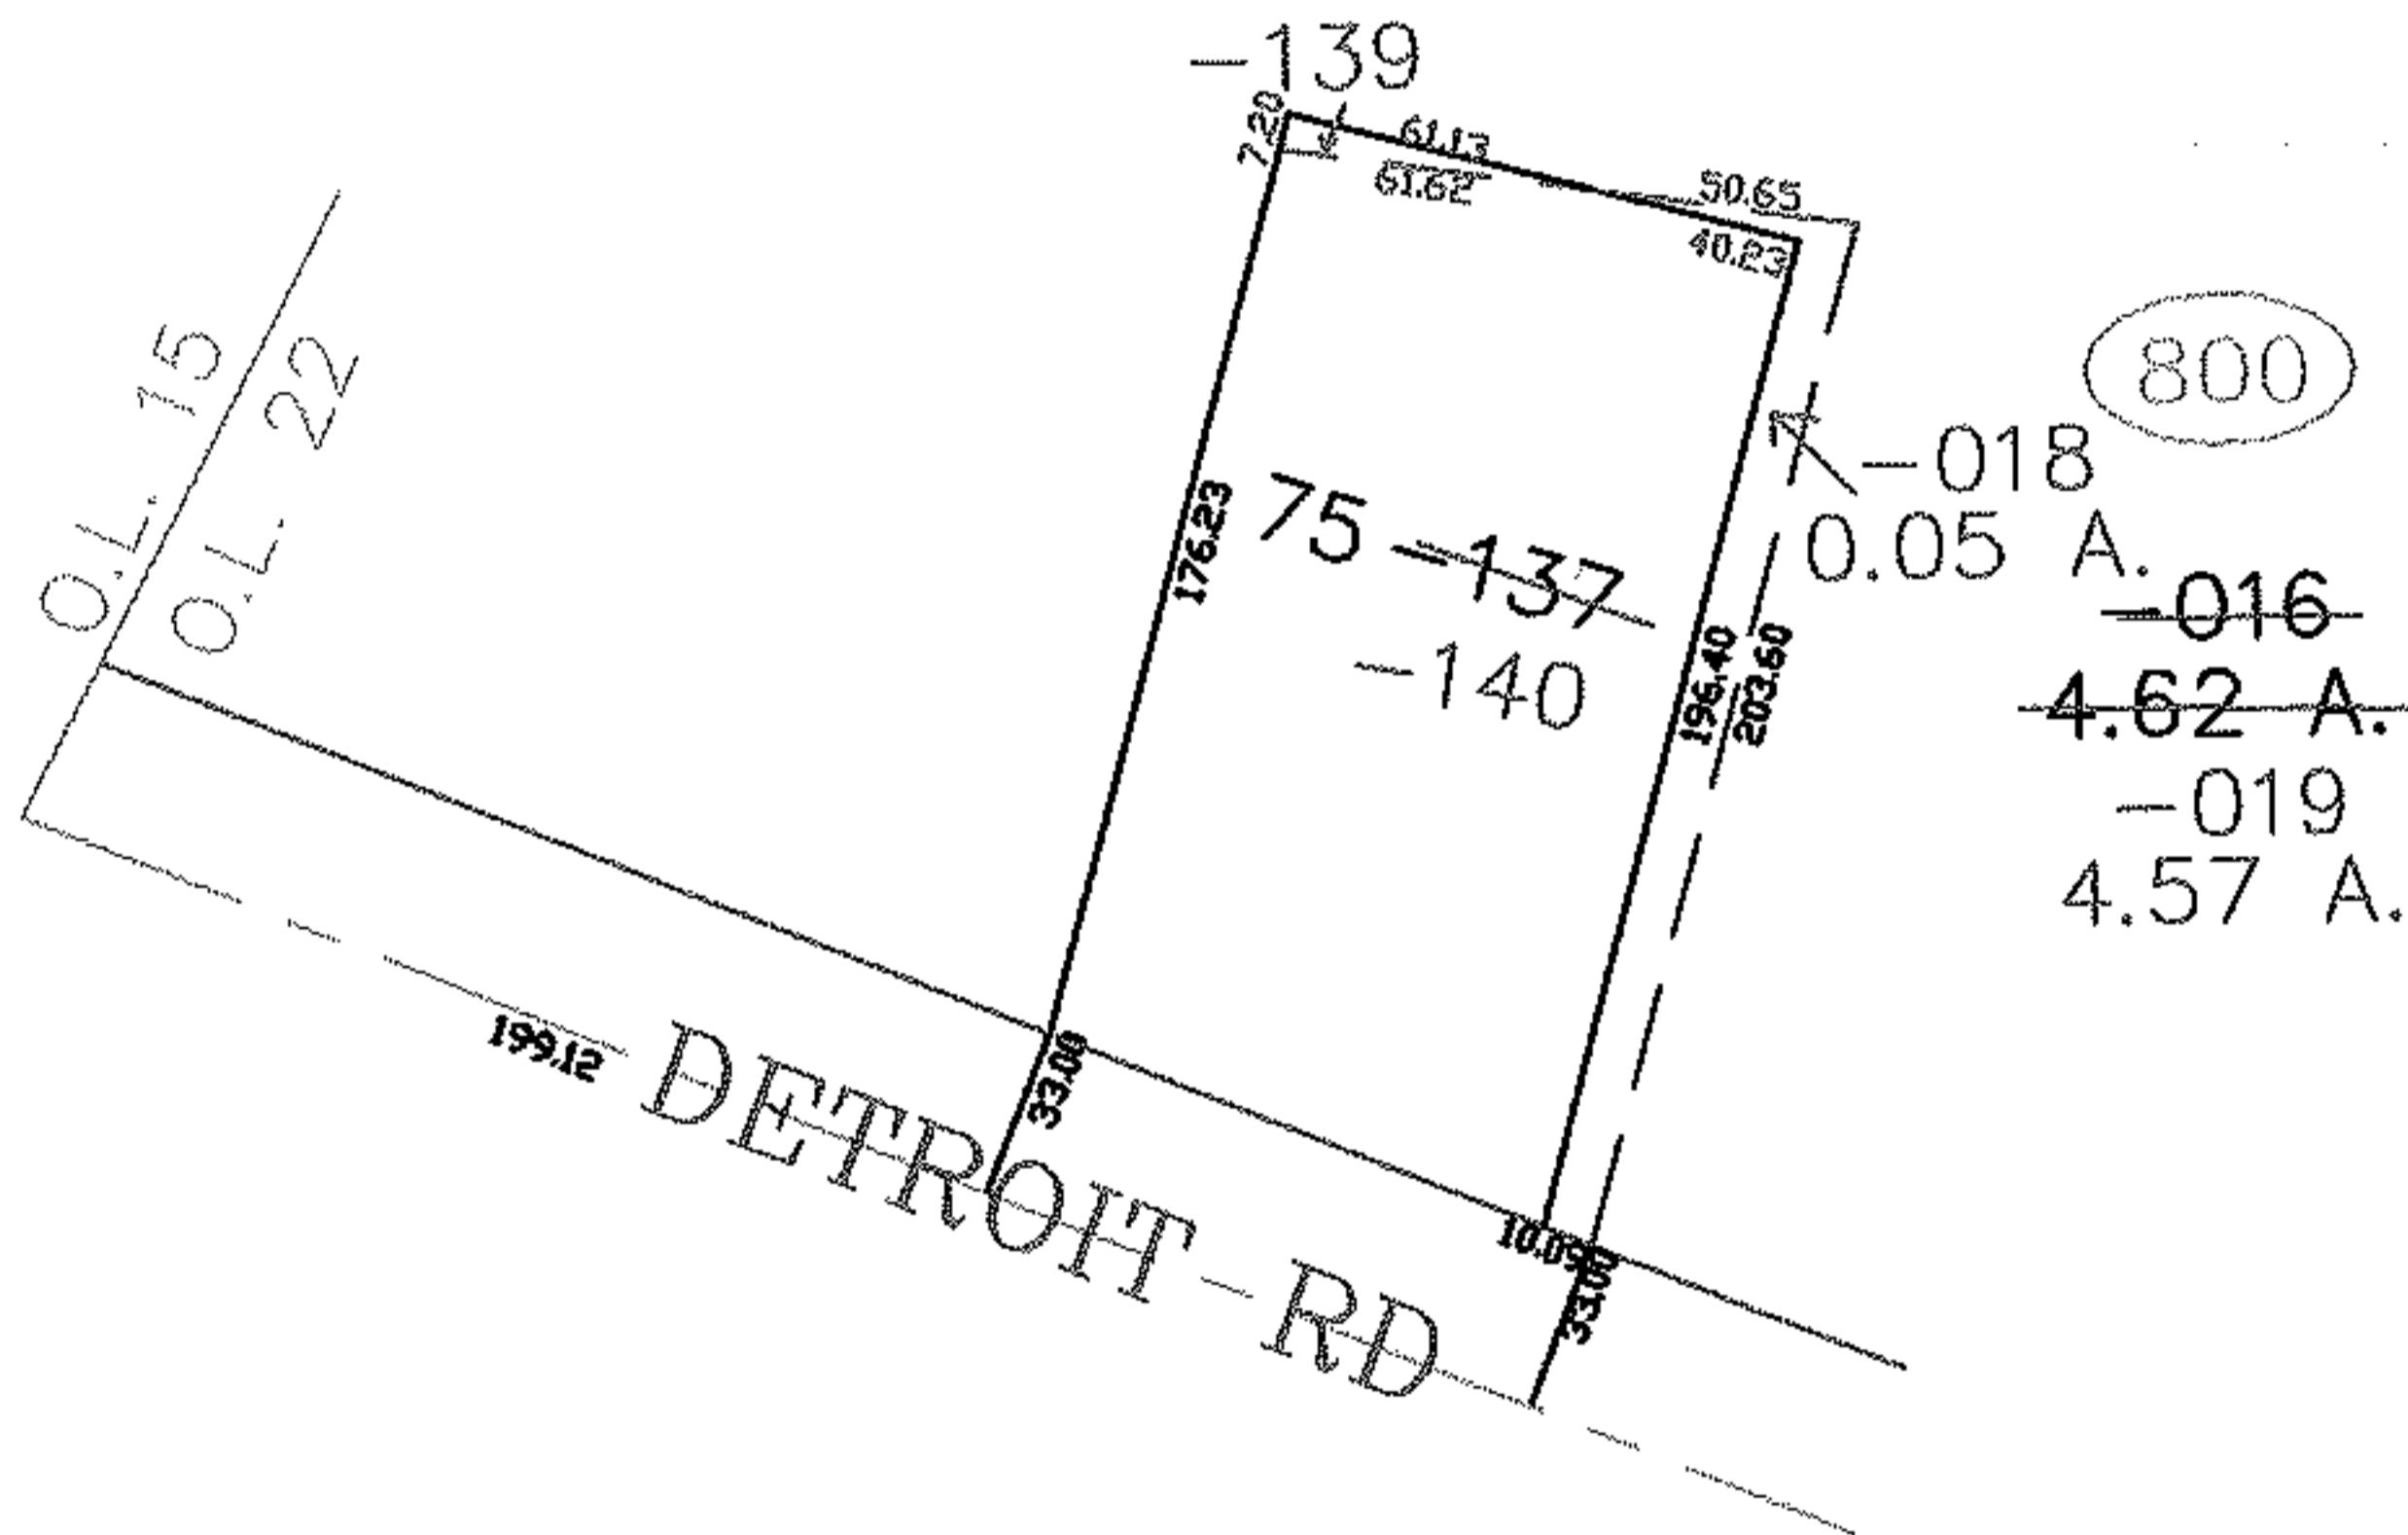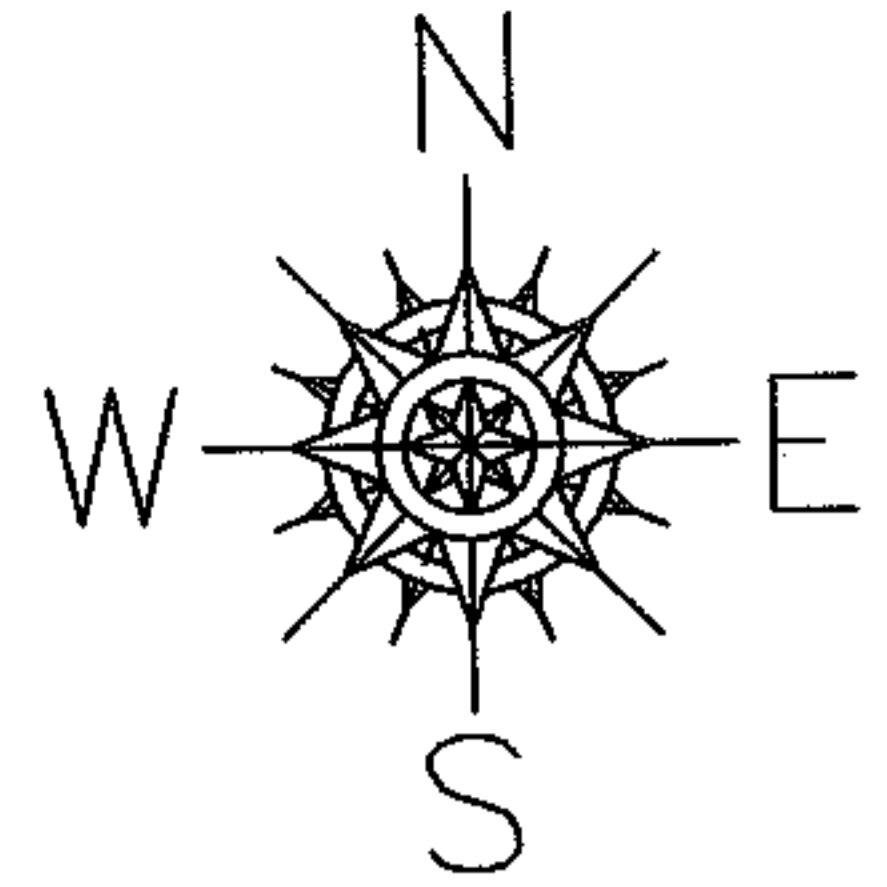

800
 -018
 0.05 A.
 -016
 4.62 A.
 -019
 4.57 A.

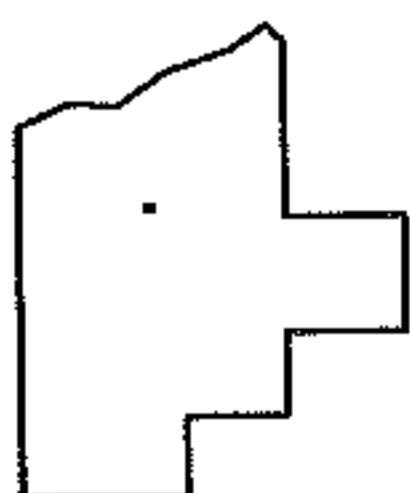

SPLITS/DEEDS PROCESSED

LORAIN COUNTY TAX MAP DEPARTMENT
226 MIDDLE AVE. ELYRIA, OHIO

SURVEYED BY: JOHN HANCOCK

CLOSURE: 0.00 : 10.000

MAP PAGE(S): 04-00-022-A

APPROVED BY: JAH DATE: 1-12-07

SCALE: 1" = 100' PRIOR INSTRUMENT: PL VOL 90/6