
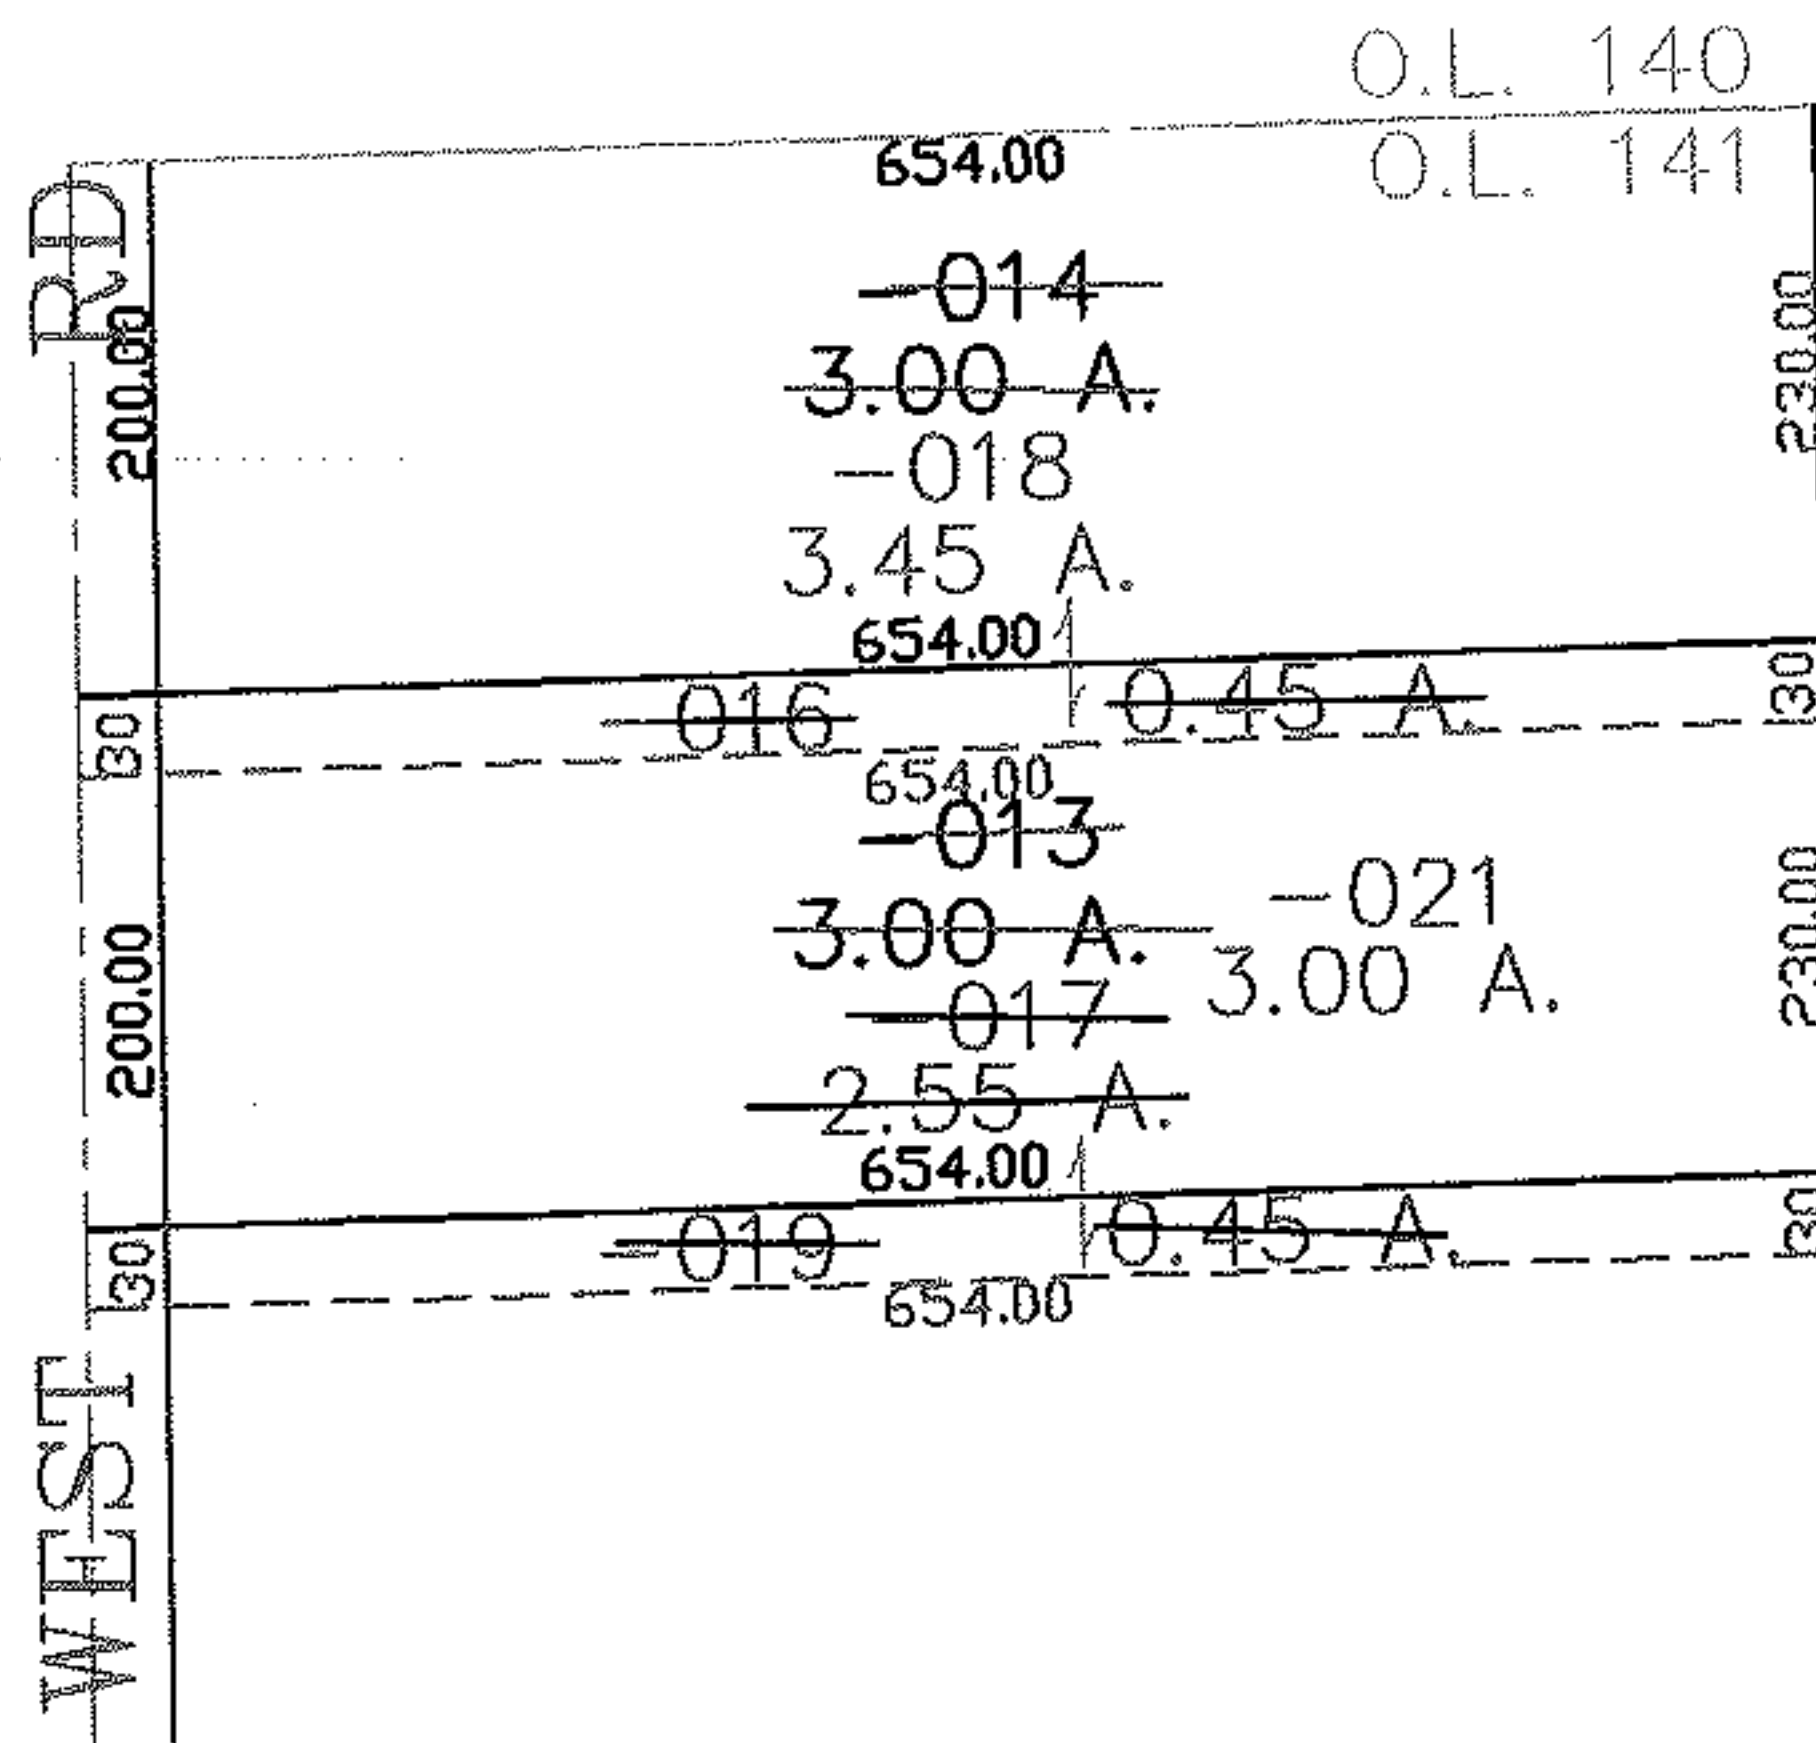


PARENT PARCEL: 14-00-141-000-013, -014, -014


CHILD PARCEL: 14-00-141-016 THRU -021

STARTING POINT: CENTERLINE OF WEST RD & O.L. 141

07-02310

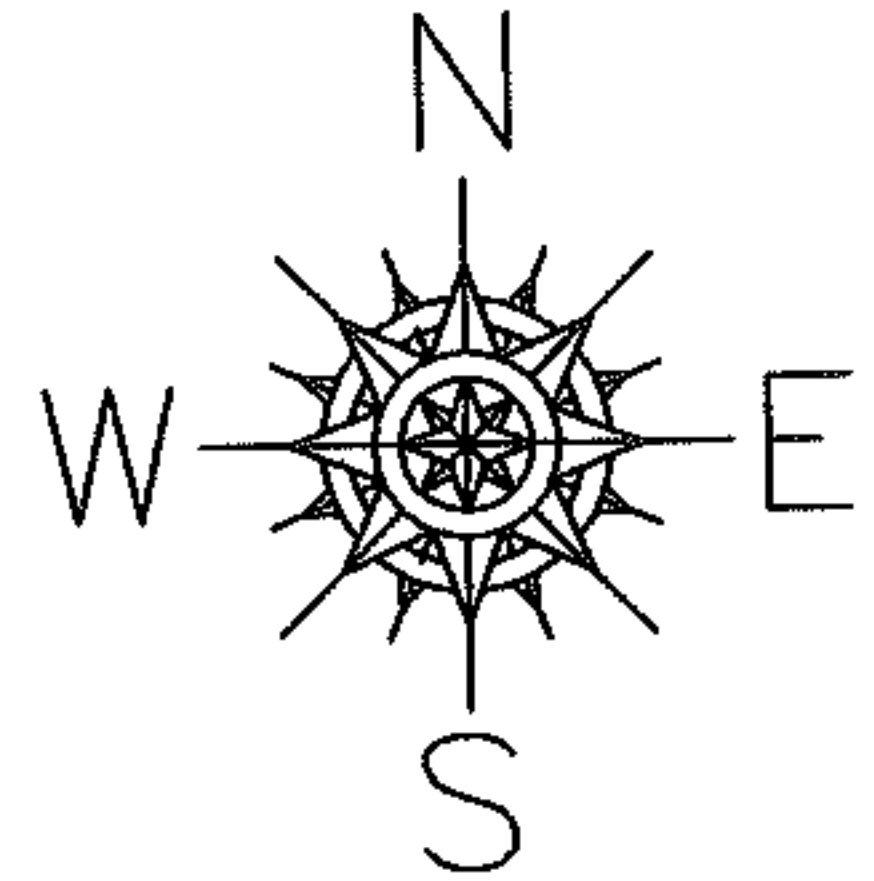

~~-015-~~
~~41.00 A.~~
~~-020~~
~~40.55 A.~~

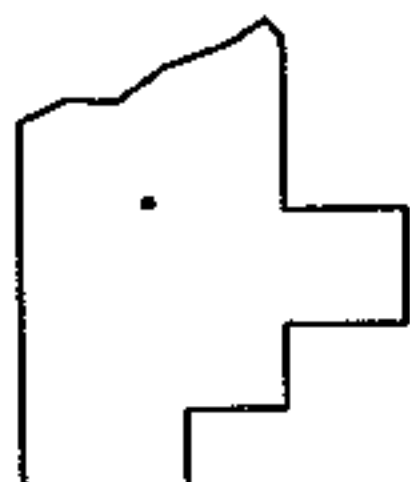

SPLITS/DEEDS PROCESSED
LORAIN COUNTY TAX MAP DEPARTMENT
226 MIDDLE AVE. ELYRIA, OHIO

SURVEYED BY: THOMAS SNEZEK
 CLOSURE: 0.00 : 10.000
 MAP PAGE(S): 14-H
 APPROVED BY: JAH DATE: 1-16-07
 SCALE: 1" = 200 PRIOR INSTRUMENT: 20060151522