




PARENT PARCEL: 15-00-020-000-052, -053  
CHILD PARCEL: 15-00-020-000-054 THRU -056  
STARTING POINT: CENTERLINE OF KIPTON NICKEL PLATE RD & NICKLE PLATE DIAGONAL RD

07-02311

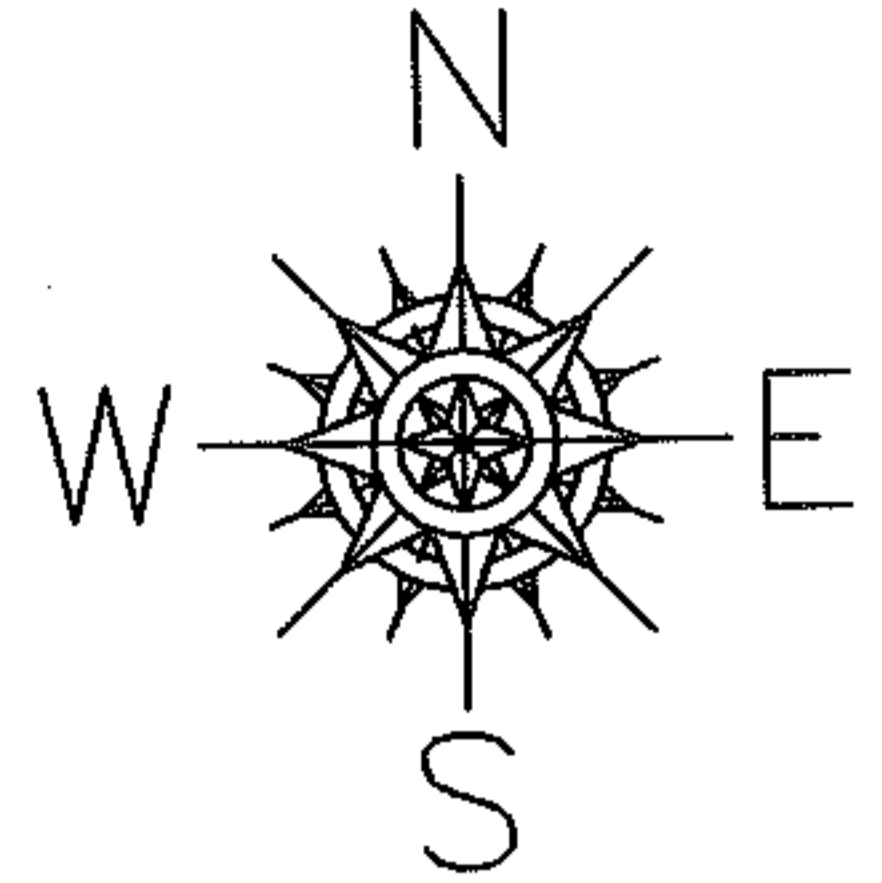

~~KIPTON NICKLE PLATE RD~~

NICKLE PLATE DIAGONAL RD

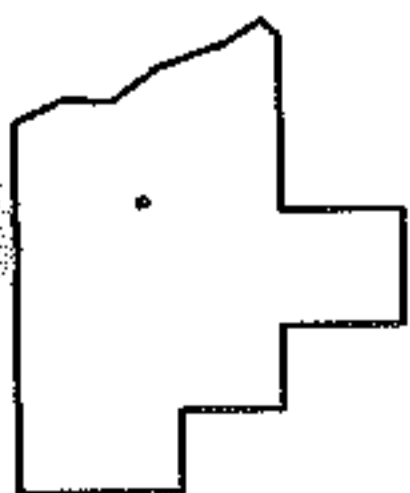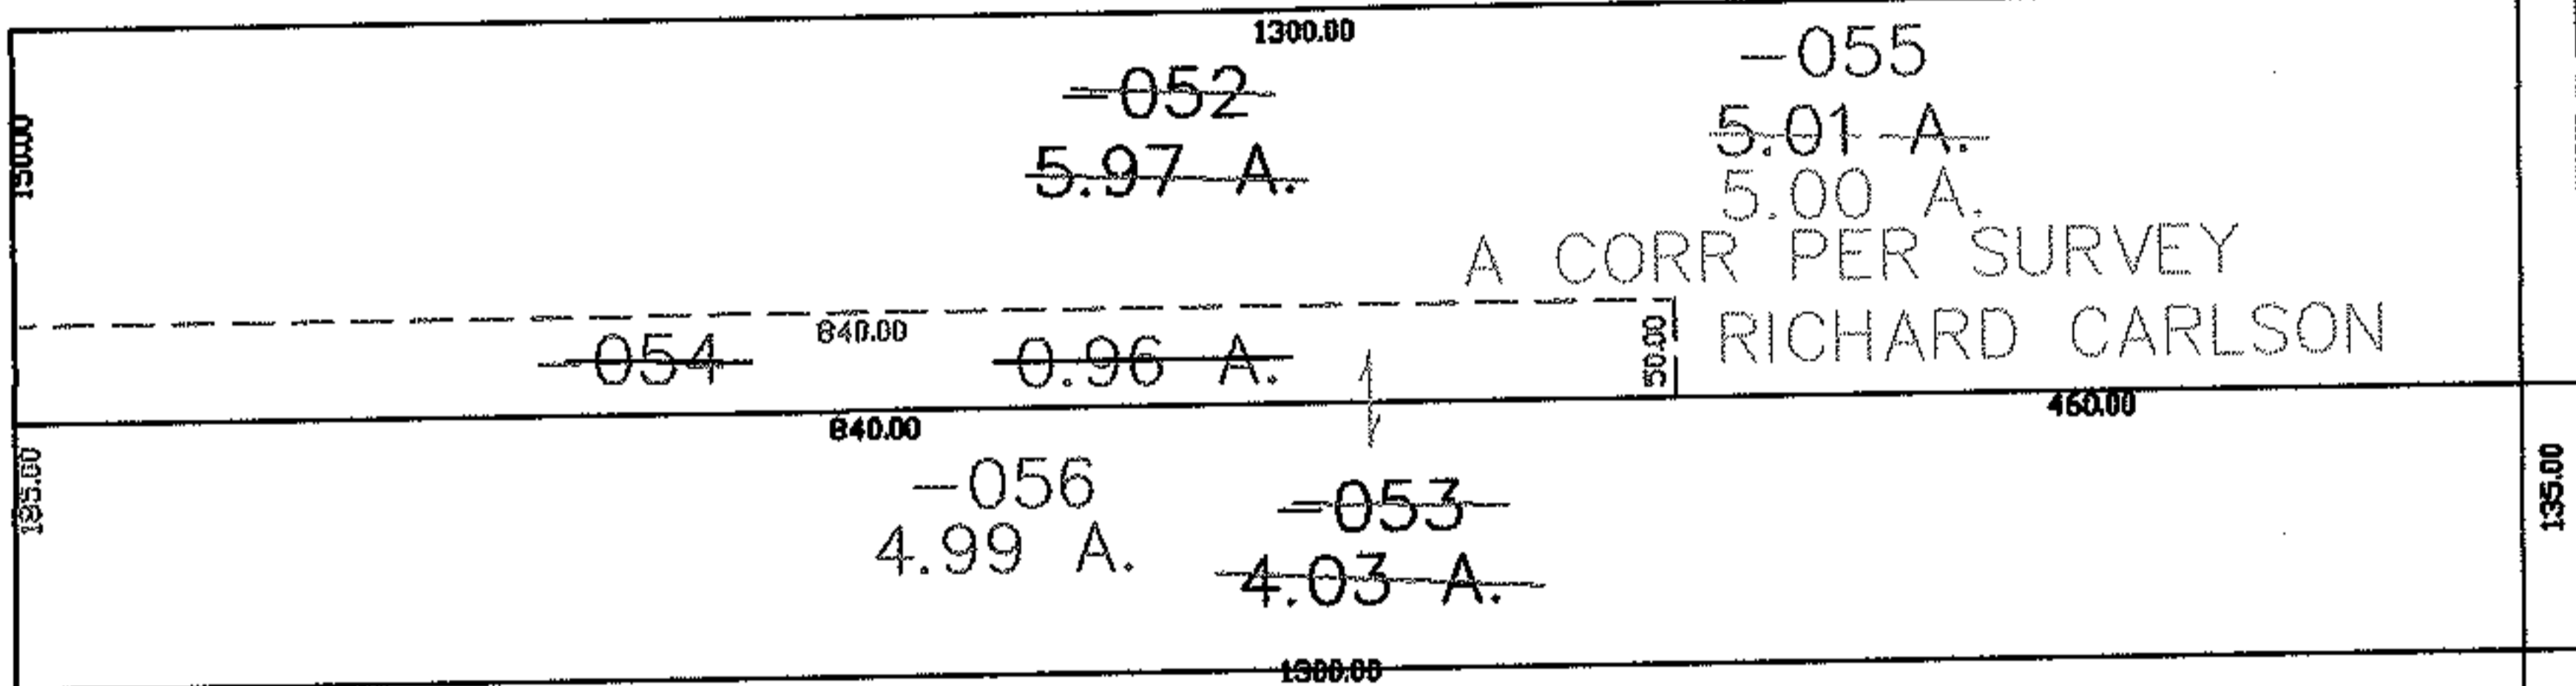

SPLITS/DEEDS PROCESSED  
LORAIN COUNTY TAX MAP DEPARTMENT  
226 MIDDLE AVE. ELYRIA, OHIO

SURVEYED BY: RICHARD CARLSON  
CLOSURE: 0.00 : 10.000  
MAP PAGE(S): 15-00-020-B  
APPROVED BY: JAH DATE: 1-16-07  
SCALE: 1" = 200 PRIOR INSTRUMENT: 20020861982