


RASTER

PARENT PARCEL: 05-00-079-000-060
CHILD PARCEL: XX-XX-XXX-XXX-XXX
STARTING POINT: MON. BOX, CL OF MIDDLE RIDGE RD. & SOUTH LINE OF O.L. 79

11-02312-A

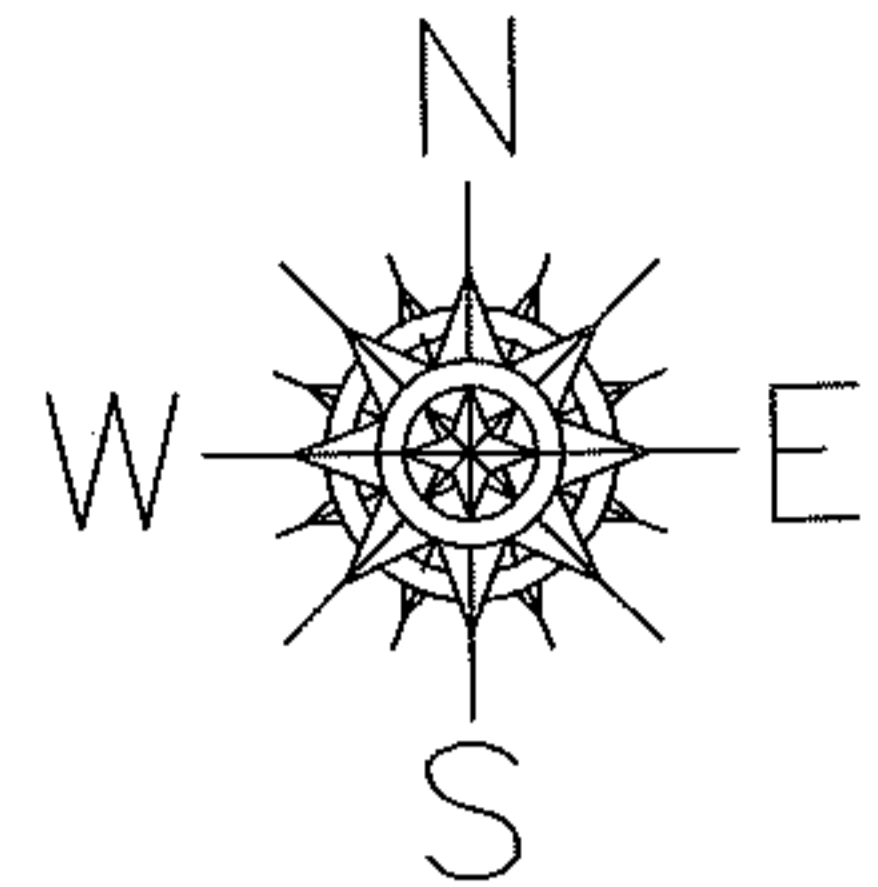



ACREAGE CORRECTION

05-00-079-000-060

~~0.56 A.~~

0.55 A.

AC. CORR. PER SURV.
DALE HAYWOOD

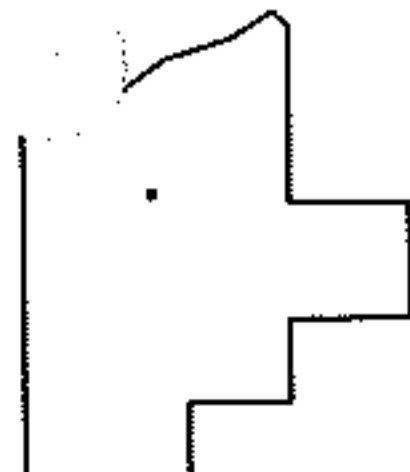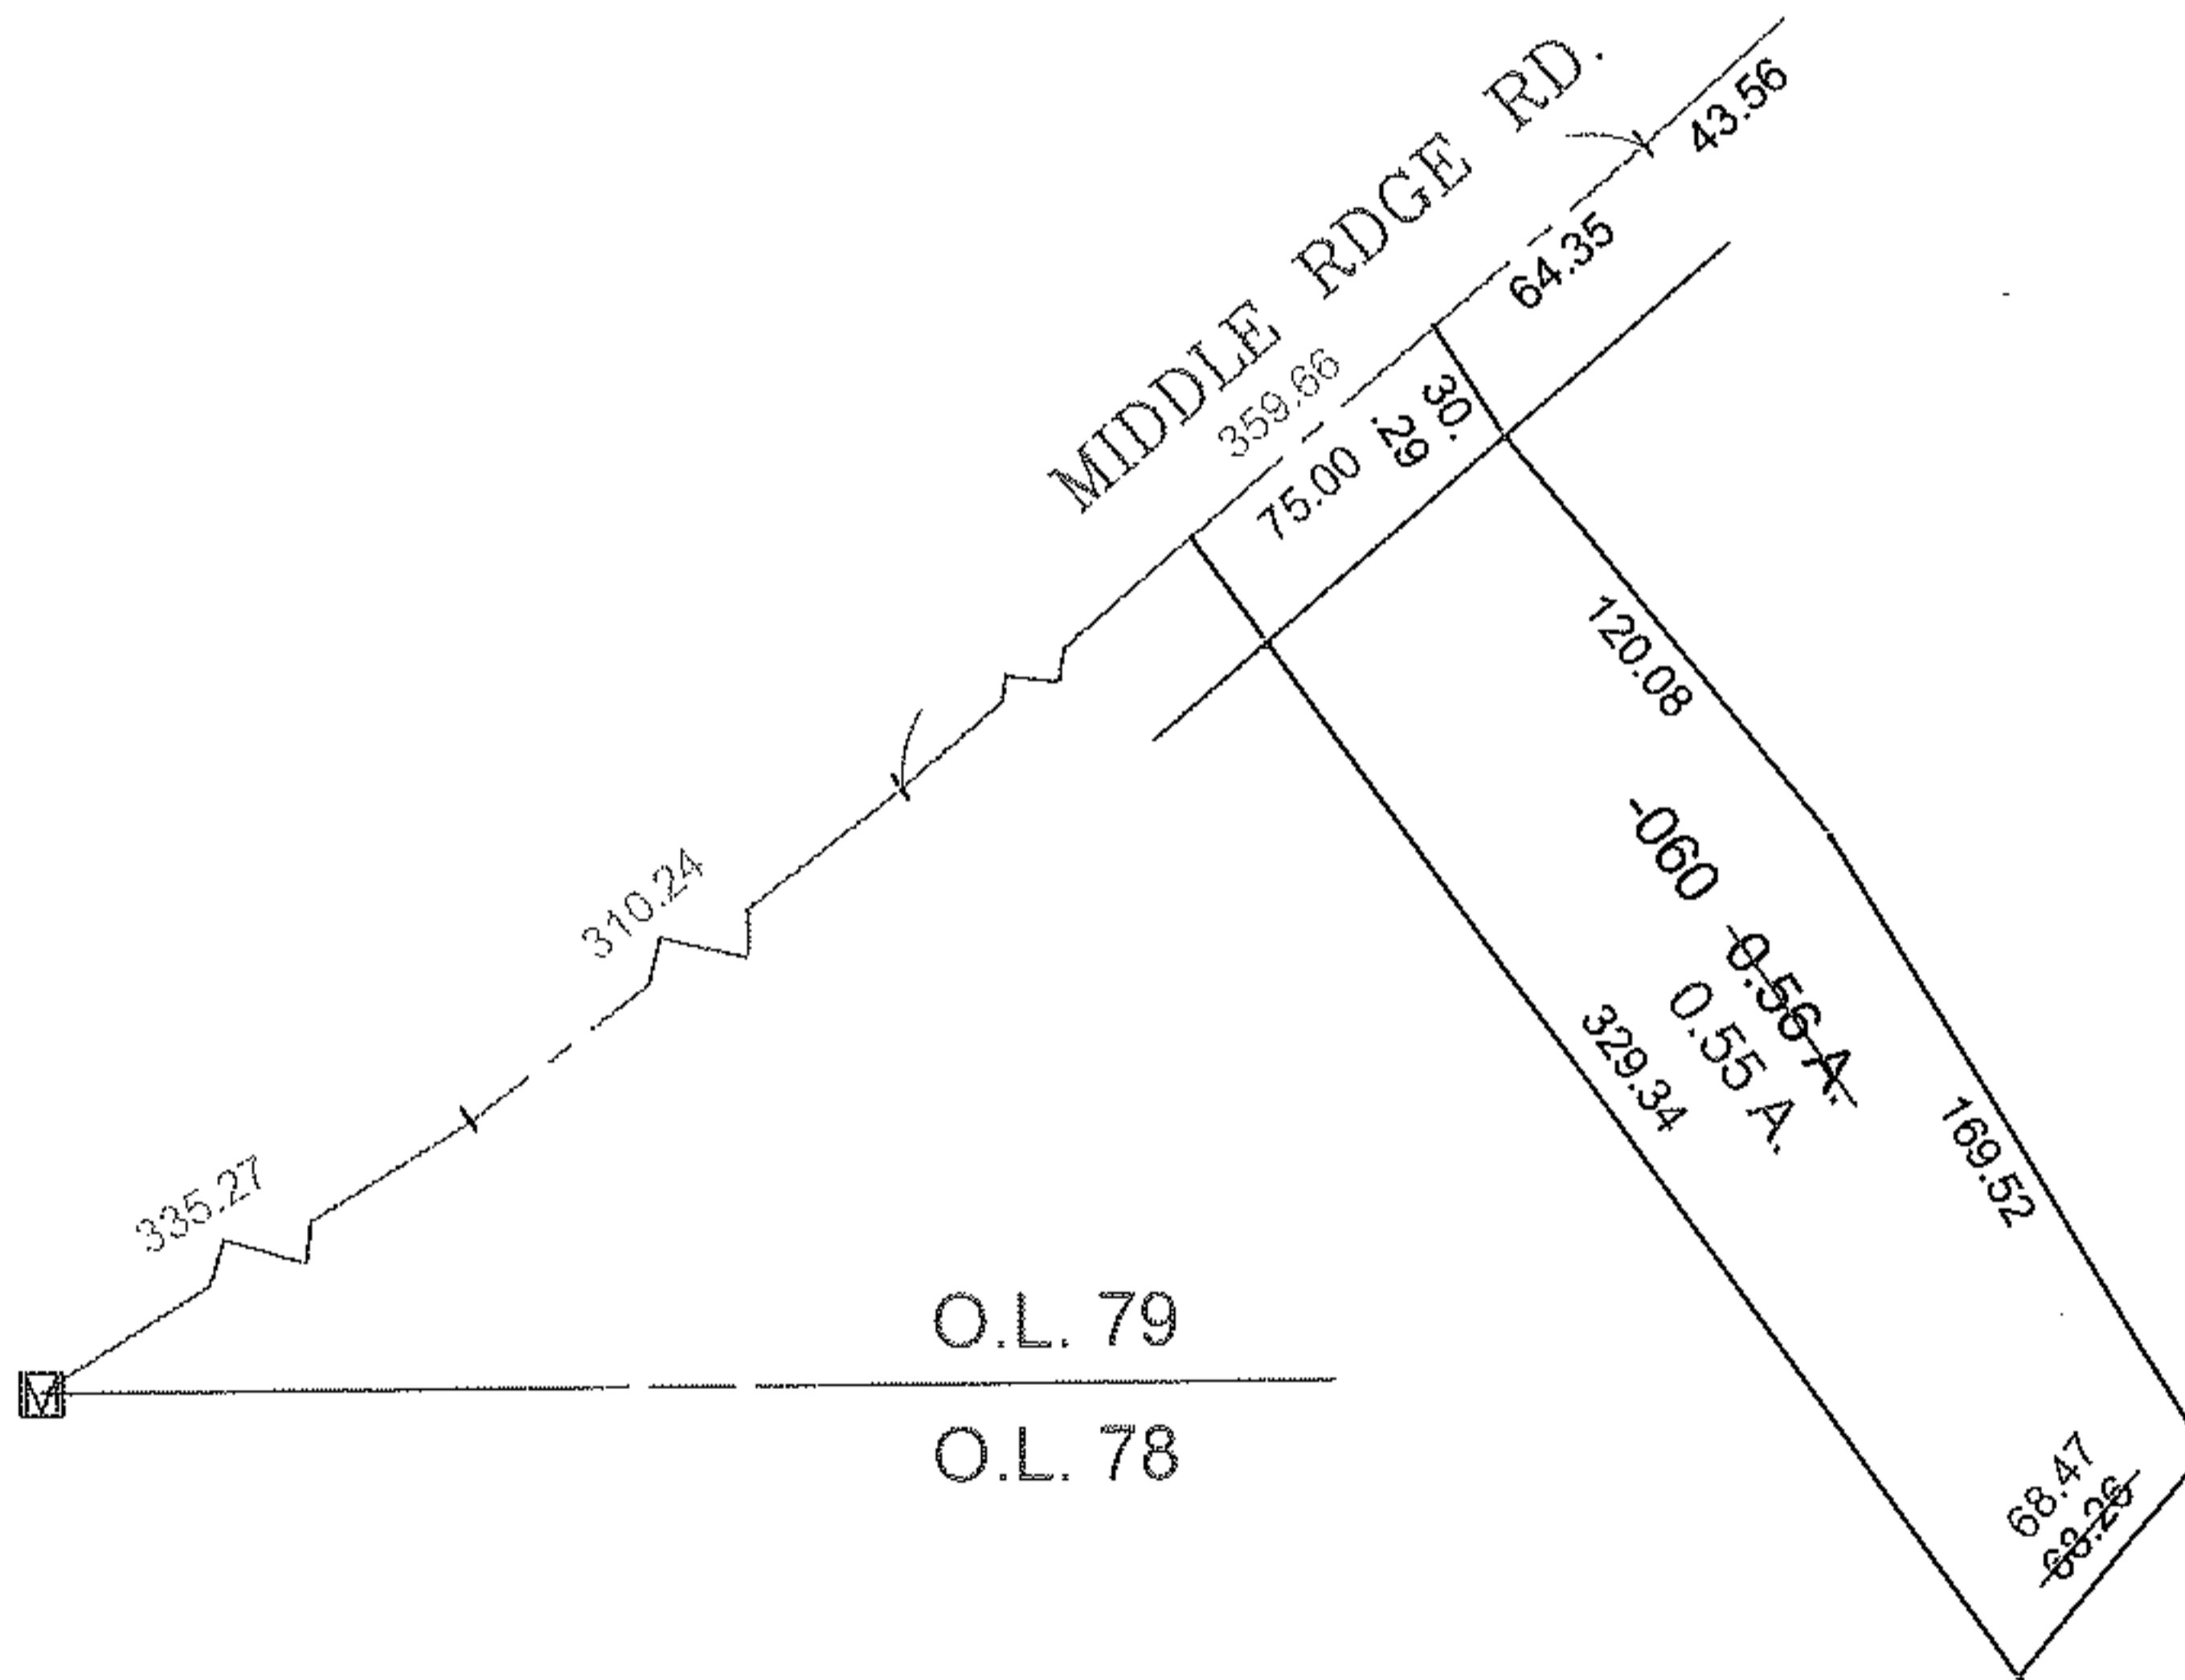

SPLITS/DEEDS PROCESSED
LORAIN COUNTY TAX MAP DEPARTMENT
226 MIDDLE AVE. ELYRIA, OHIO

SURVEYED BY: DALE HAYWOOD
CLOSURE: 1: 34500
MAP PAGE(S): 5-00-079-B
APPROVED BY: TJS DATE: 6/24/11
SCALE: 1"= 100 PRIOR INST.: 20110365775