

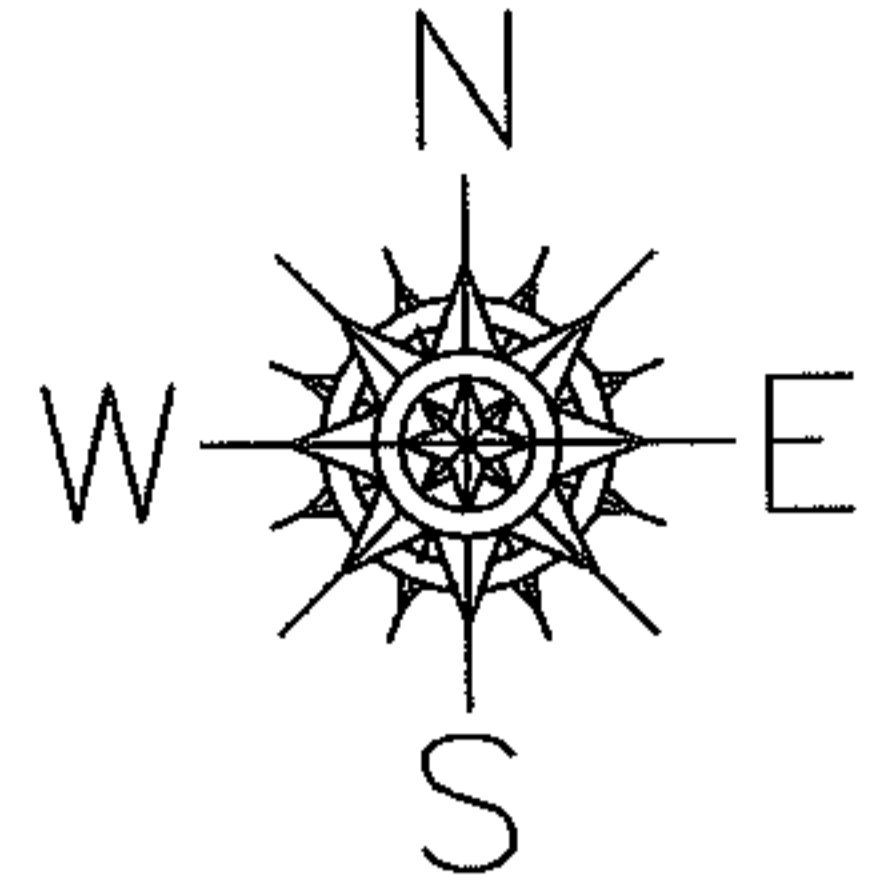


PARENT PARCEL: 04-00-004-102-176  
CHILD PARCEL: 04-00-004-102-180, -181  
STARTING POINT: SIDELINE OF CHESTER RD & SW CORNER OF CHESTER INDUT PK SUB

07-02312

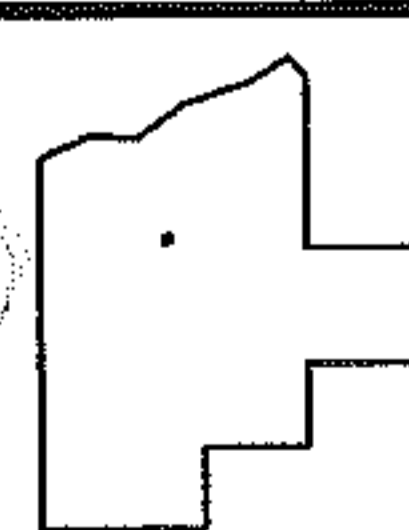

CHESTER INDUST. PK SUB  
VOL 48 PG 16

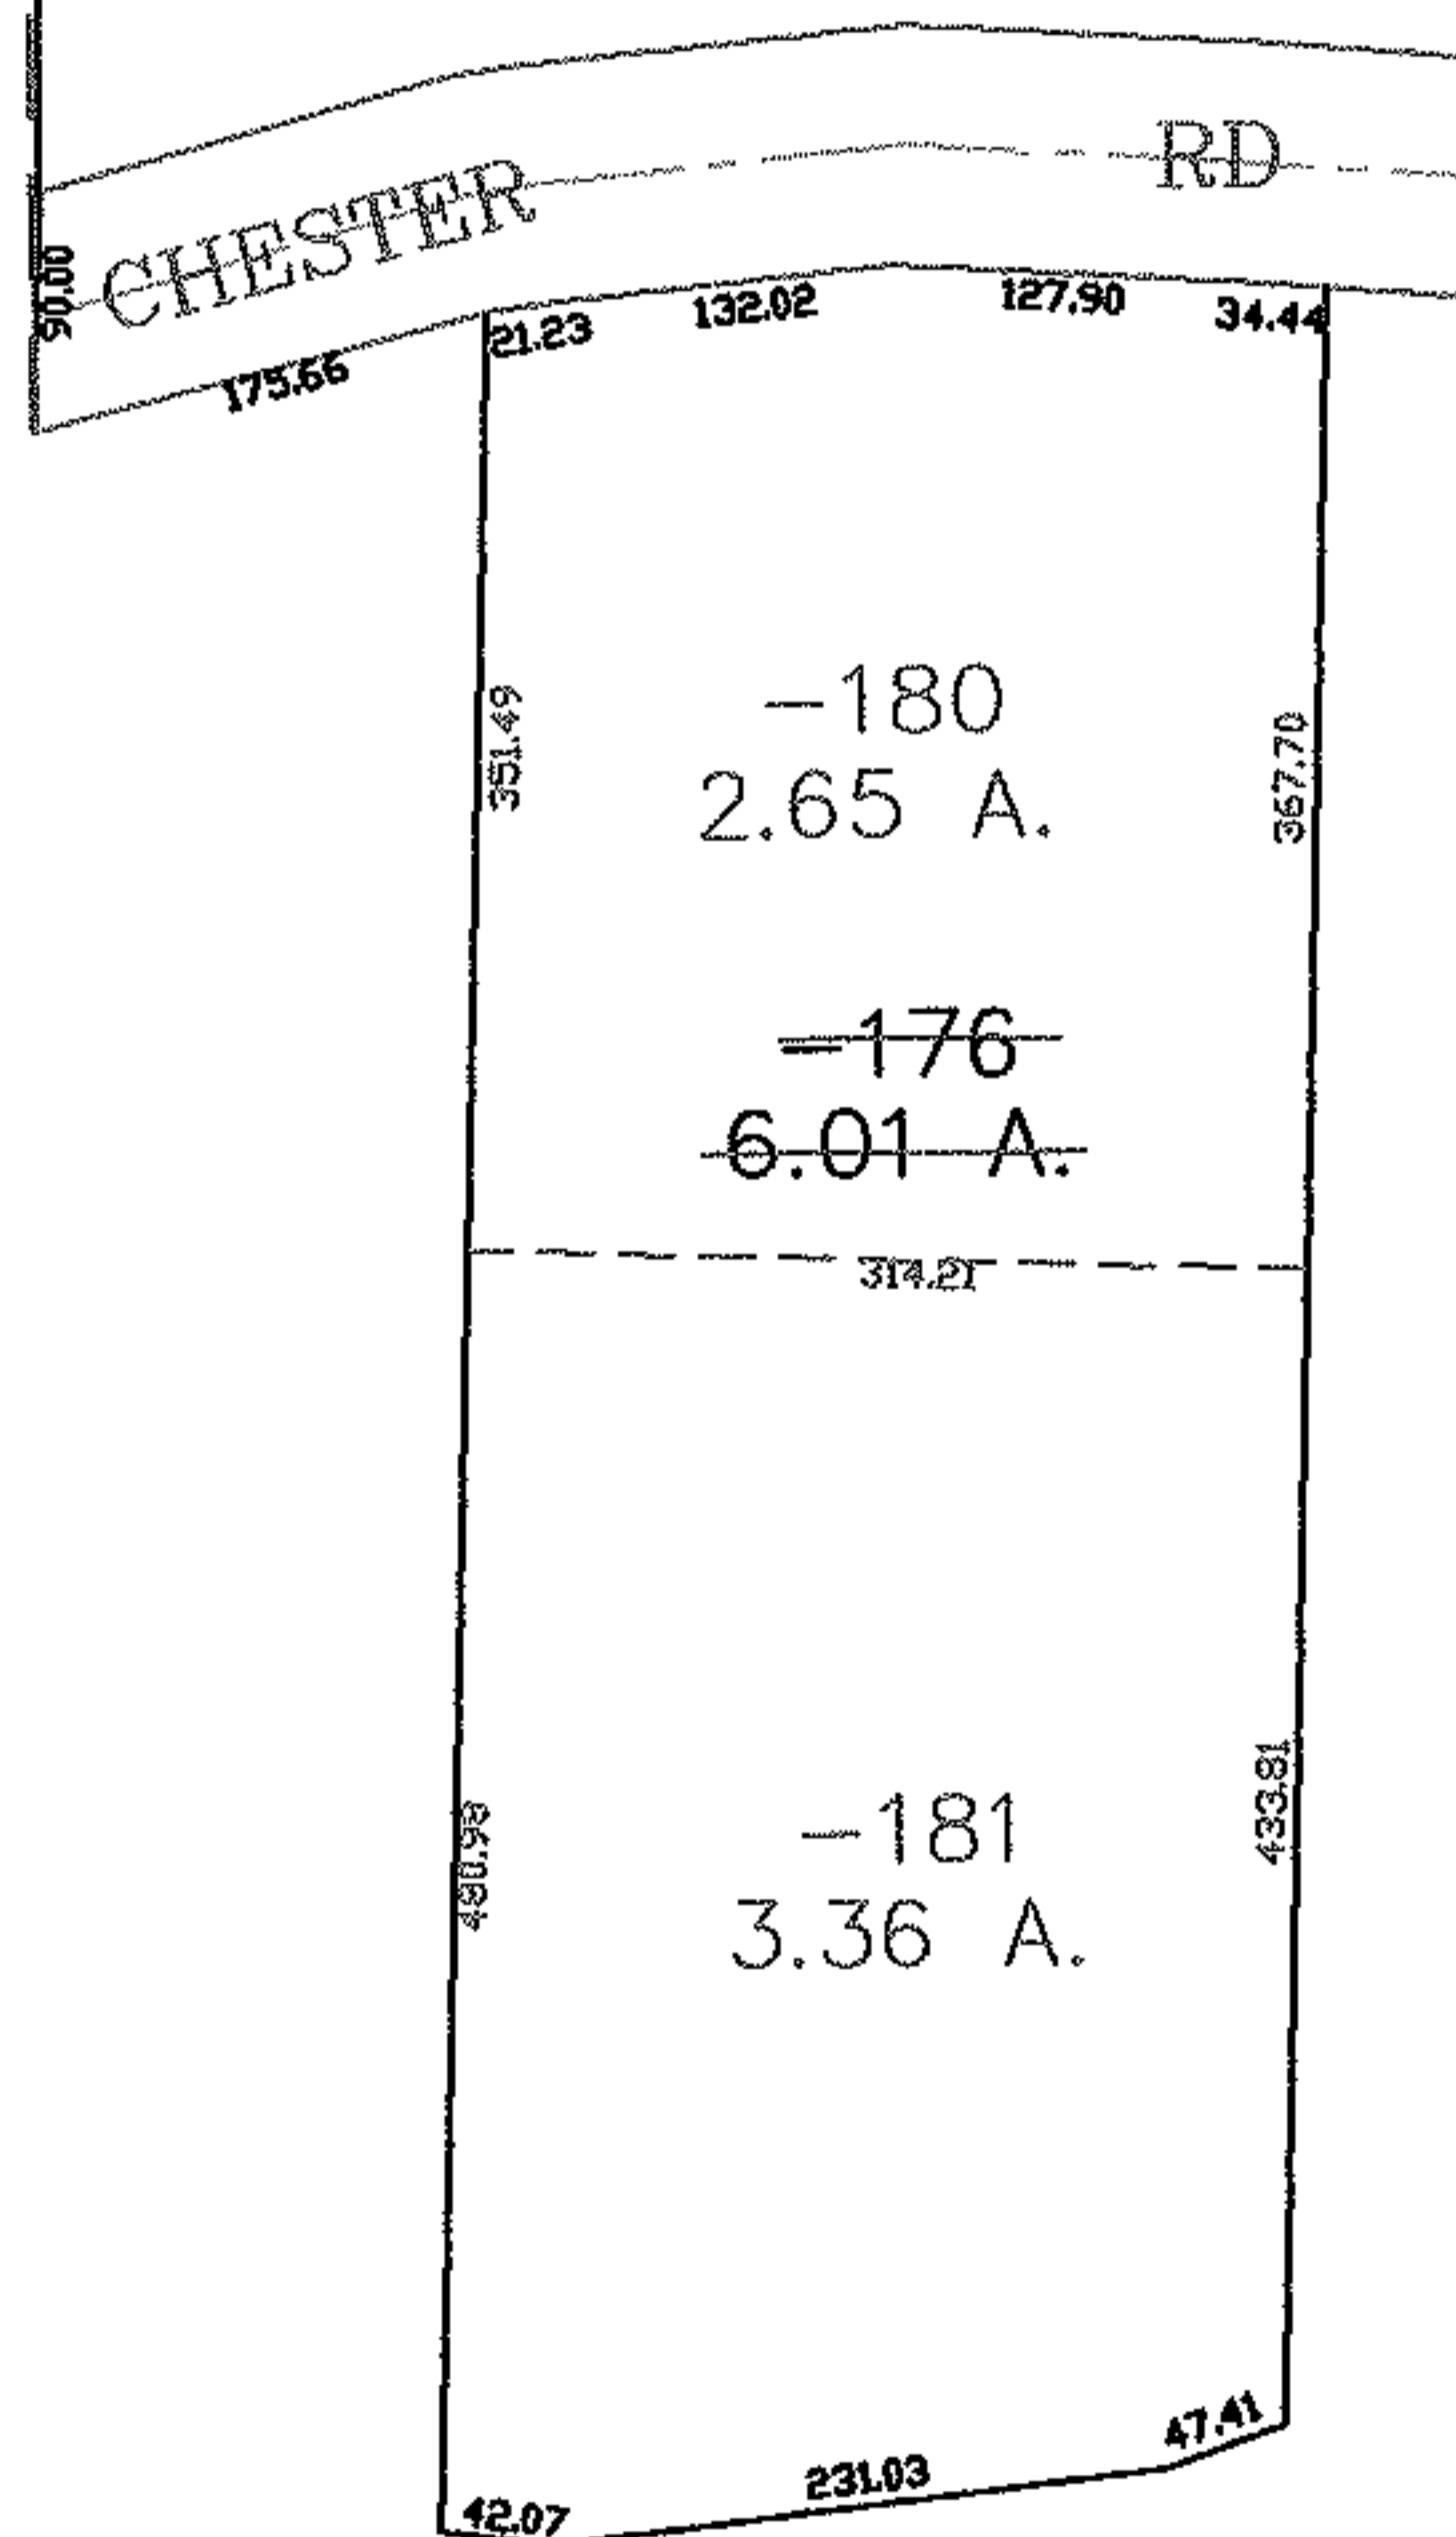

**SPLITS/DEEDS PROCESSED**  
LORAIN COUNTY TAX MAP DEPARTMENT  
226 MIDDLE AVE. ELYRIA, OHIO

SURVEYED BY: DALE HAYWOOD  
CLOSURE: 0.00 : 10.000  
MAP PAGE(S): 04-00-004-G  
APPROVED BY: JAH DATE: 1-17-07  
SCALE: 1" = 200 PRIOR INSTRUMENT: 20020817946