

RASTER

PARENT PARCEL: 05-00-030-000-044

CHILD PARCEL: 05-00-030-000-043

STARTING POINT: XXXXXX


11-02313-C

DROP FROM DUPLICATE


05-00-030-000-044  
0.97 A.

ADD TO DUPLICATE

05-00-030-000-043  
0.97 A.

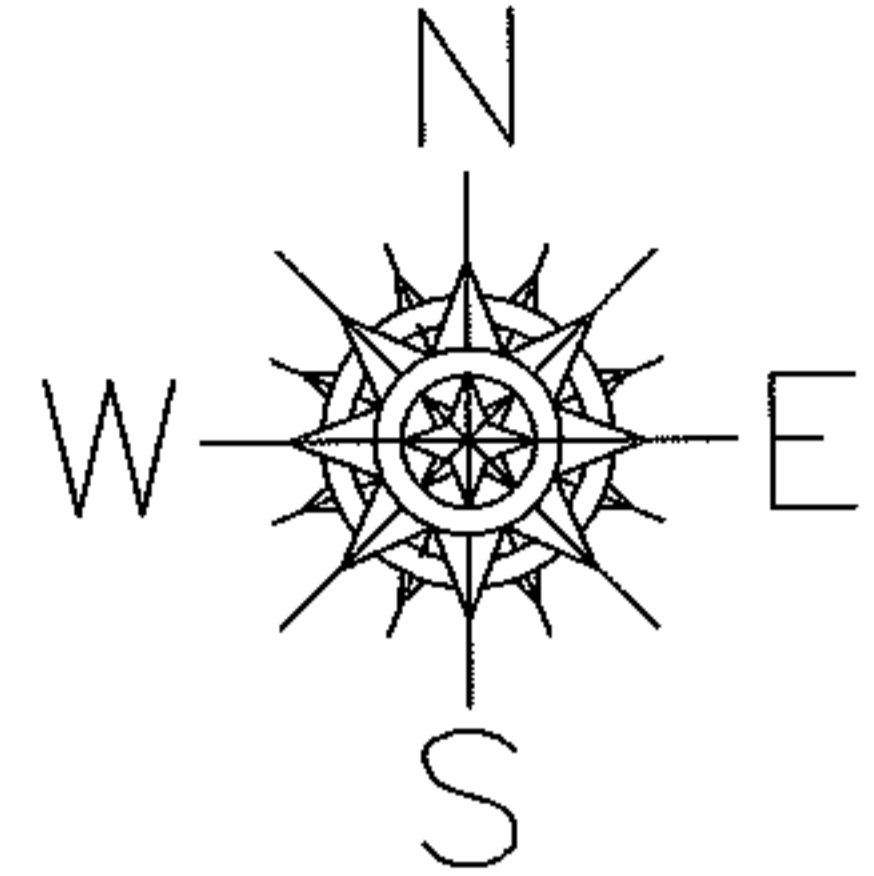

CORRECTING SPLIT #18357

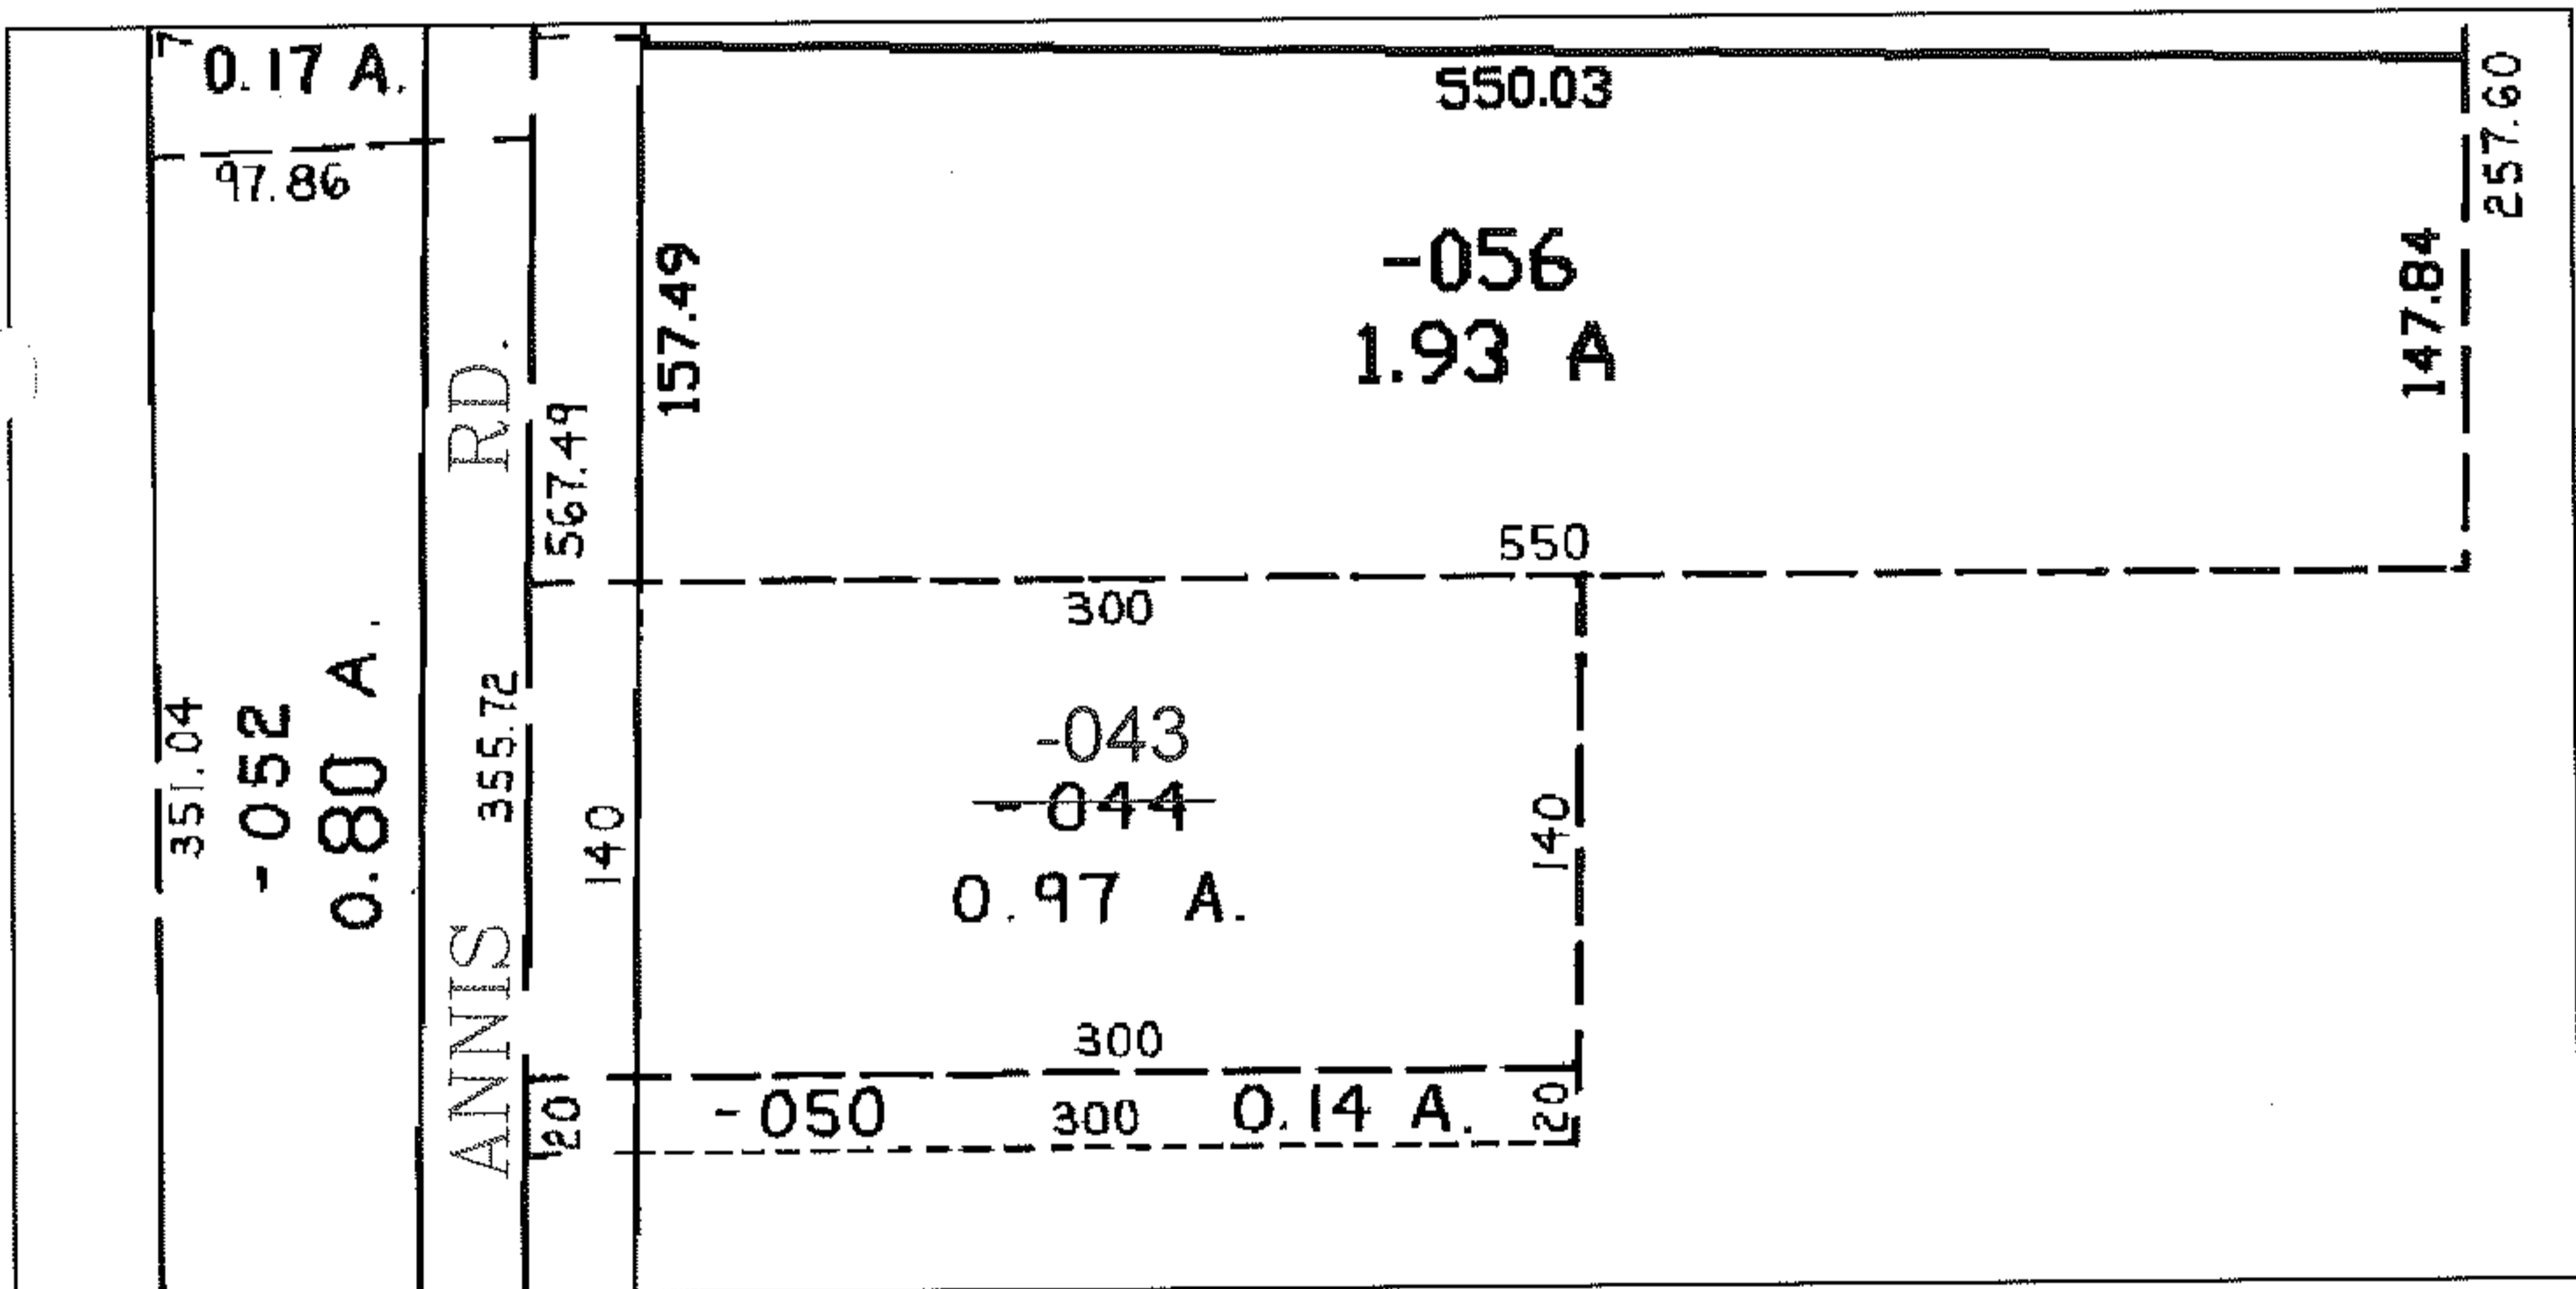

SPLITS/DEEDS PROCESSED

LORAIN COUNTY TAX MAP DEPARTMENT  
226 MIDDLE AVE. ELYRIA, OHIO

SURVEYED BY: NONE

CLOSURE: NONE

MAP PAGE(S): 5-00-030-A

APPROVED BY: TJS DATE: 6/27/11

SCALE: 1"= 100 PRIOR INST.: NA