


PARENT PARCEL: 11-00-074-000-033, -032
CHILD PARCEL: 11-00-074-000-091 THRU -093
STARTING POINT: CENTERLINE OF DURKEE RD & GILES RD

07-02314

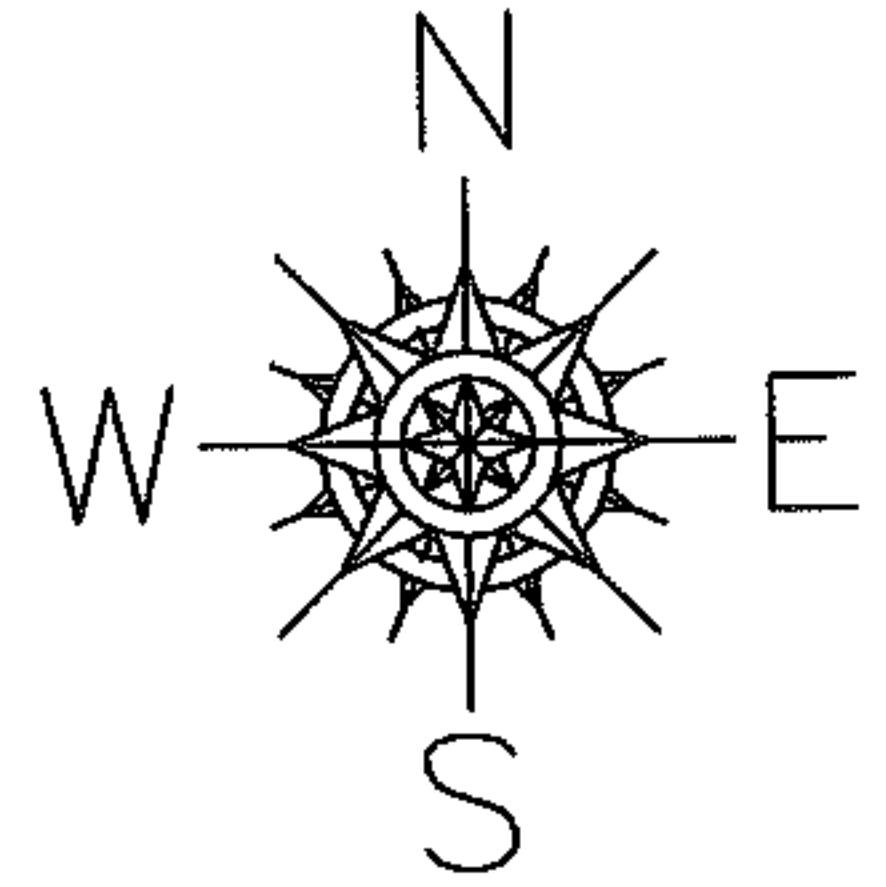


DURKEE RD

GILES 453.95

422.08
~~-033~~
~~1.66 A.~~
A CORR PER SURVEY
RICHARD CARLSON
-092
1.45 A.
1.48 A.
A CORR PER SURVEY
RICHARD CARLSON
218.85
~~-032~~
~~1.32 A.~~
~~-093~~
1.53 A.
1.52 A.
A CORR PER SURVEY
RICHARD CARLSON

RD

SURVEYED BY: RICHARD CARLSON
CLOSURE: 0.00 : 10.000
MAP PAGE(S): 11-00-074-A
APPROVED BY: JAH DATE: 1-29-07
SCALE: 1" = 200 PRIOR INSTRUMENT: 20060161590

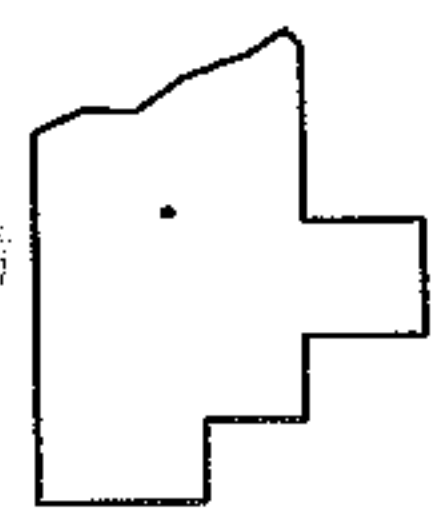

SPLITS/DEEDS PROCESSED
LORAIN COUNTY TAX MAP DEPARTMENT
226 MIDDLE AVE. ELYRIA, OHIO