
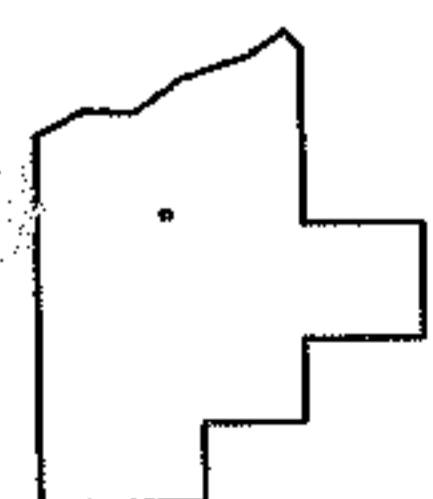
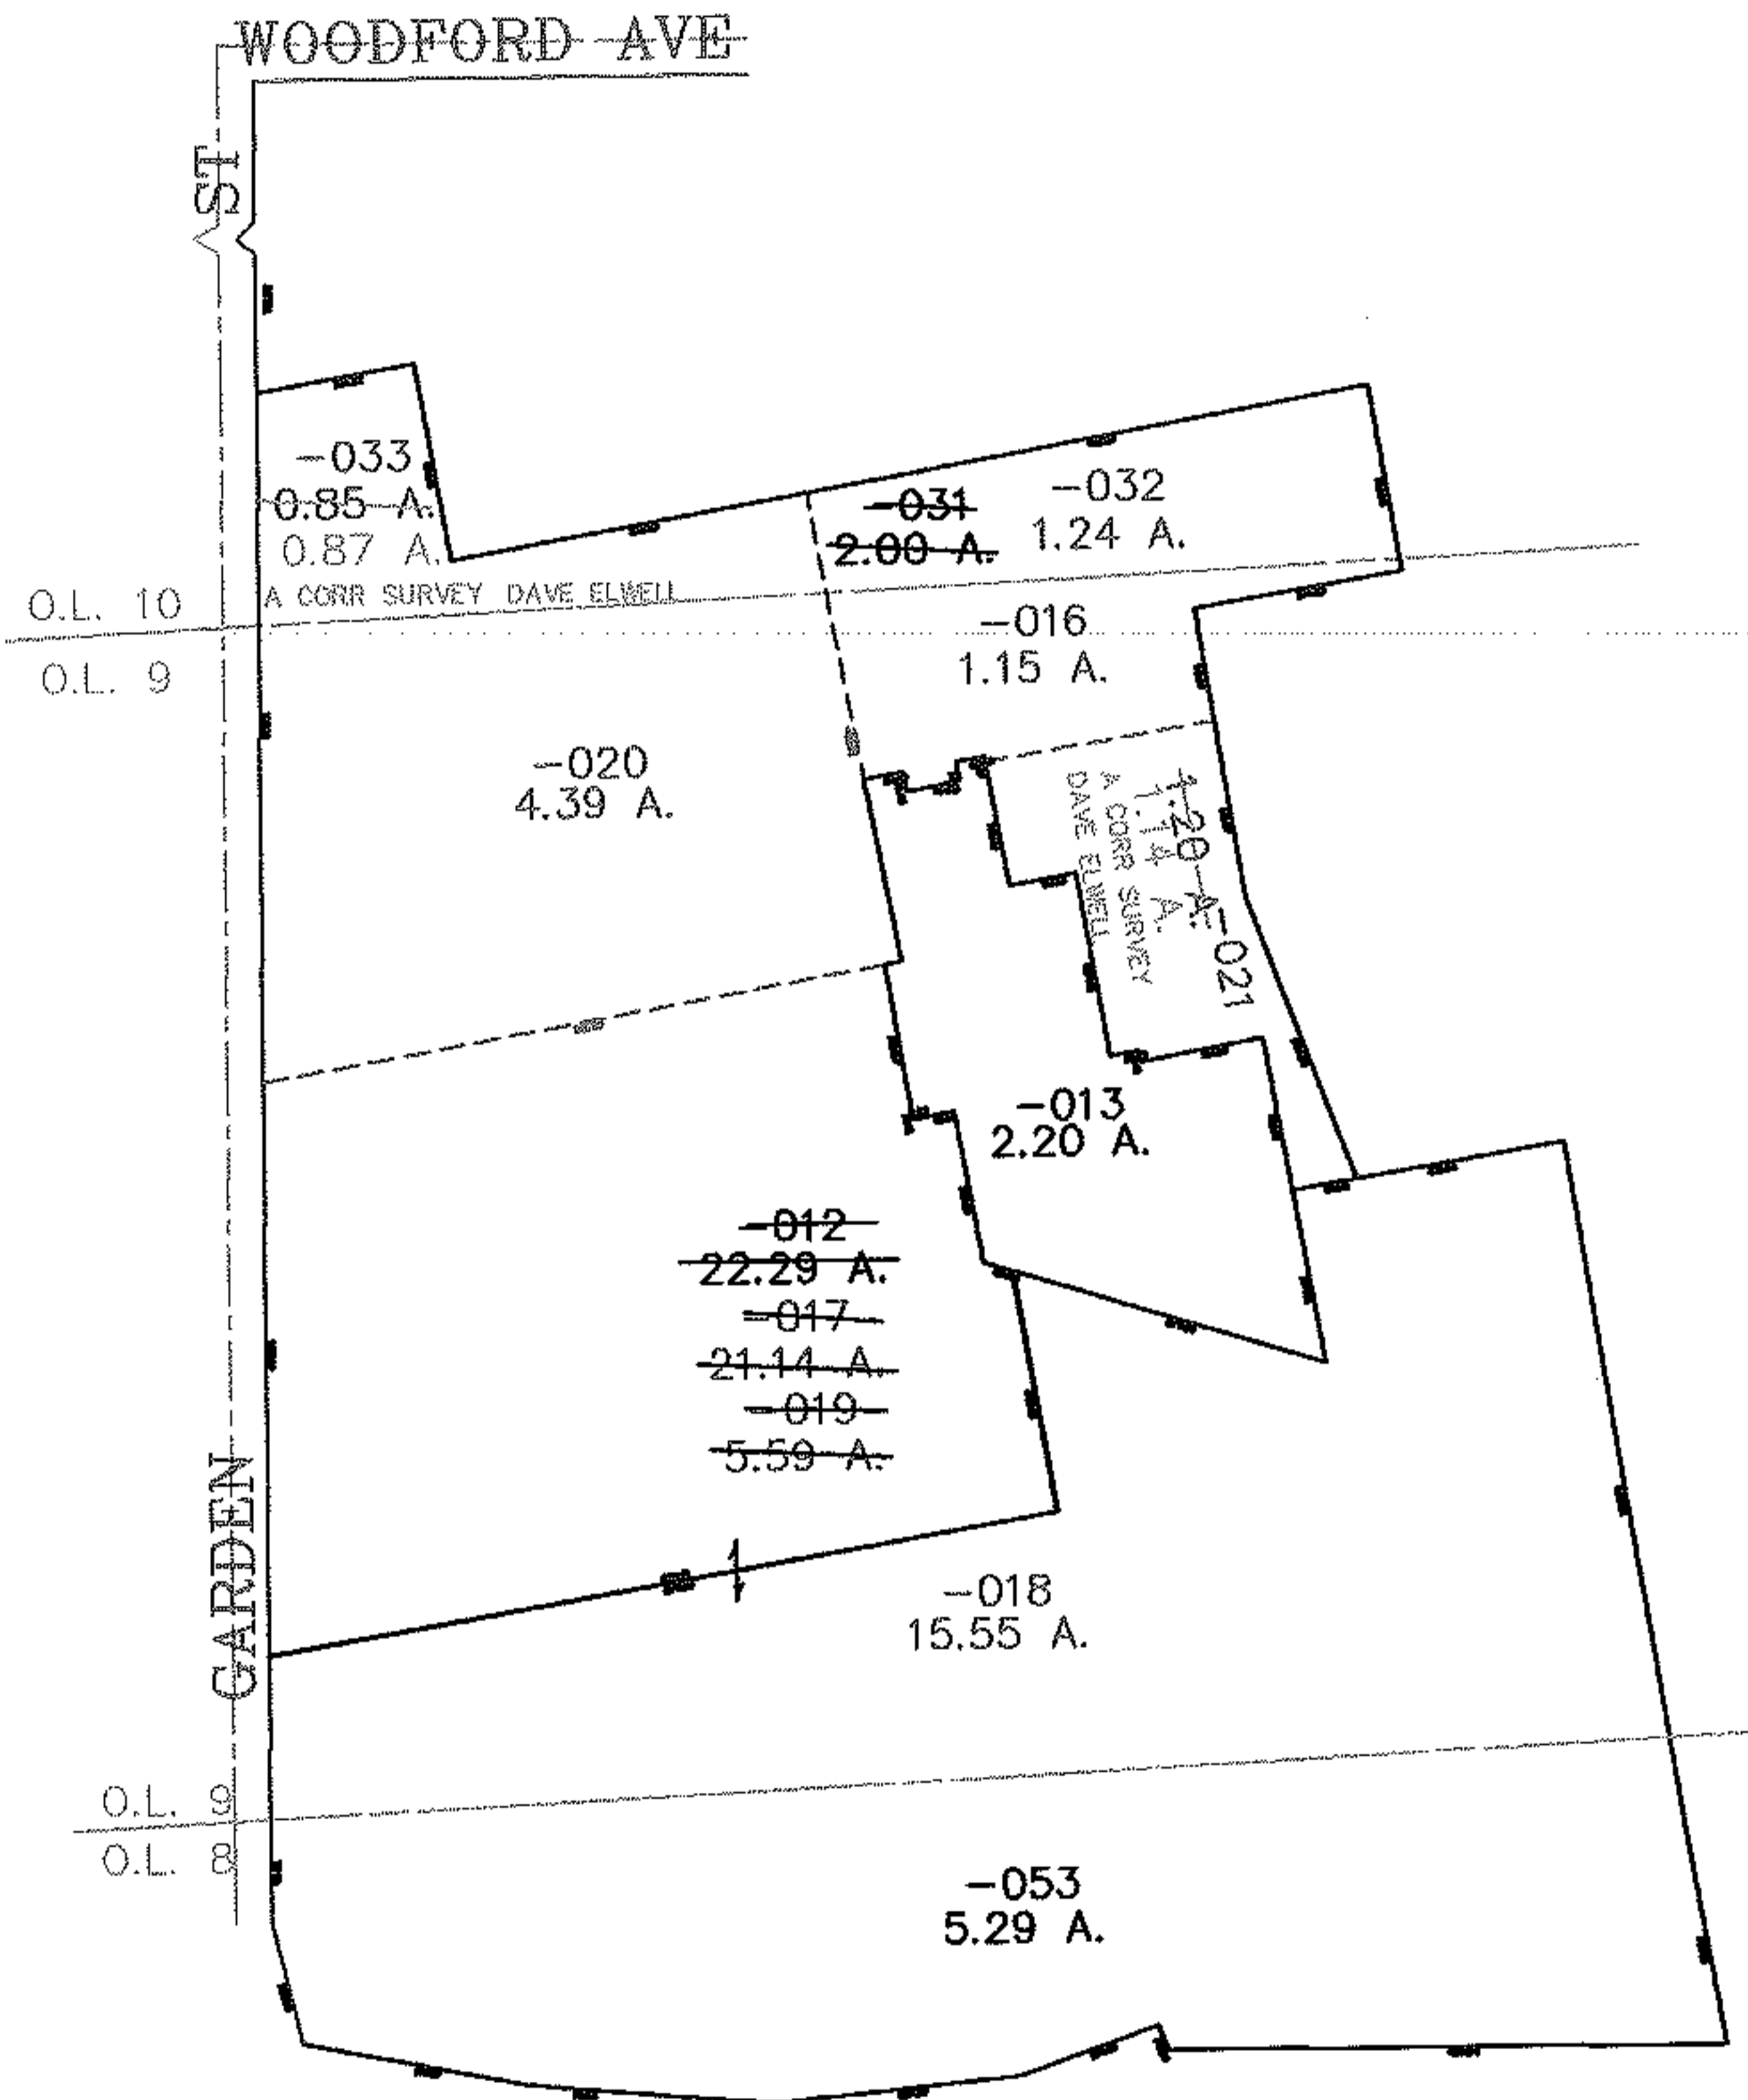


PARENT PARCEL: 06-24-009-102-012, 06-24-010-102-031
 CHILD PARCEL: 06-24-009-102-016 THRU 06-24-009-102-021 06-24-010-102-032, -033
 STARTING POINT: EASTERLY LINE OF GARDEN ST & O.L. 9

07-02317

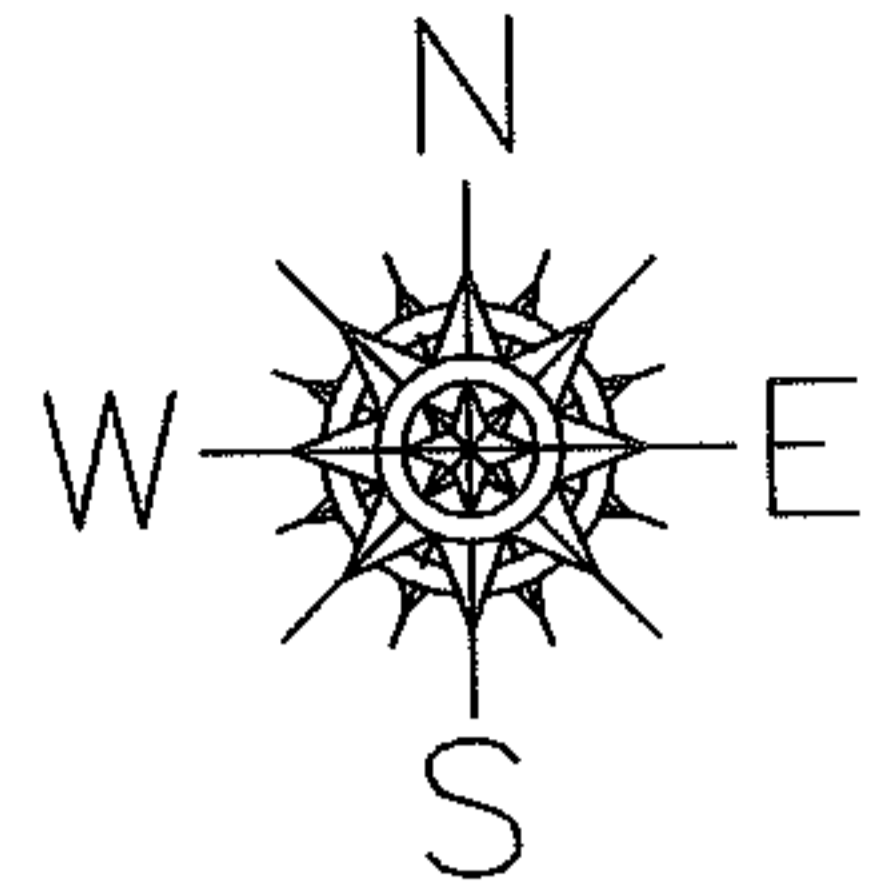

SPLITS/DEEDS PROCESSED
 LORAIN COUNTY TAX MAP DEPARTMENT
 226 MIDDLE AVE. ELYRIA, OHIO

SURVEYED BY: DAVE ELWELL
 CLOSURE: 0.00 : 10.000
 MAP PAGE(S): 6-135, 6-117
 APPROVED BY: JAH DATE: 2-8-07
 SCALE: 1" = 300 PRIOR INSTRUMENT: 20040038902