




RASTER

PARENT PARCEL: 10-00-021-000-047

CHILD PARCEL: 10-00-021-000-068, -069

STARTING POINT: CENTERLINE OF NICKELPLATE DIAGONAL RD & O.L. 21

07-02318

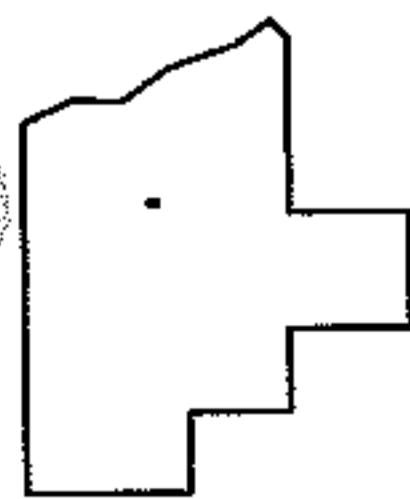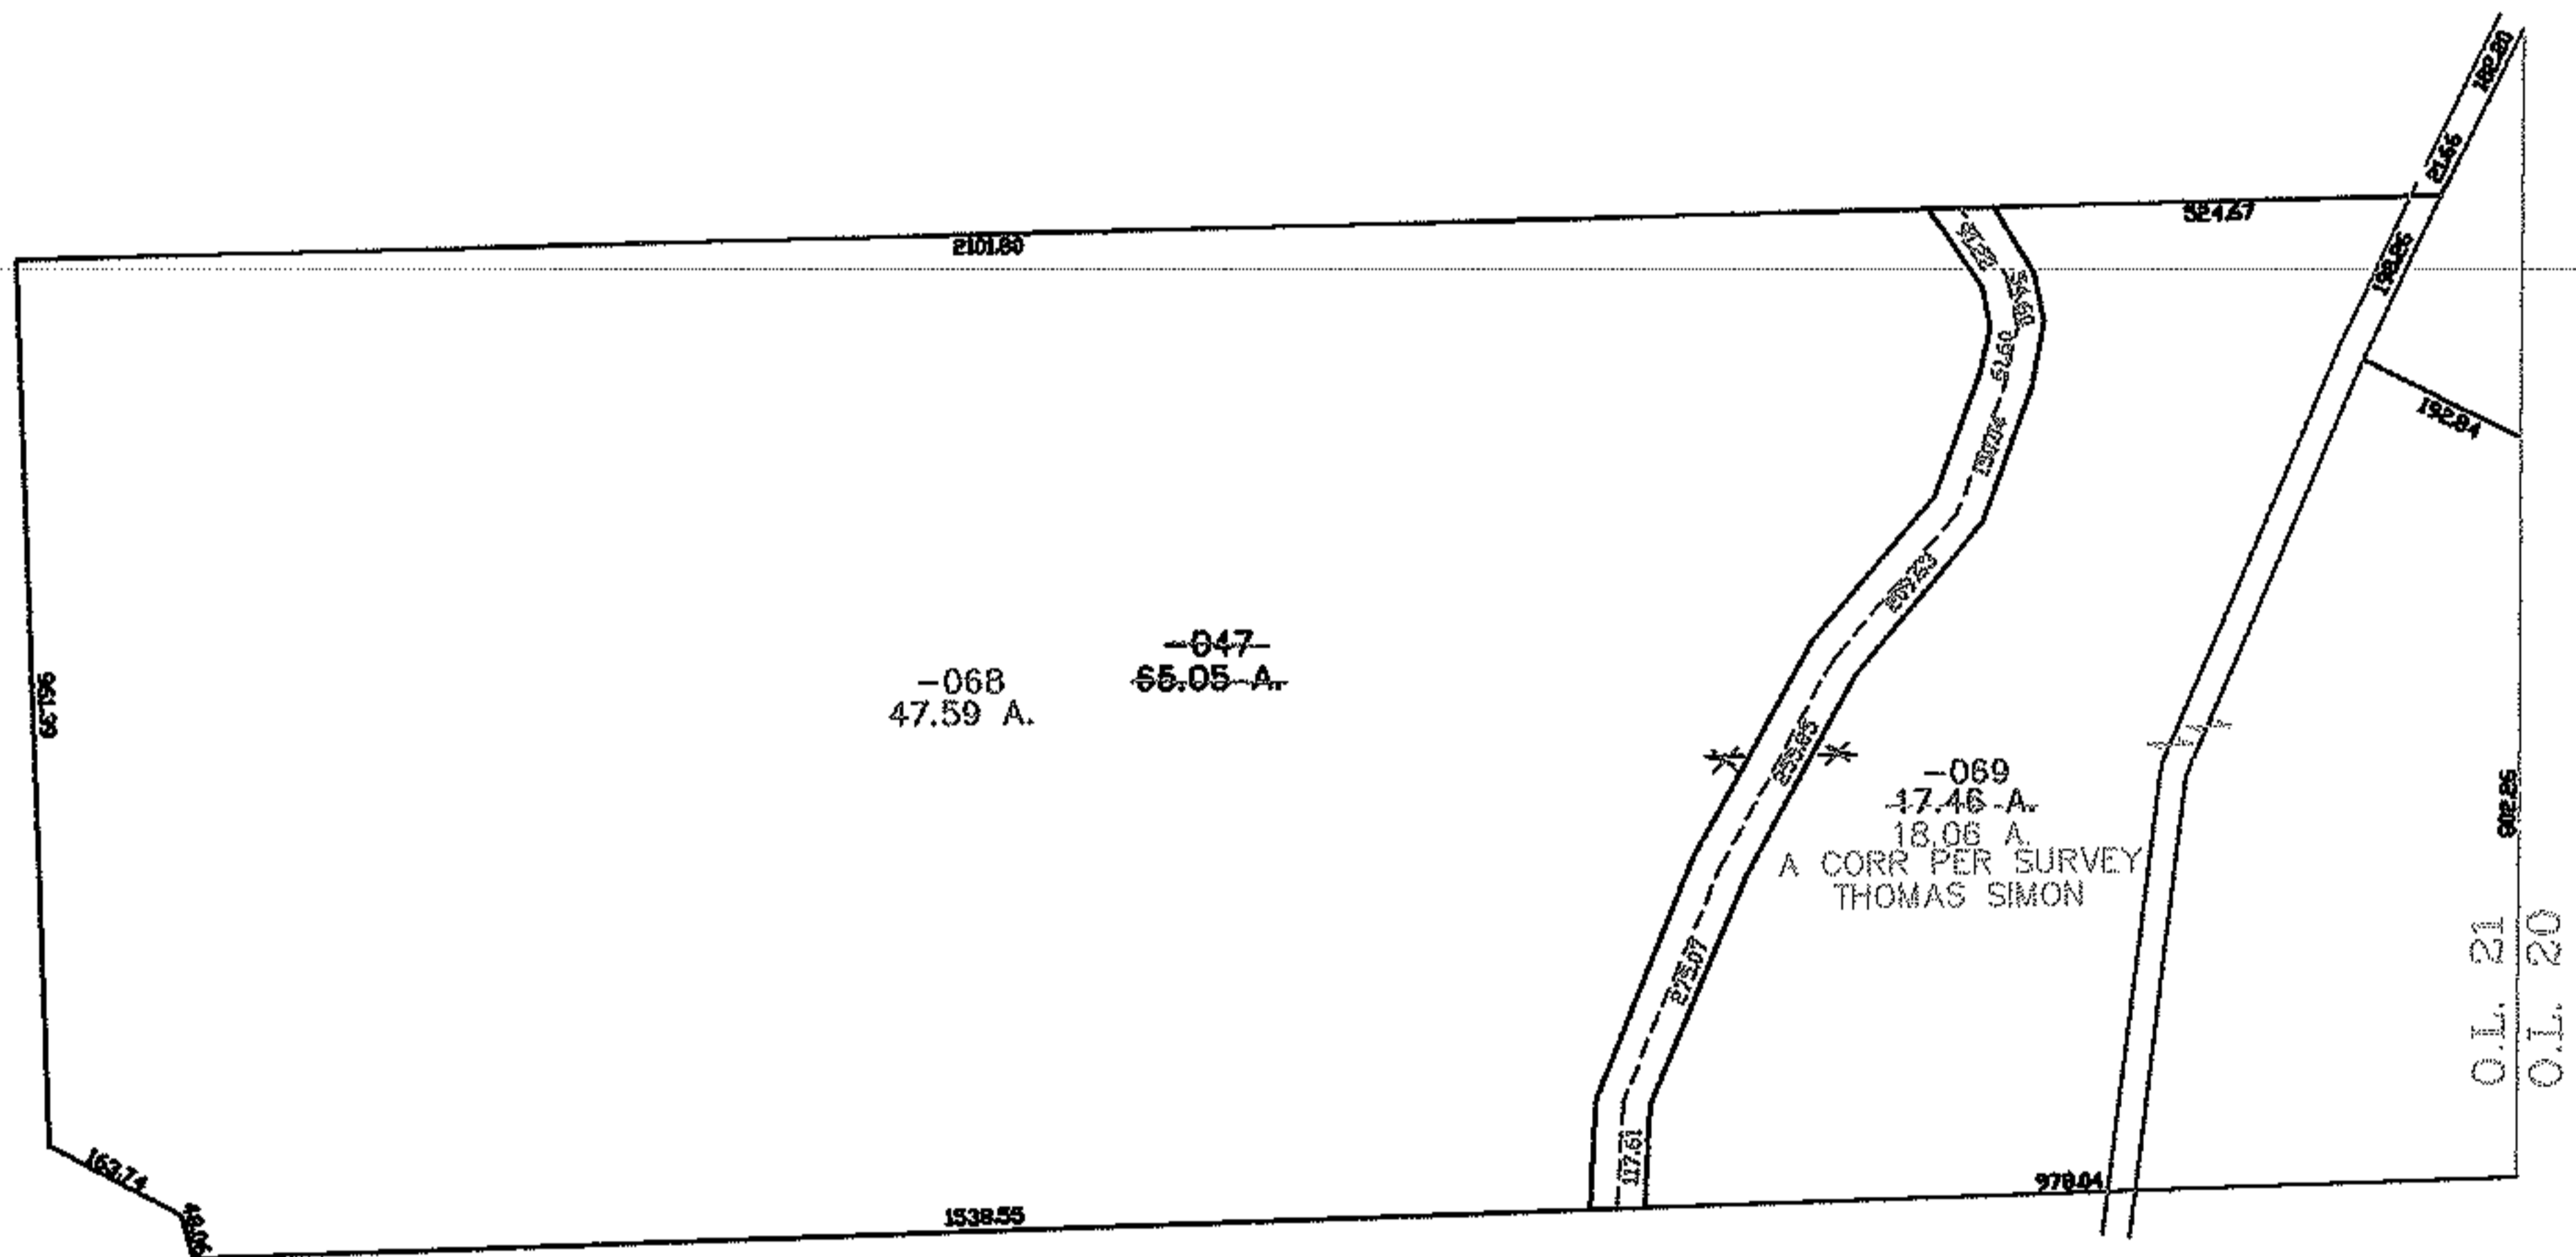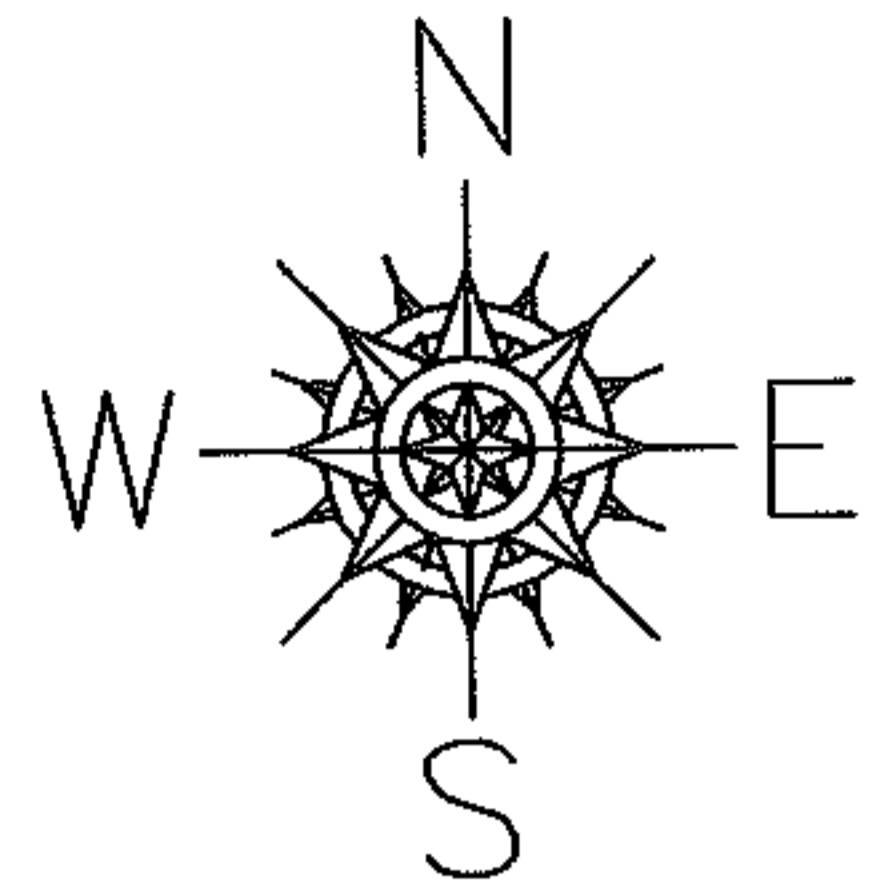

SPLITS/DEEDS PROCESSED

LORAIN COUNTY TAX MAP DEPARTMENT
226 MIDDLE AVE. ELYRIA, OHIO

SURVEYED BY: THOMAS SIMON

CLOSURE: 0.00 : 10,000

MAP PAGE(S): 10-E

APPROVED BY: JAH DATE: 2-8-07

SCALE: 1" = 400 PRIOR INSTRUMENT: 20040995978