


PARENT PARCEL: 17-06-033-000-009 & -010, 20-06-034-000-001 & -002  
CHILD PARCEL: 17-06-033-000-013, -014, -015, 20-06-034-000-001 & -002  
STARTING POINT: MON BOX INT CL OF QUARRY RD AND JONES RD

07-02319

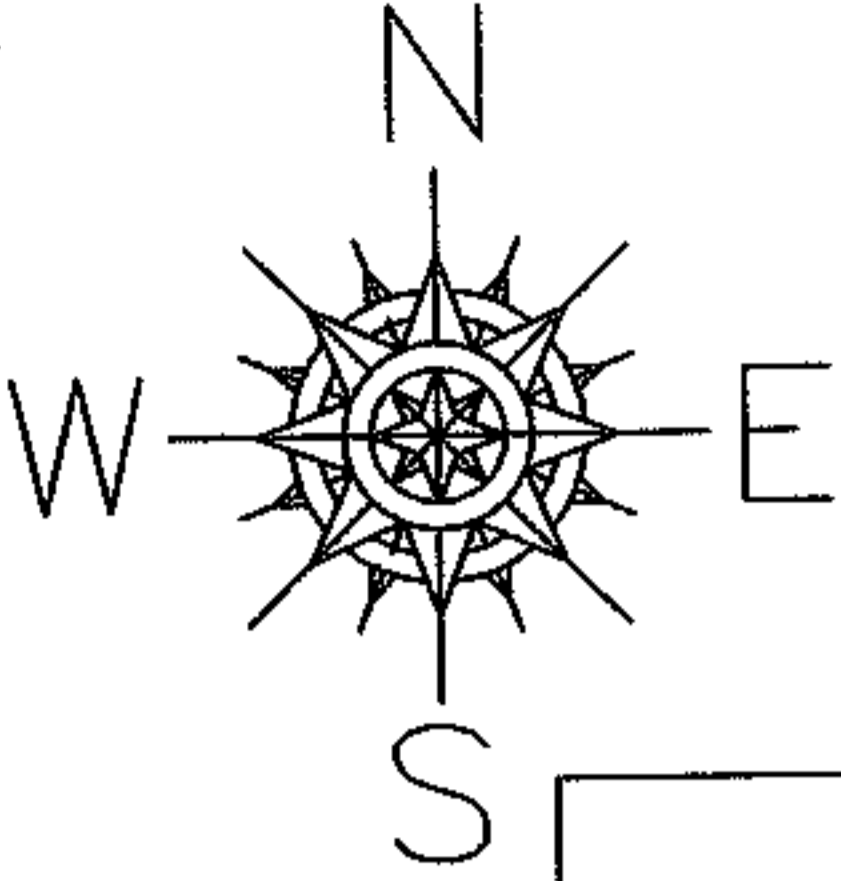

JONES RD.

2214.82  
-028  
35.78 A.  
264.00  
370.00  
600.81

D.L. 27 D.L. 32  
D.L. 26 D.L. 33

2665.08

~~-010~~  
~~121.39 A.~~  
-014  
79.72 A.

699.98  
218 699.98  
699.98  
226.10 386.00  
-013  
2.00 A.  
385.99  
-009  
6.79 A.  
200

RD. 1571.46  
638.17

QUARRY


3266.02

BRIGHTON TWP  
ROCHESTER TWP

533.97  
298.50  
-002  
3.47 A.  
3.46 A.

-001  
2.48 A.  
2.44 A.

AC. CORR.  
PER SURVEY  
T. SNEZEK

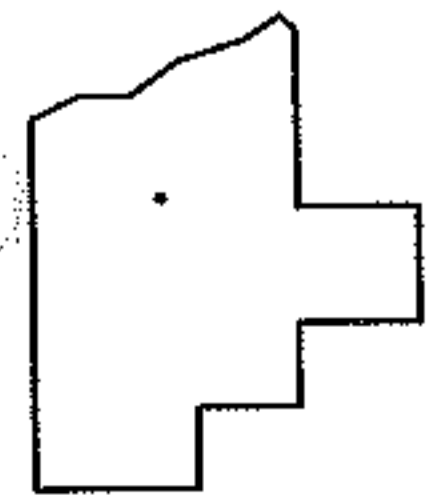

SPLITS/DEEDS PROCESSED  
LORAIN COUNTY TAX MAP DEPARTMENT  
226 MIDDLE AVE. ELYRIA, OHIO

SURVEYED BY: THOMAS M. SNEZEK  
CLOSURE: 1:10,000  
MAP PAGE(S): 17-06-033-A  
APPROVED BY: DRH DATE: 2/6/2007  
SCALE: 1" = 500 PRIOR INSTRUMENT: O.R. 332/678