




RASTER

PARENT PARCEL: 10-00-012-000-059

11-02320-D

CHILD PARCEL: _____

STARTING POINT: INTERSECTION OF C/L OF BUTTERNUT RIDGE RD. AND TANGENT LINE OF OBERLIN-ELYRIA RD.

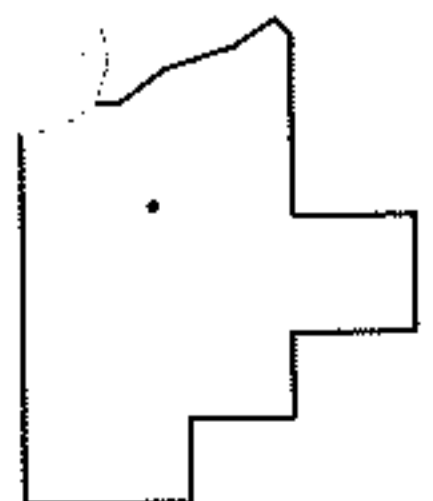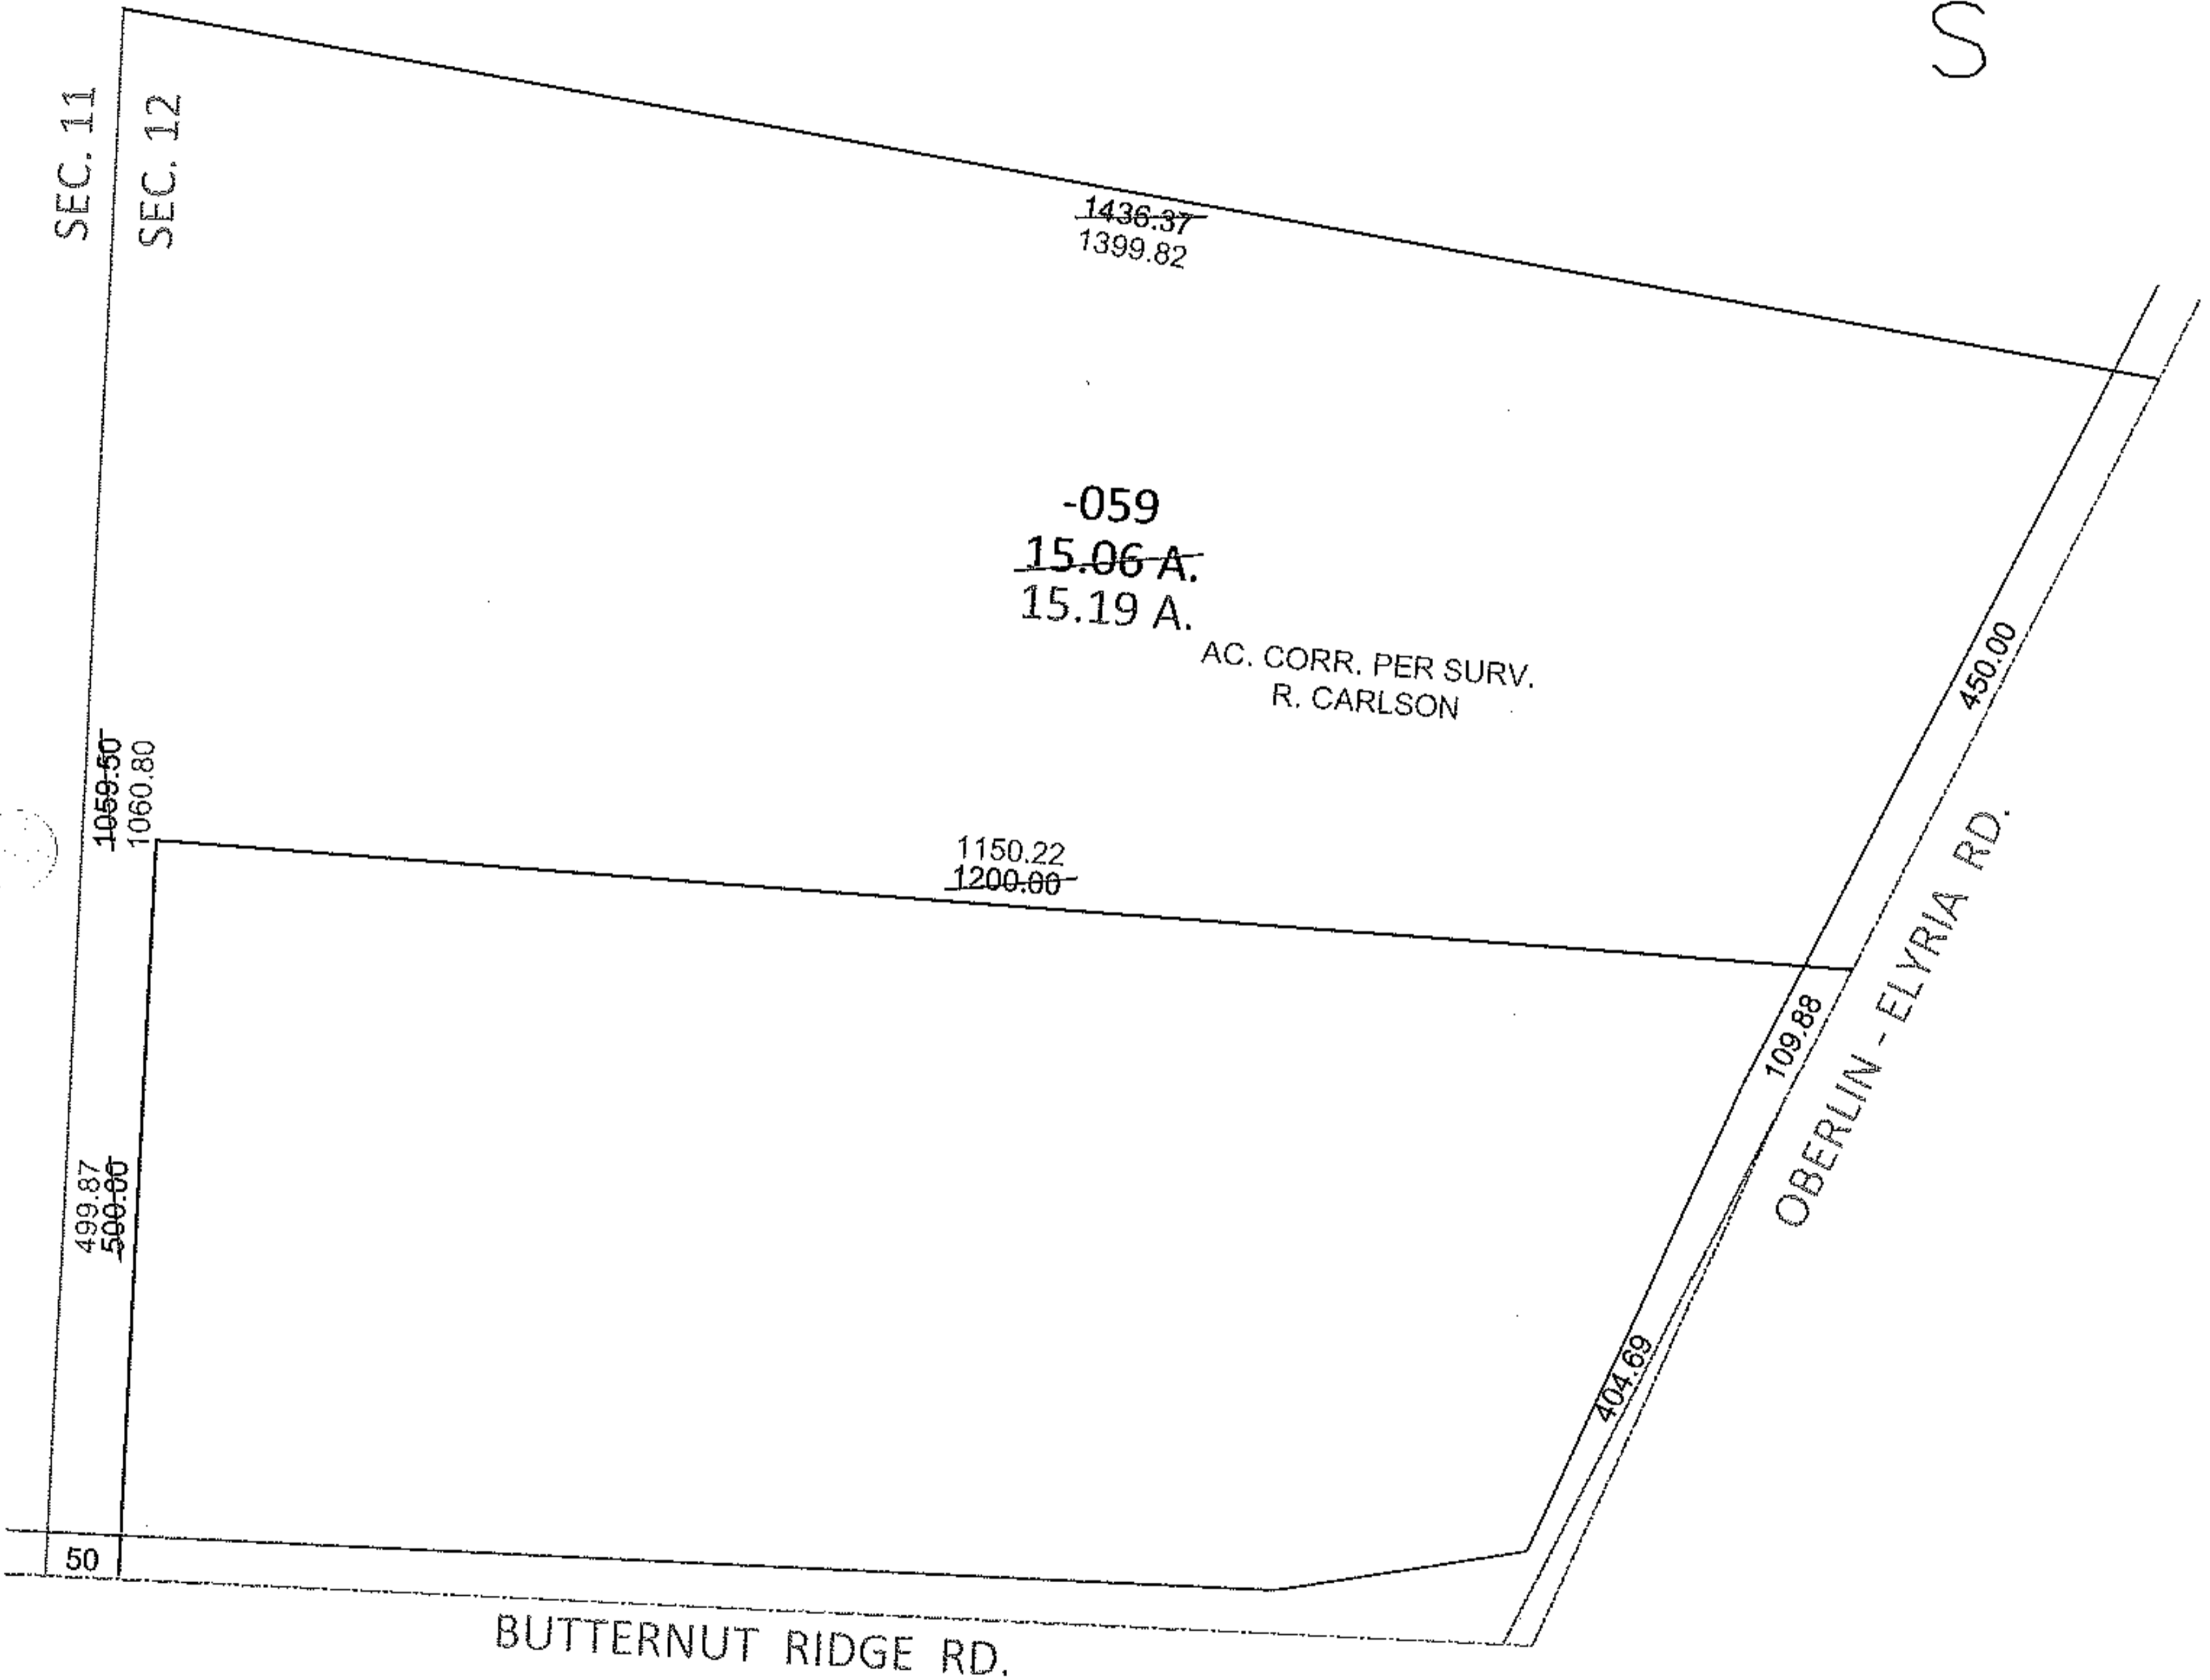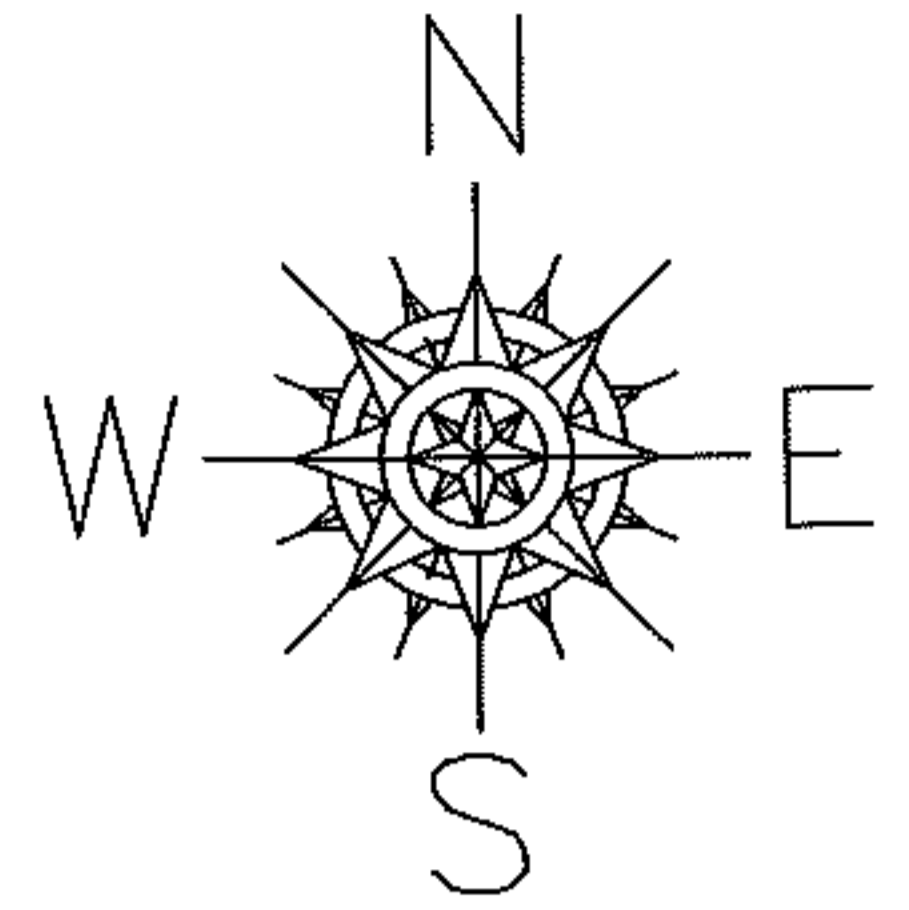

SPLITS/DEEDS PROCESSED

LORAIN COUNTY TAX MAP DEPARTMENT
226 MIDDLE AVE. ELYRIA, OHIO

SURVEYED BY: RICHARD D. CARLSON

CLOSURE: .01:10,000

MAP PAGE(S): 10-00-012-A

APPROVED BY: RRM DATE: 7-14-11

SCALE: 1"= 200 PRIOR INST.: DV 904/440