
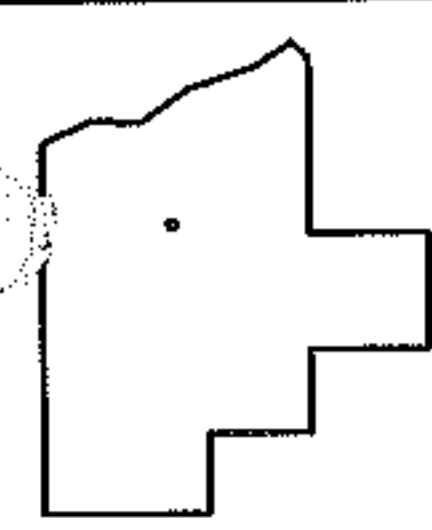
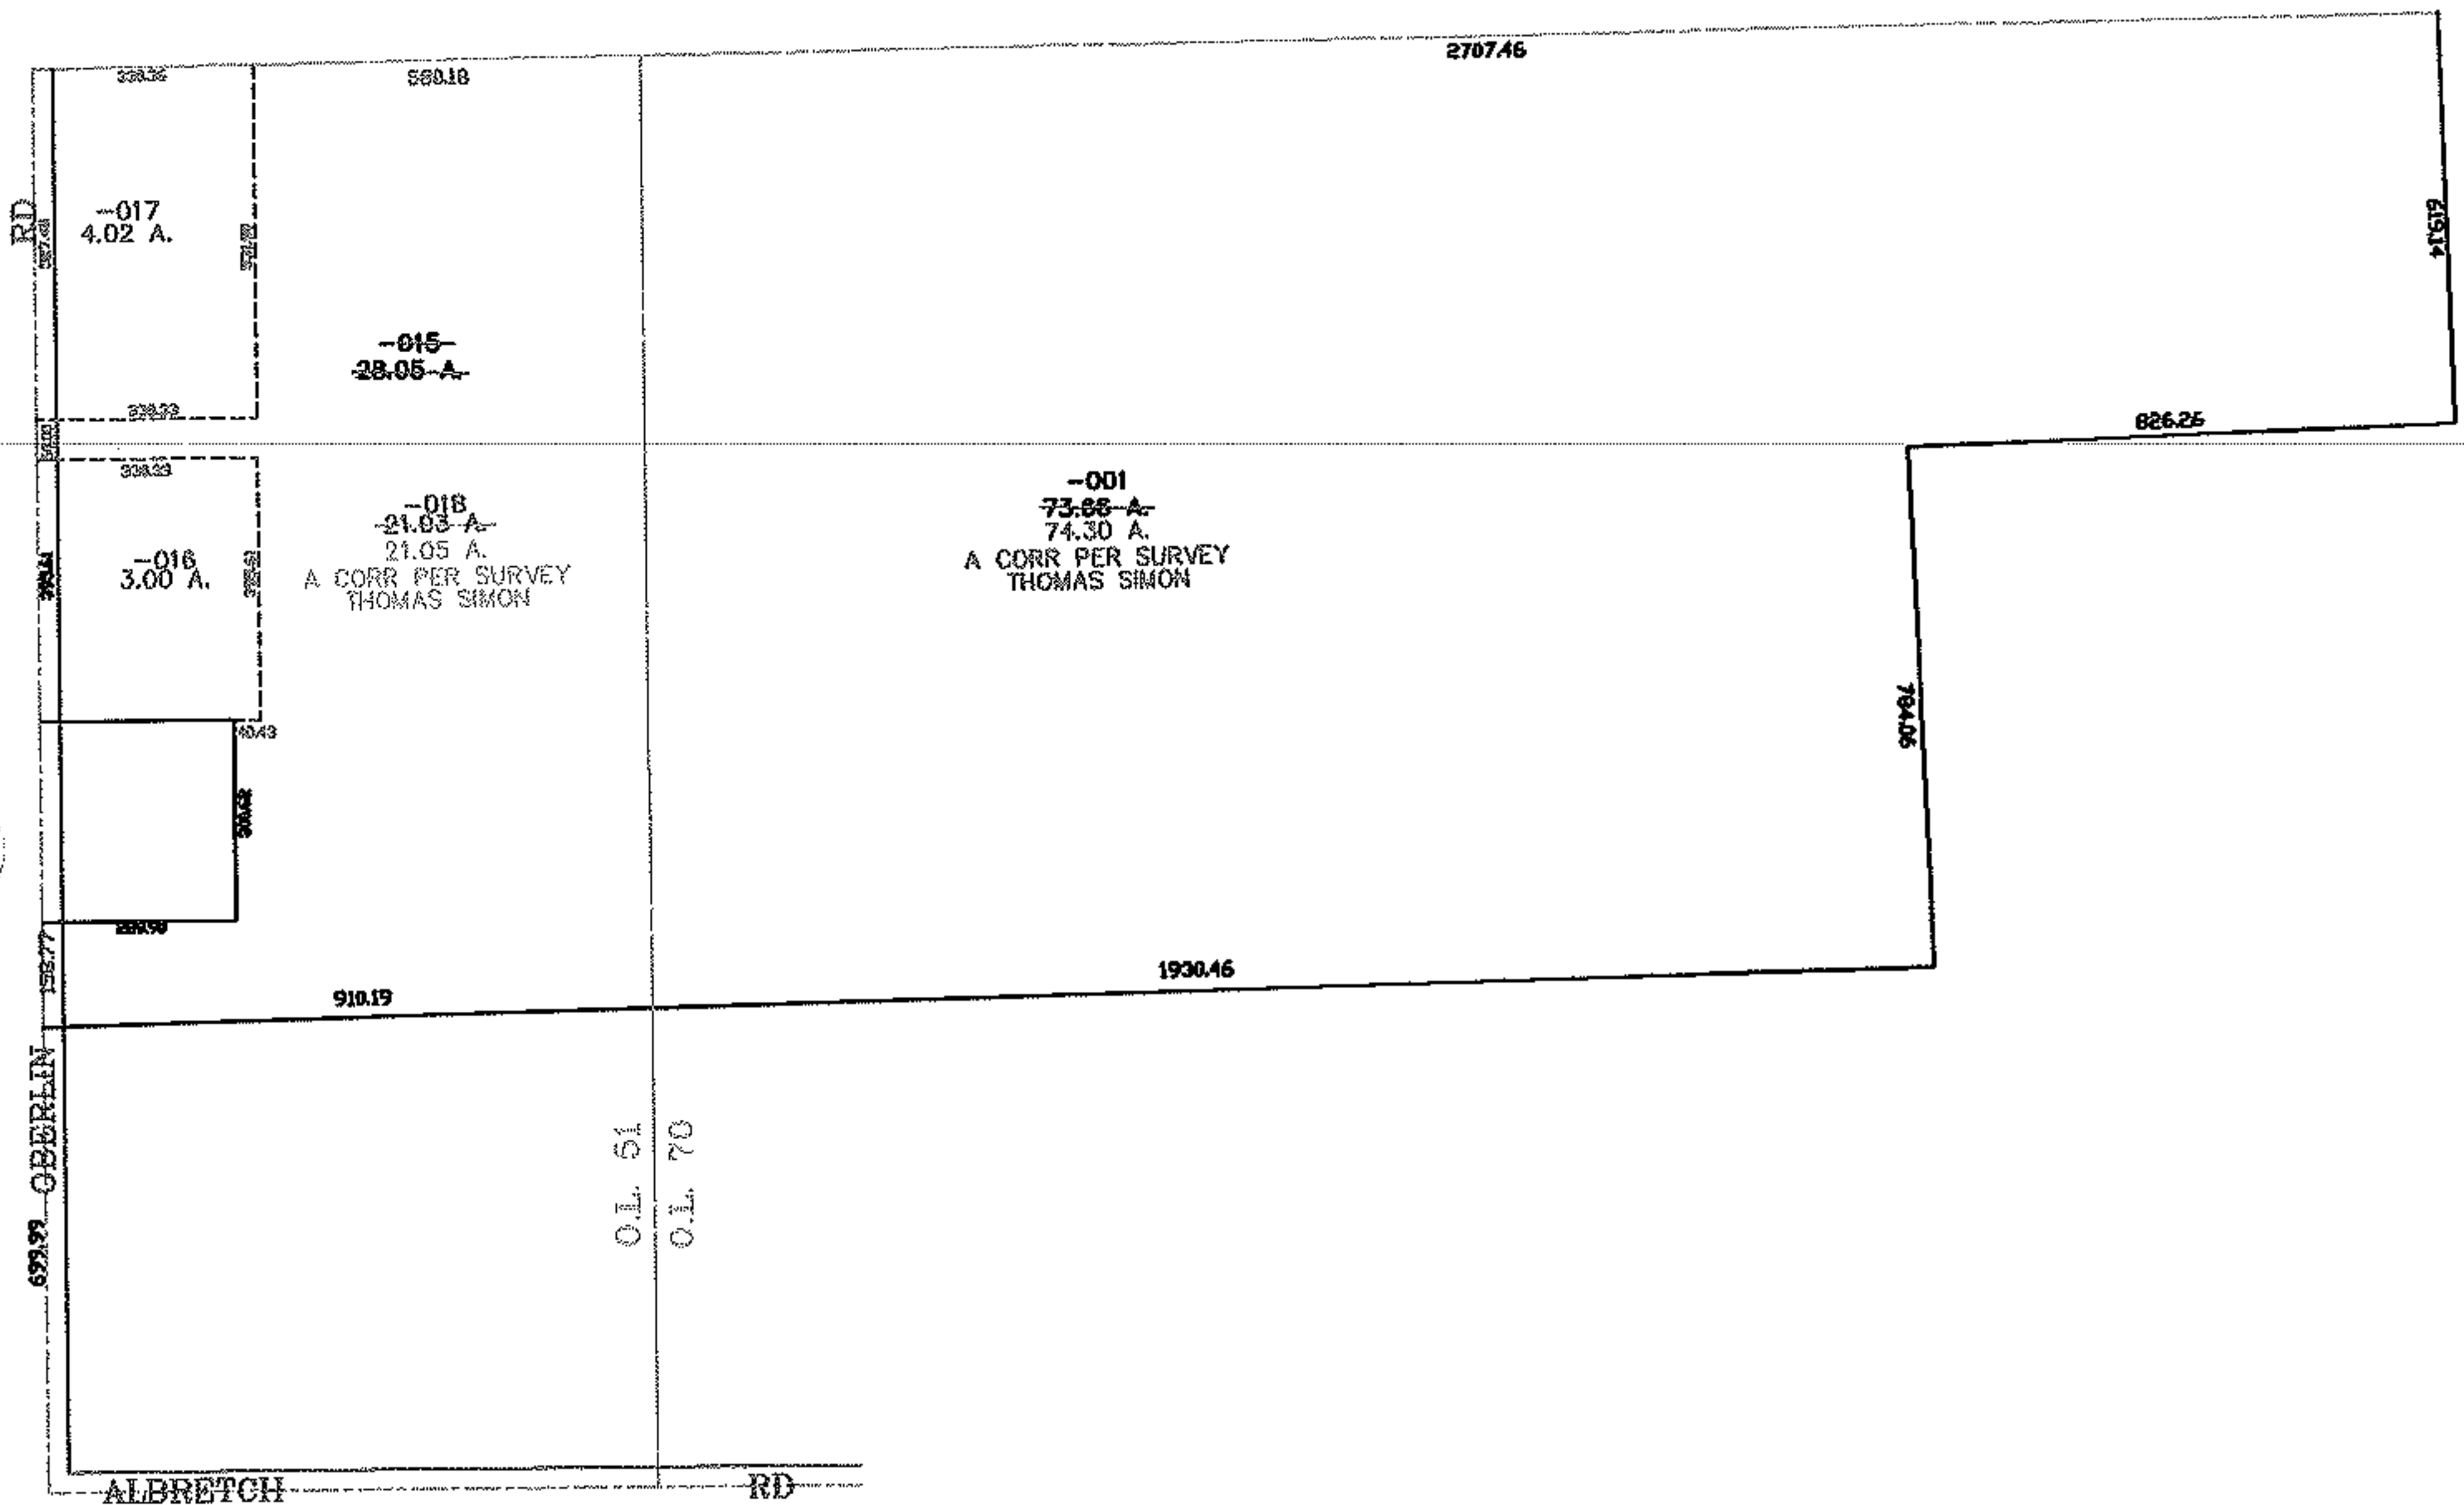


PARENT PARCEL: 05-00-051-000-015, 05-00-070-000-001

CHILD PARCEL: 05-00-051-000-016 THRU -018

STARTING POINT: CENTERLINE OF OBERLIN RD & ALBRETCH RD

07-02321

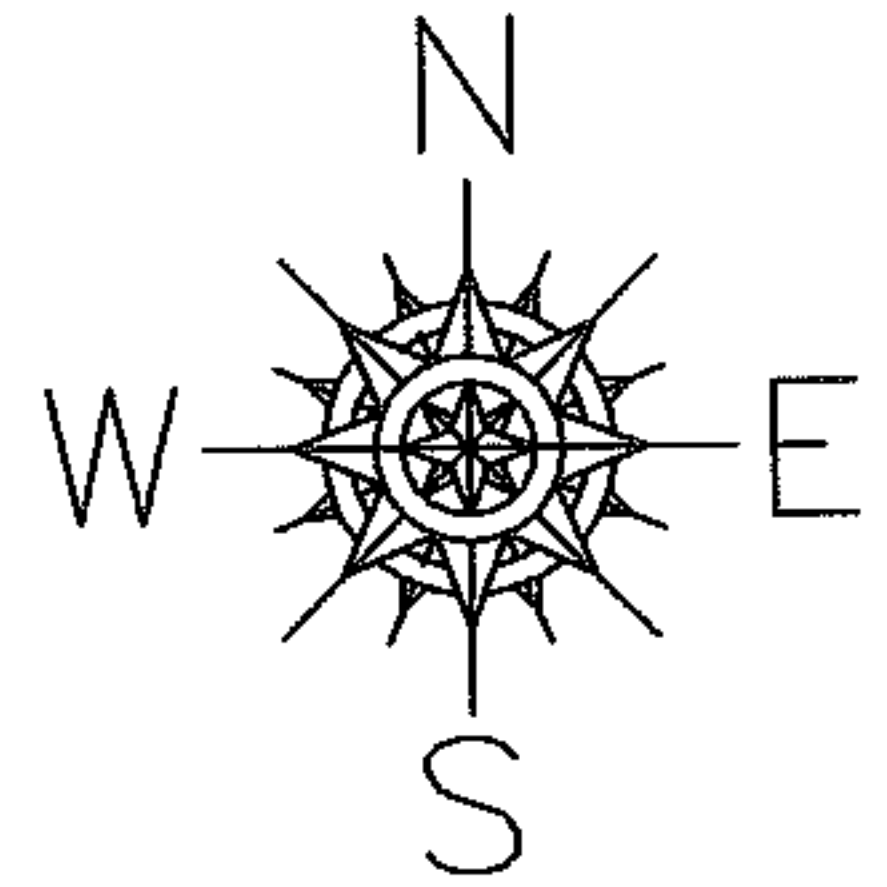

**SPLITS/DEEDS PROCESSED**  
LORAIN COUNTY TAX MAP DEPARTMENT  
226 MIDDLE AVE. ELYRIA, OHIO

SURVEYED BY: THOMAS SIMON  
CLOSURE: 0.00 : 10.000  
MAP PAGE(S): 05-00-053-B  
APPROVED BY: JAH DATE: 2-7-07  
SCALE: 1" = 500 PRIOR INSTRUMENT: 20050071879