


RASTER

PARENT PARCEL: 02-02-019-104-015, -016

CHILD PARCEL: _____

STARTING POINT: _____

11-02323-C

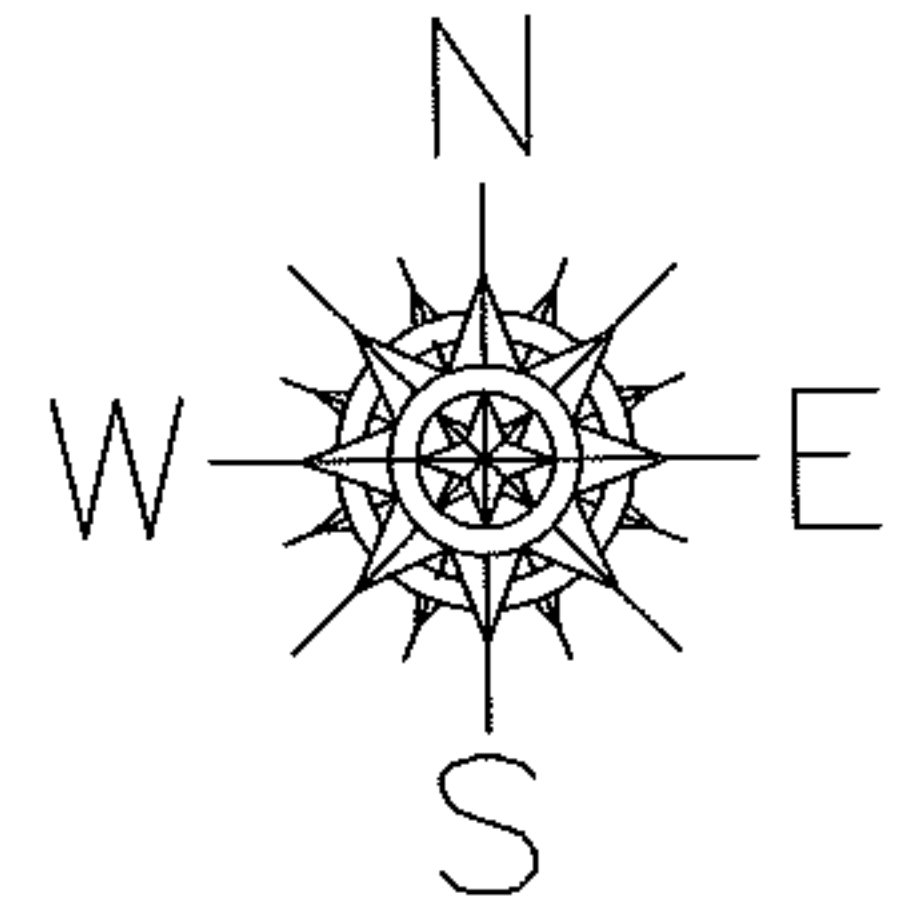

FRONTAGE AND DEPTH CORRECTION

02-02-019-104-015

02-02-019-104-016

25 X 418.06


150 X 209.41

~~150 X 209.41~~

~~25 X 418.06~~

PARCELS WERE FLIPPED IN REGISTER AND ON TRANSFER SHEETS

WEST PARK DR.

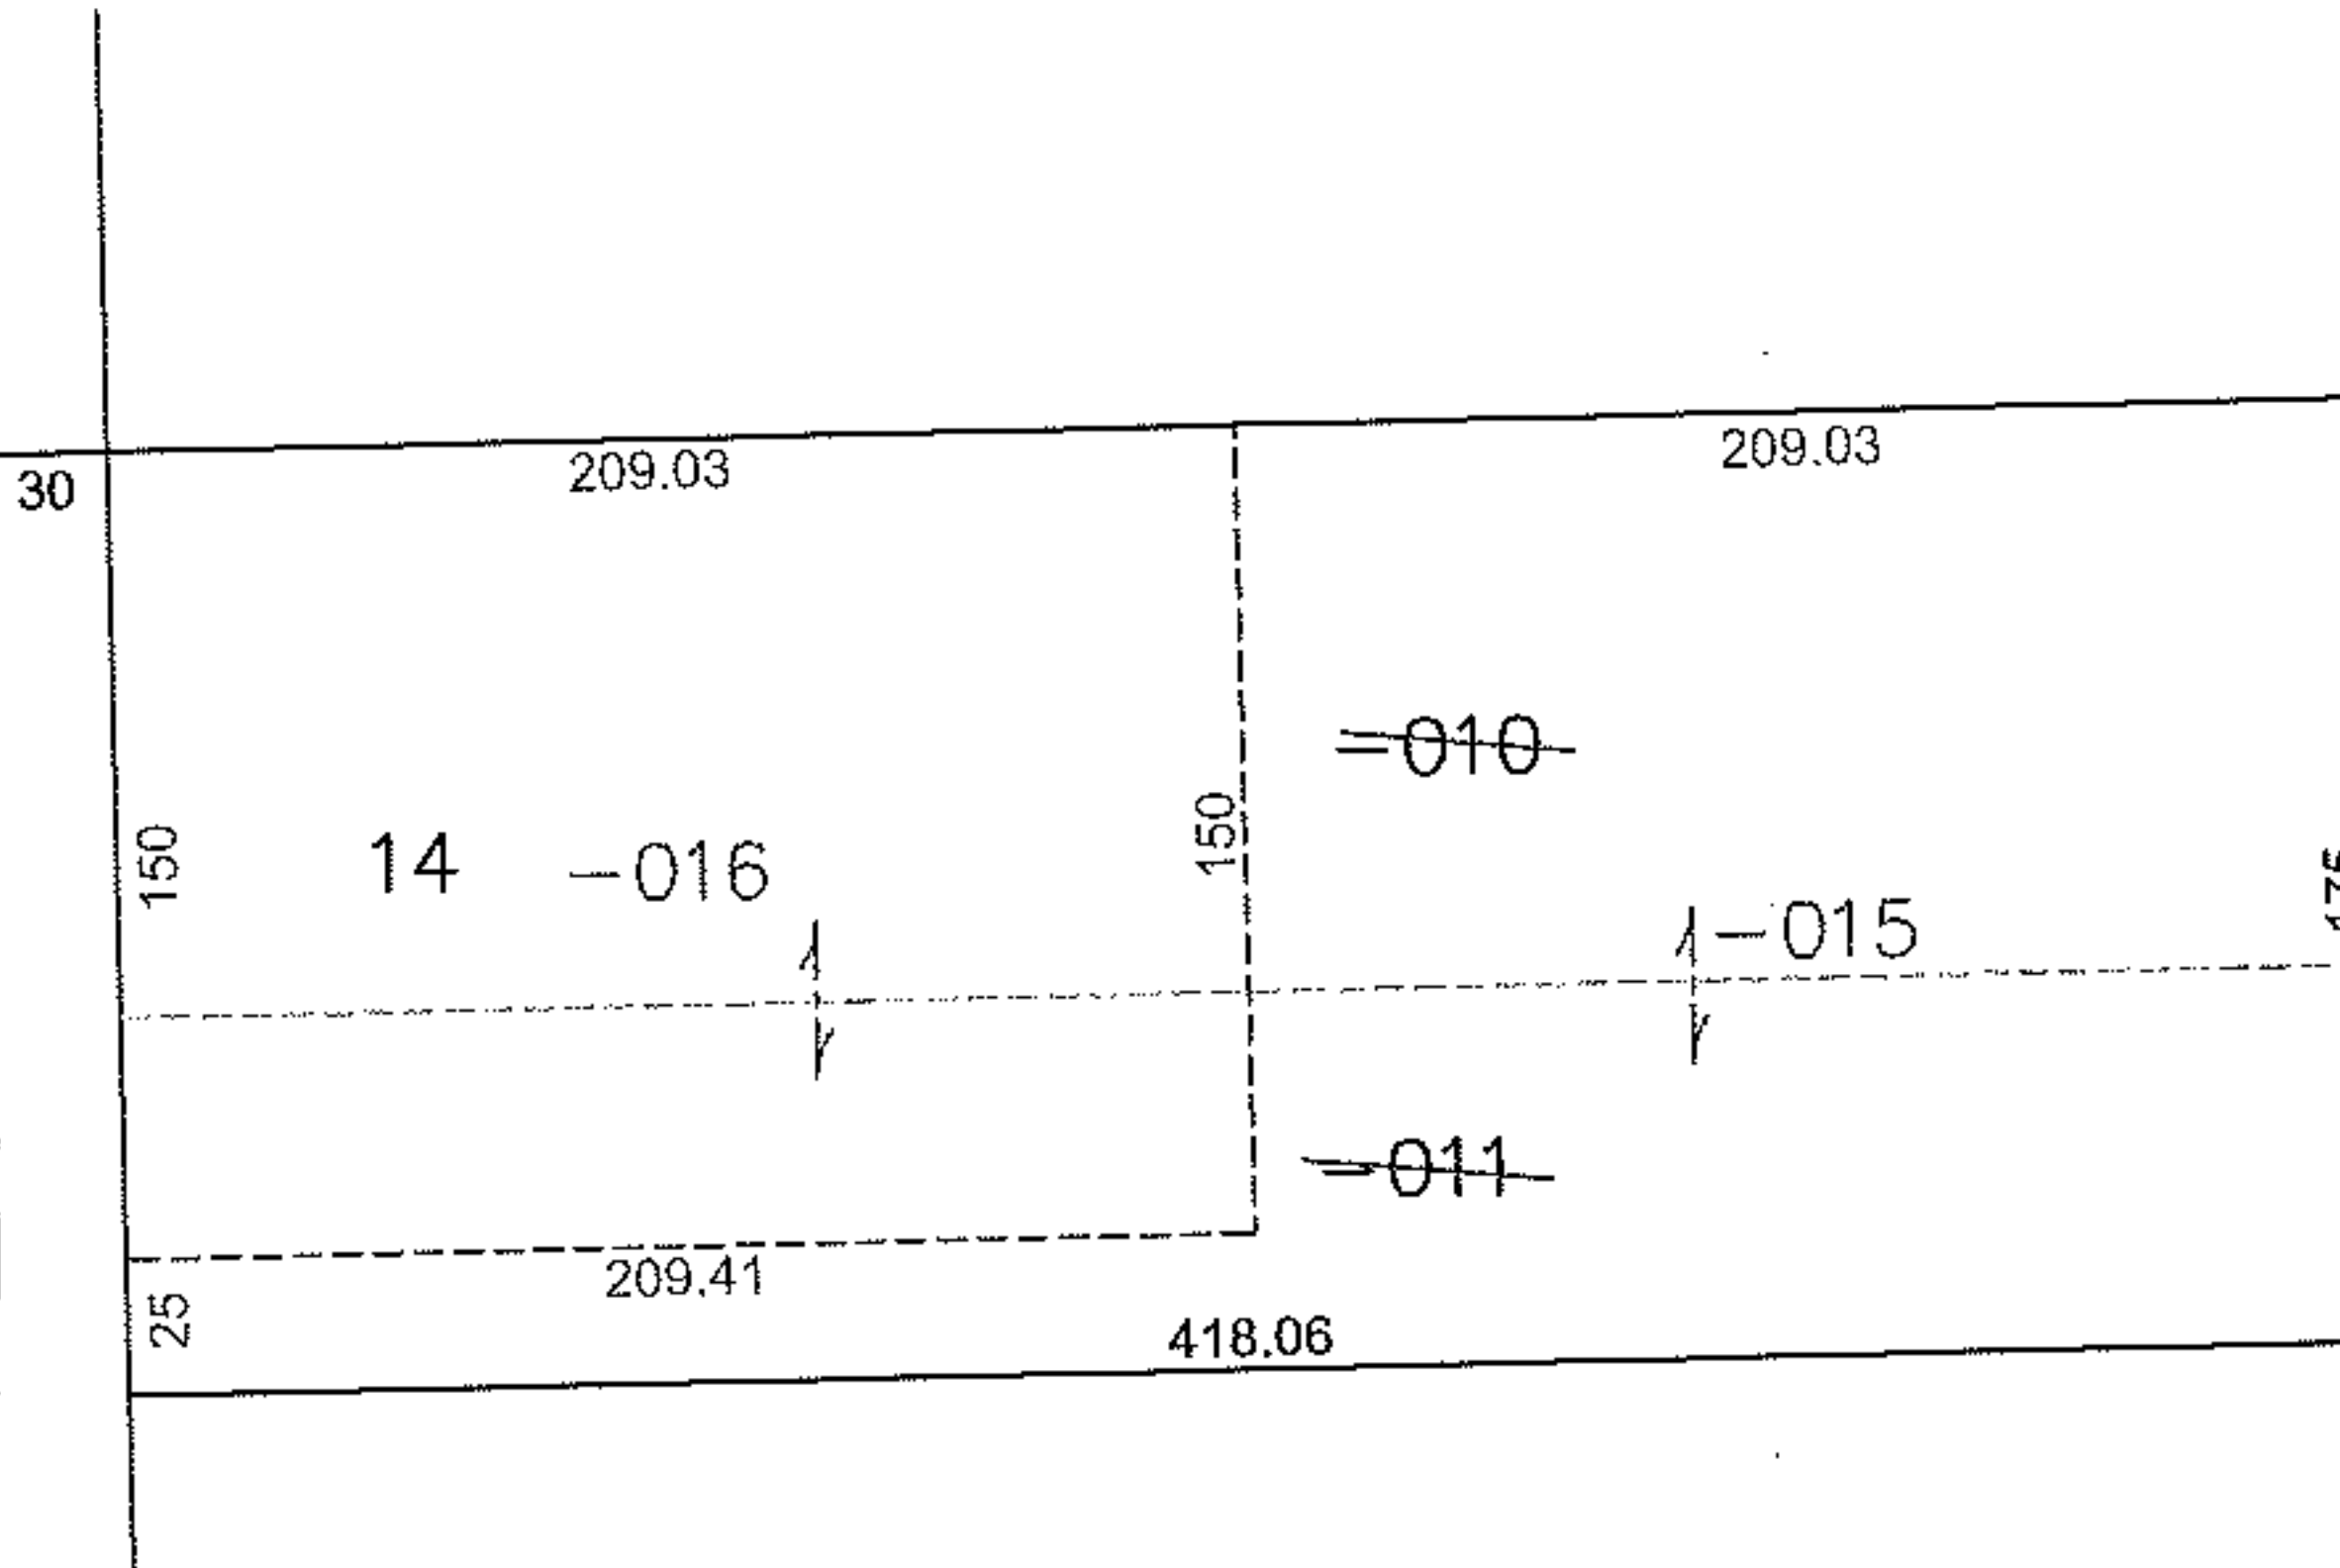

-015

-016

20030958166

20030958165

20030963906

20040985626

SPLITS/DEEDS PROCESSED

LORAIN COUNTY TAX MAP DEPARTMENT
226 MIDDLE AVE. ELYRIA, OHIO

SURVEYED BY: EHTESHAM SUHAIL

CLOSURE: .00:10,000

MAP PAGE(S): 2-02-019-B

APPROVED BY: RRM DATE: 7-19-11

SCALE: 1"= 100 PRIOR INST.: SEE ABOVE