
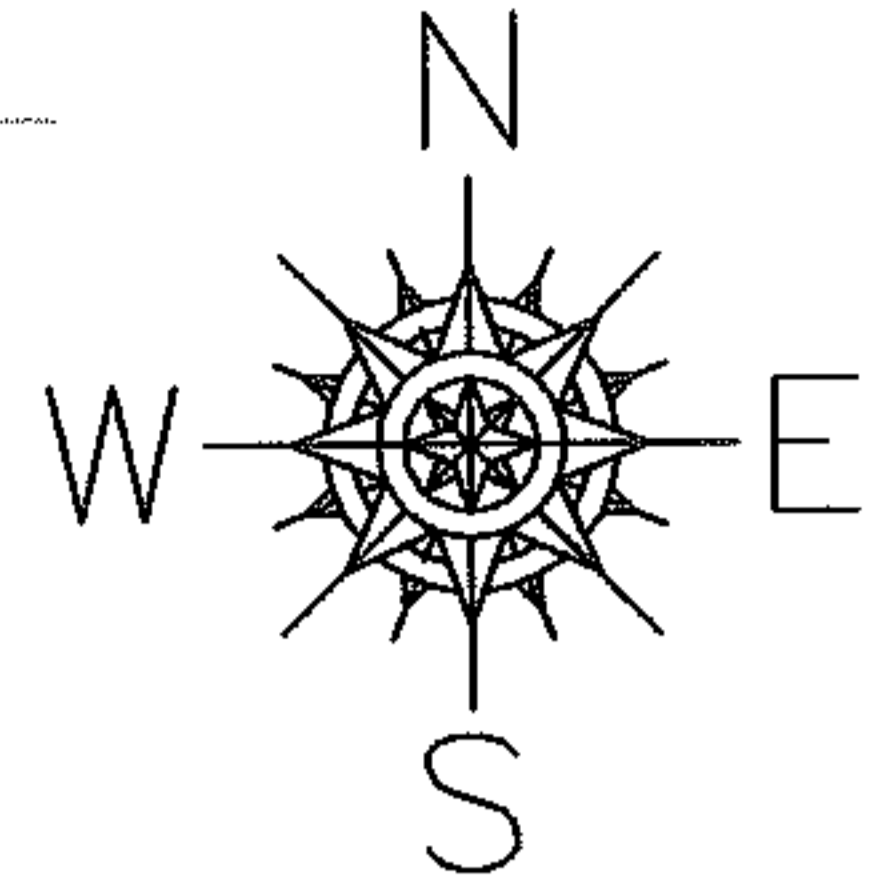


PARENT PARCEL: 05-00-053-000-065


CHILD PARCEL: 05-00-053-000-095 THRU -099

STARTING POINT: CENTERLINE OF OBERLIN RD & O.L. 53

07-02323

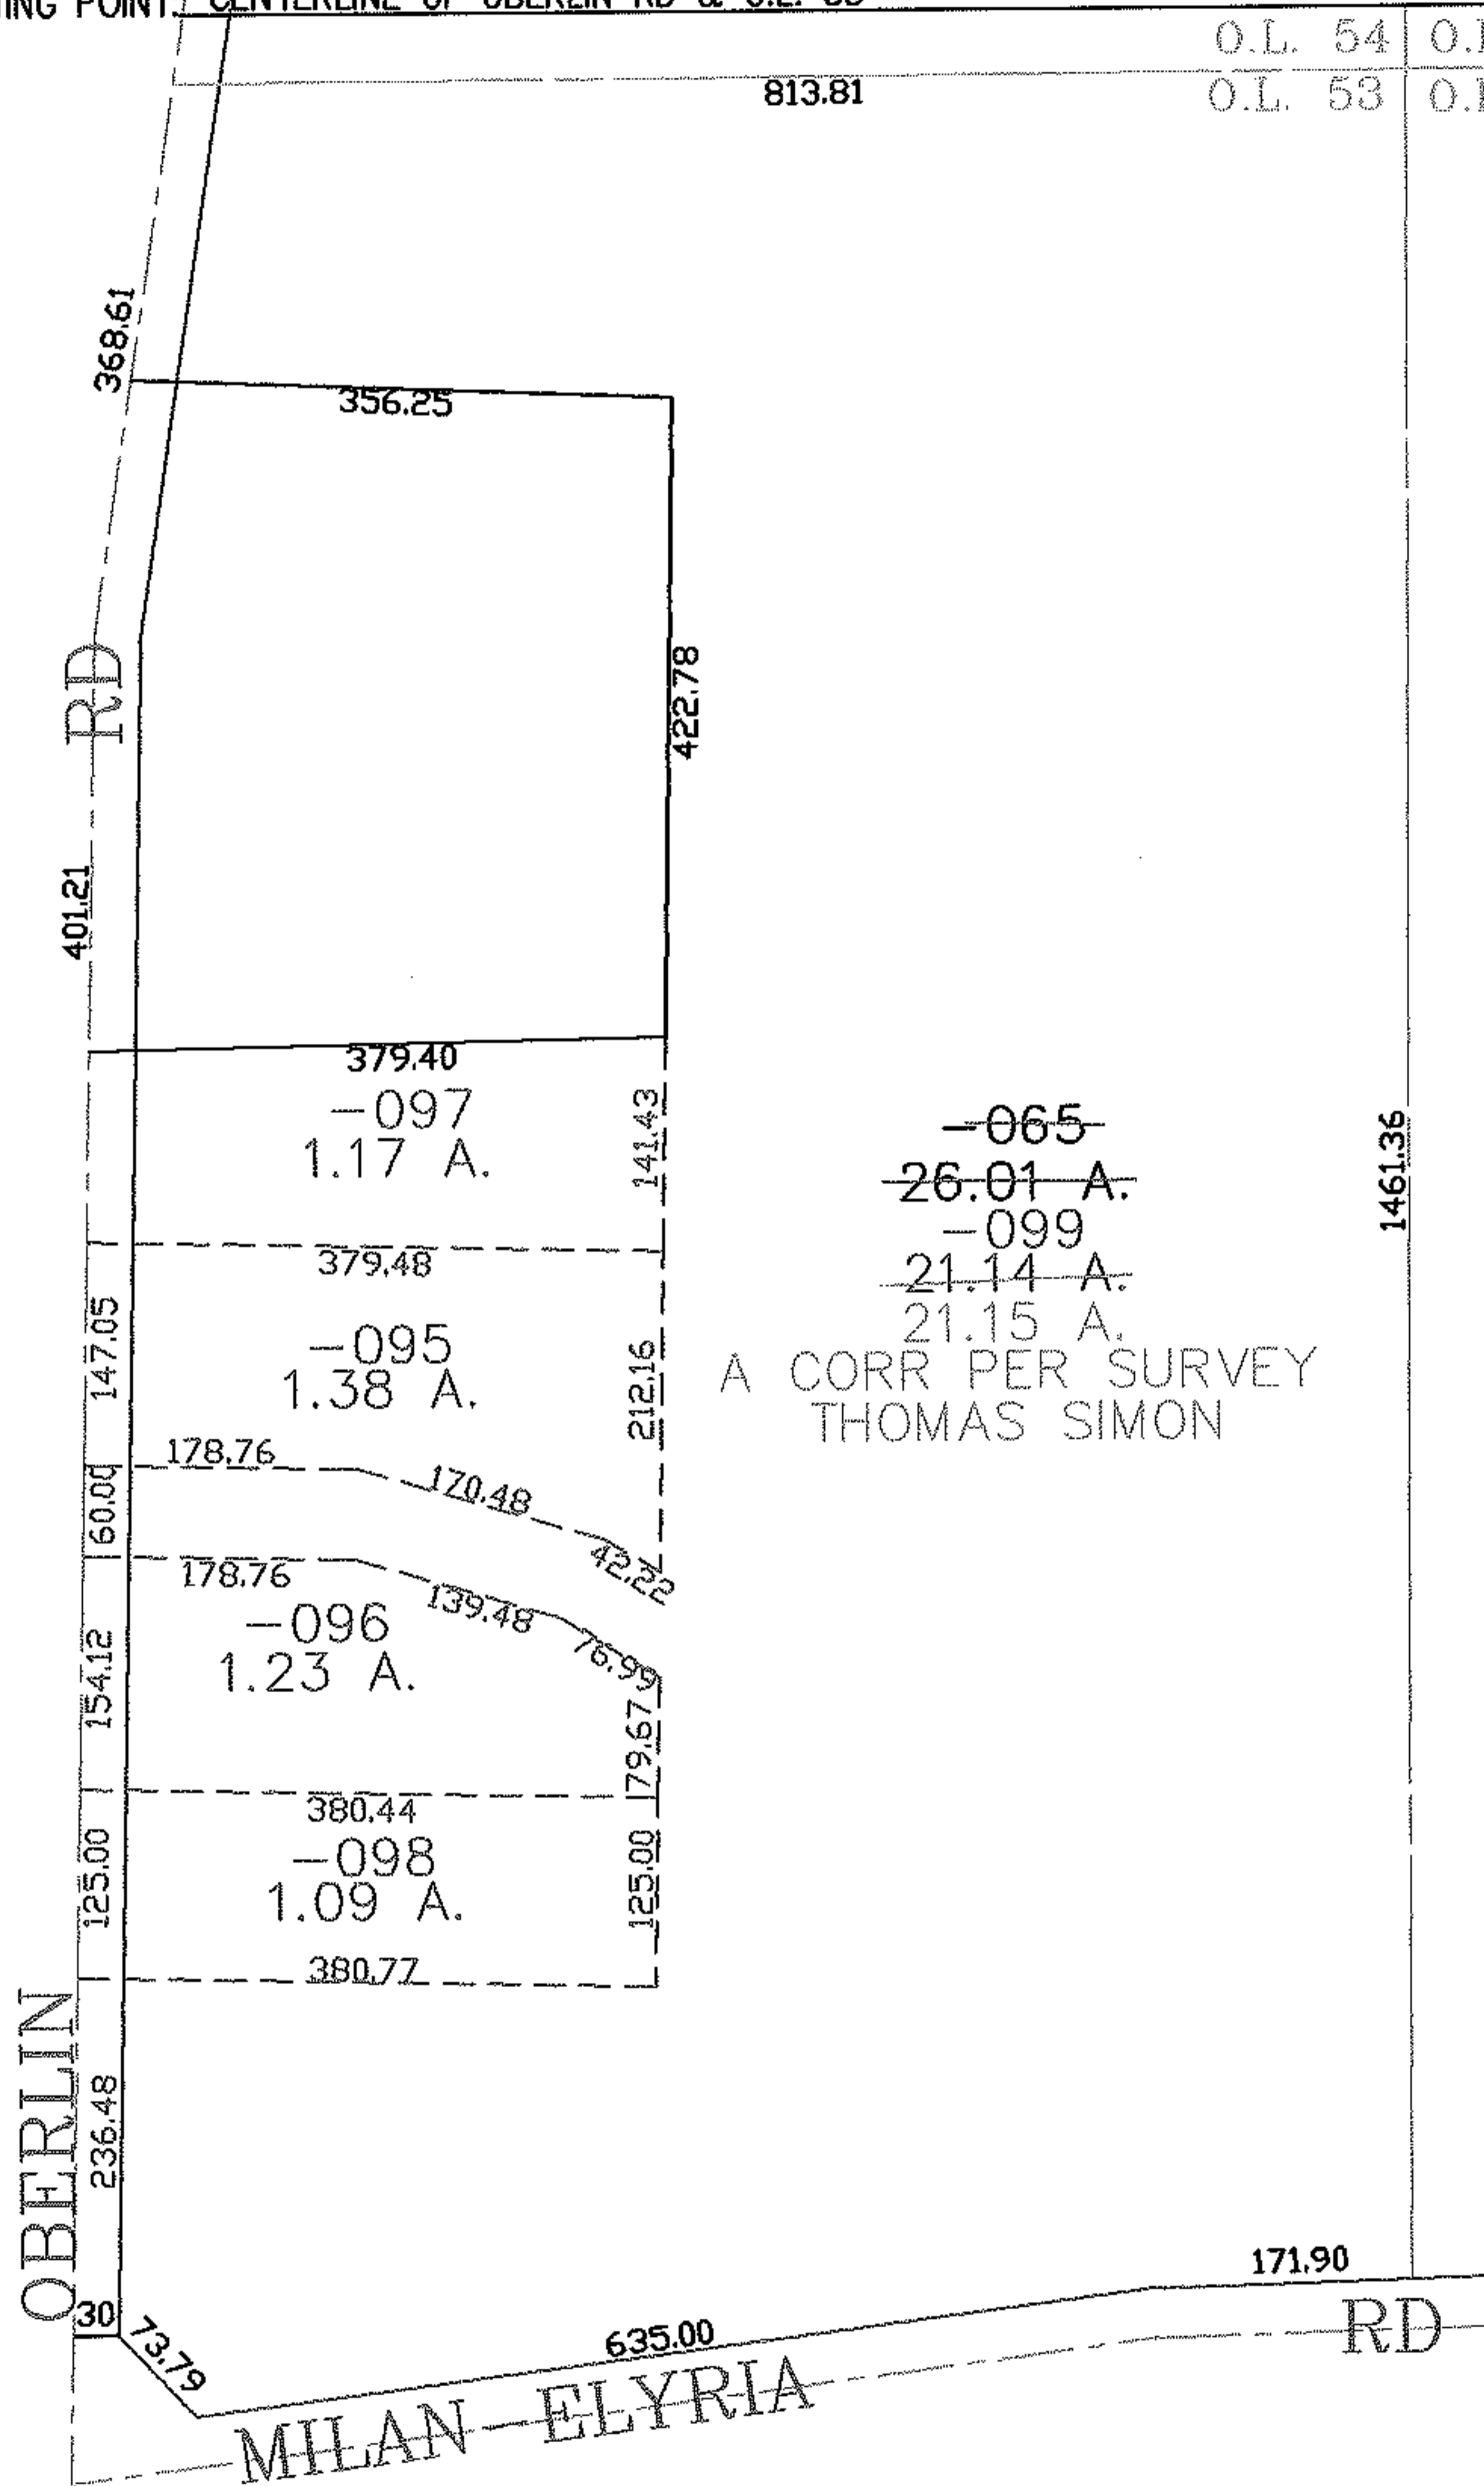

~~-065-~~  
~~26.01 A.~~  
~~-099~~  
~~21.14 A.~~  
 21.15 A.  
 A CORR PER SURVEY  
 THOMAS SIMON

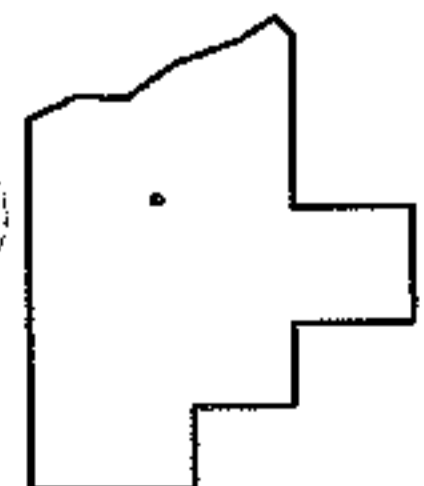

**SPLITS/DEEDS PROCESSED**  
 LORAIN COUNTY TAX MAP DEPARTMENT  
 226 MIDDLE AVE. ELYRIA, OHIO

SURVEYED BY: THOMAS SIMON  
 CLOSURE: 0.00 : 10.000  
 MAP PAGE(S): 05-00-053-B  
 APPROVED BY: JAH DATE: 2-8-07  
 SCALE: 1" = 200 PRIOR INSTRUMENT: 20020827159