
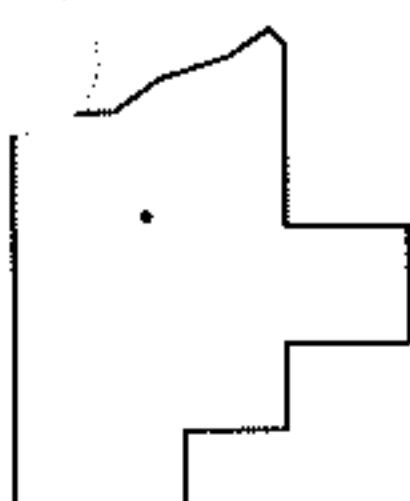
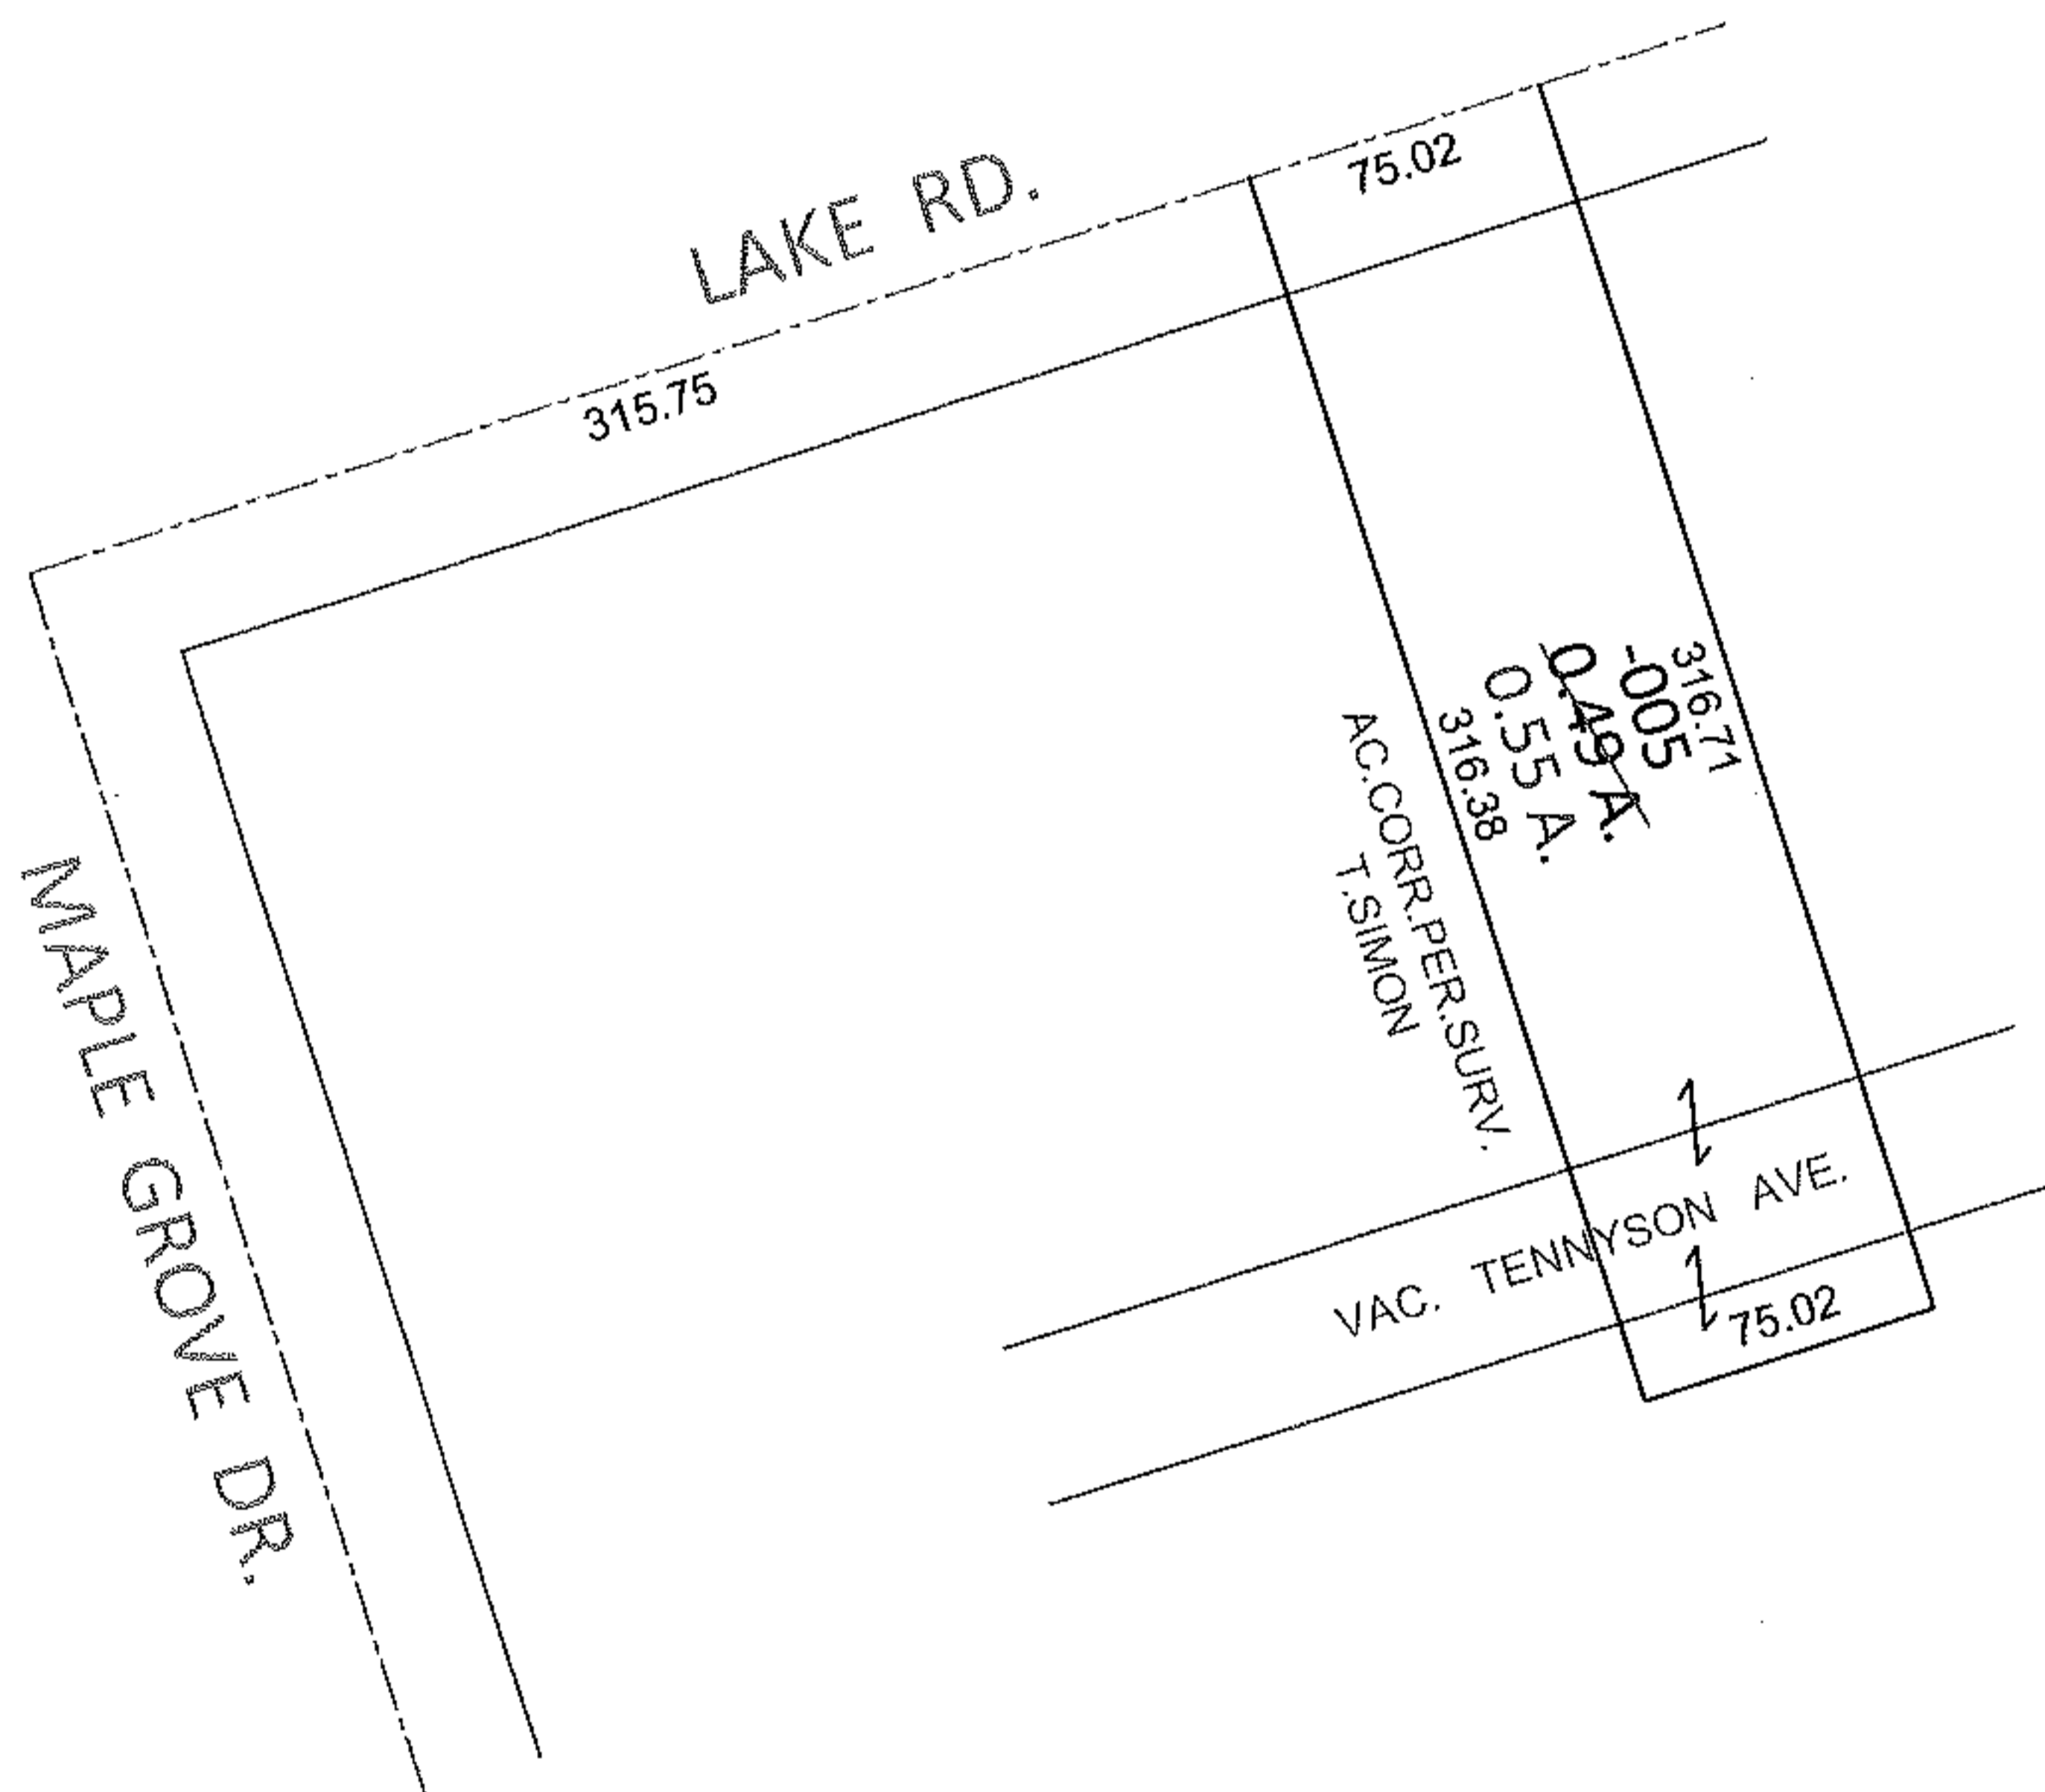


PARENT PARCEL: 03-00-043-107-005

CHILD PARCEL: _____

STARTING POINT: INTERSECTION OF C/L OF LAKE RD. AND C/L MAPLE GROVE DR.

11-02324-D

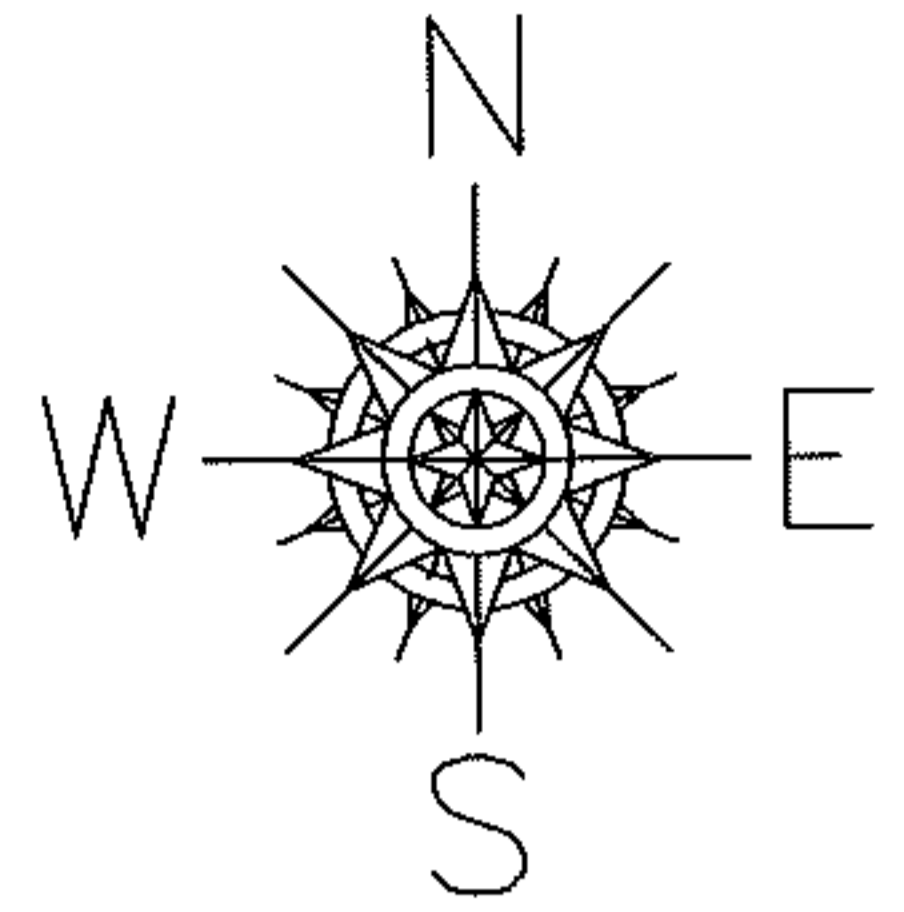

SPLITS/DEEDS PROCESSED

LORAIN COUNTY TAX MAP DEPARTMENT
226 MIDDLE AVE. ELYRIA, OHIO

SURVEYED BY: THOMAS A. SIMON

CLOSURE: .01:10,000

MAP PAGE(S): 3-00-043

APPROVED BY: RRM DATE: 7-20-11

SCALE: 1"= 100 PRIOR INST.: 20110367709