
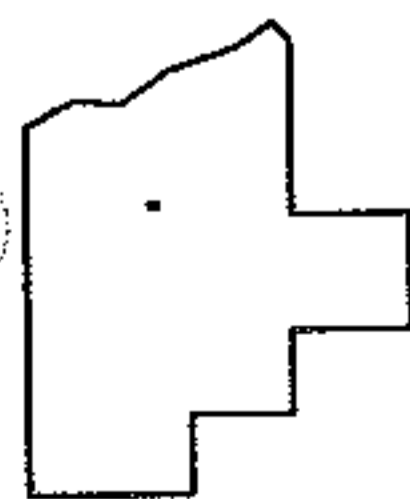
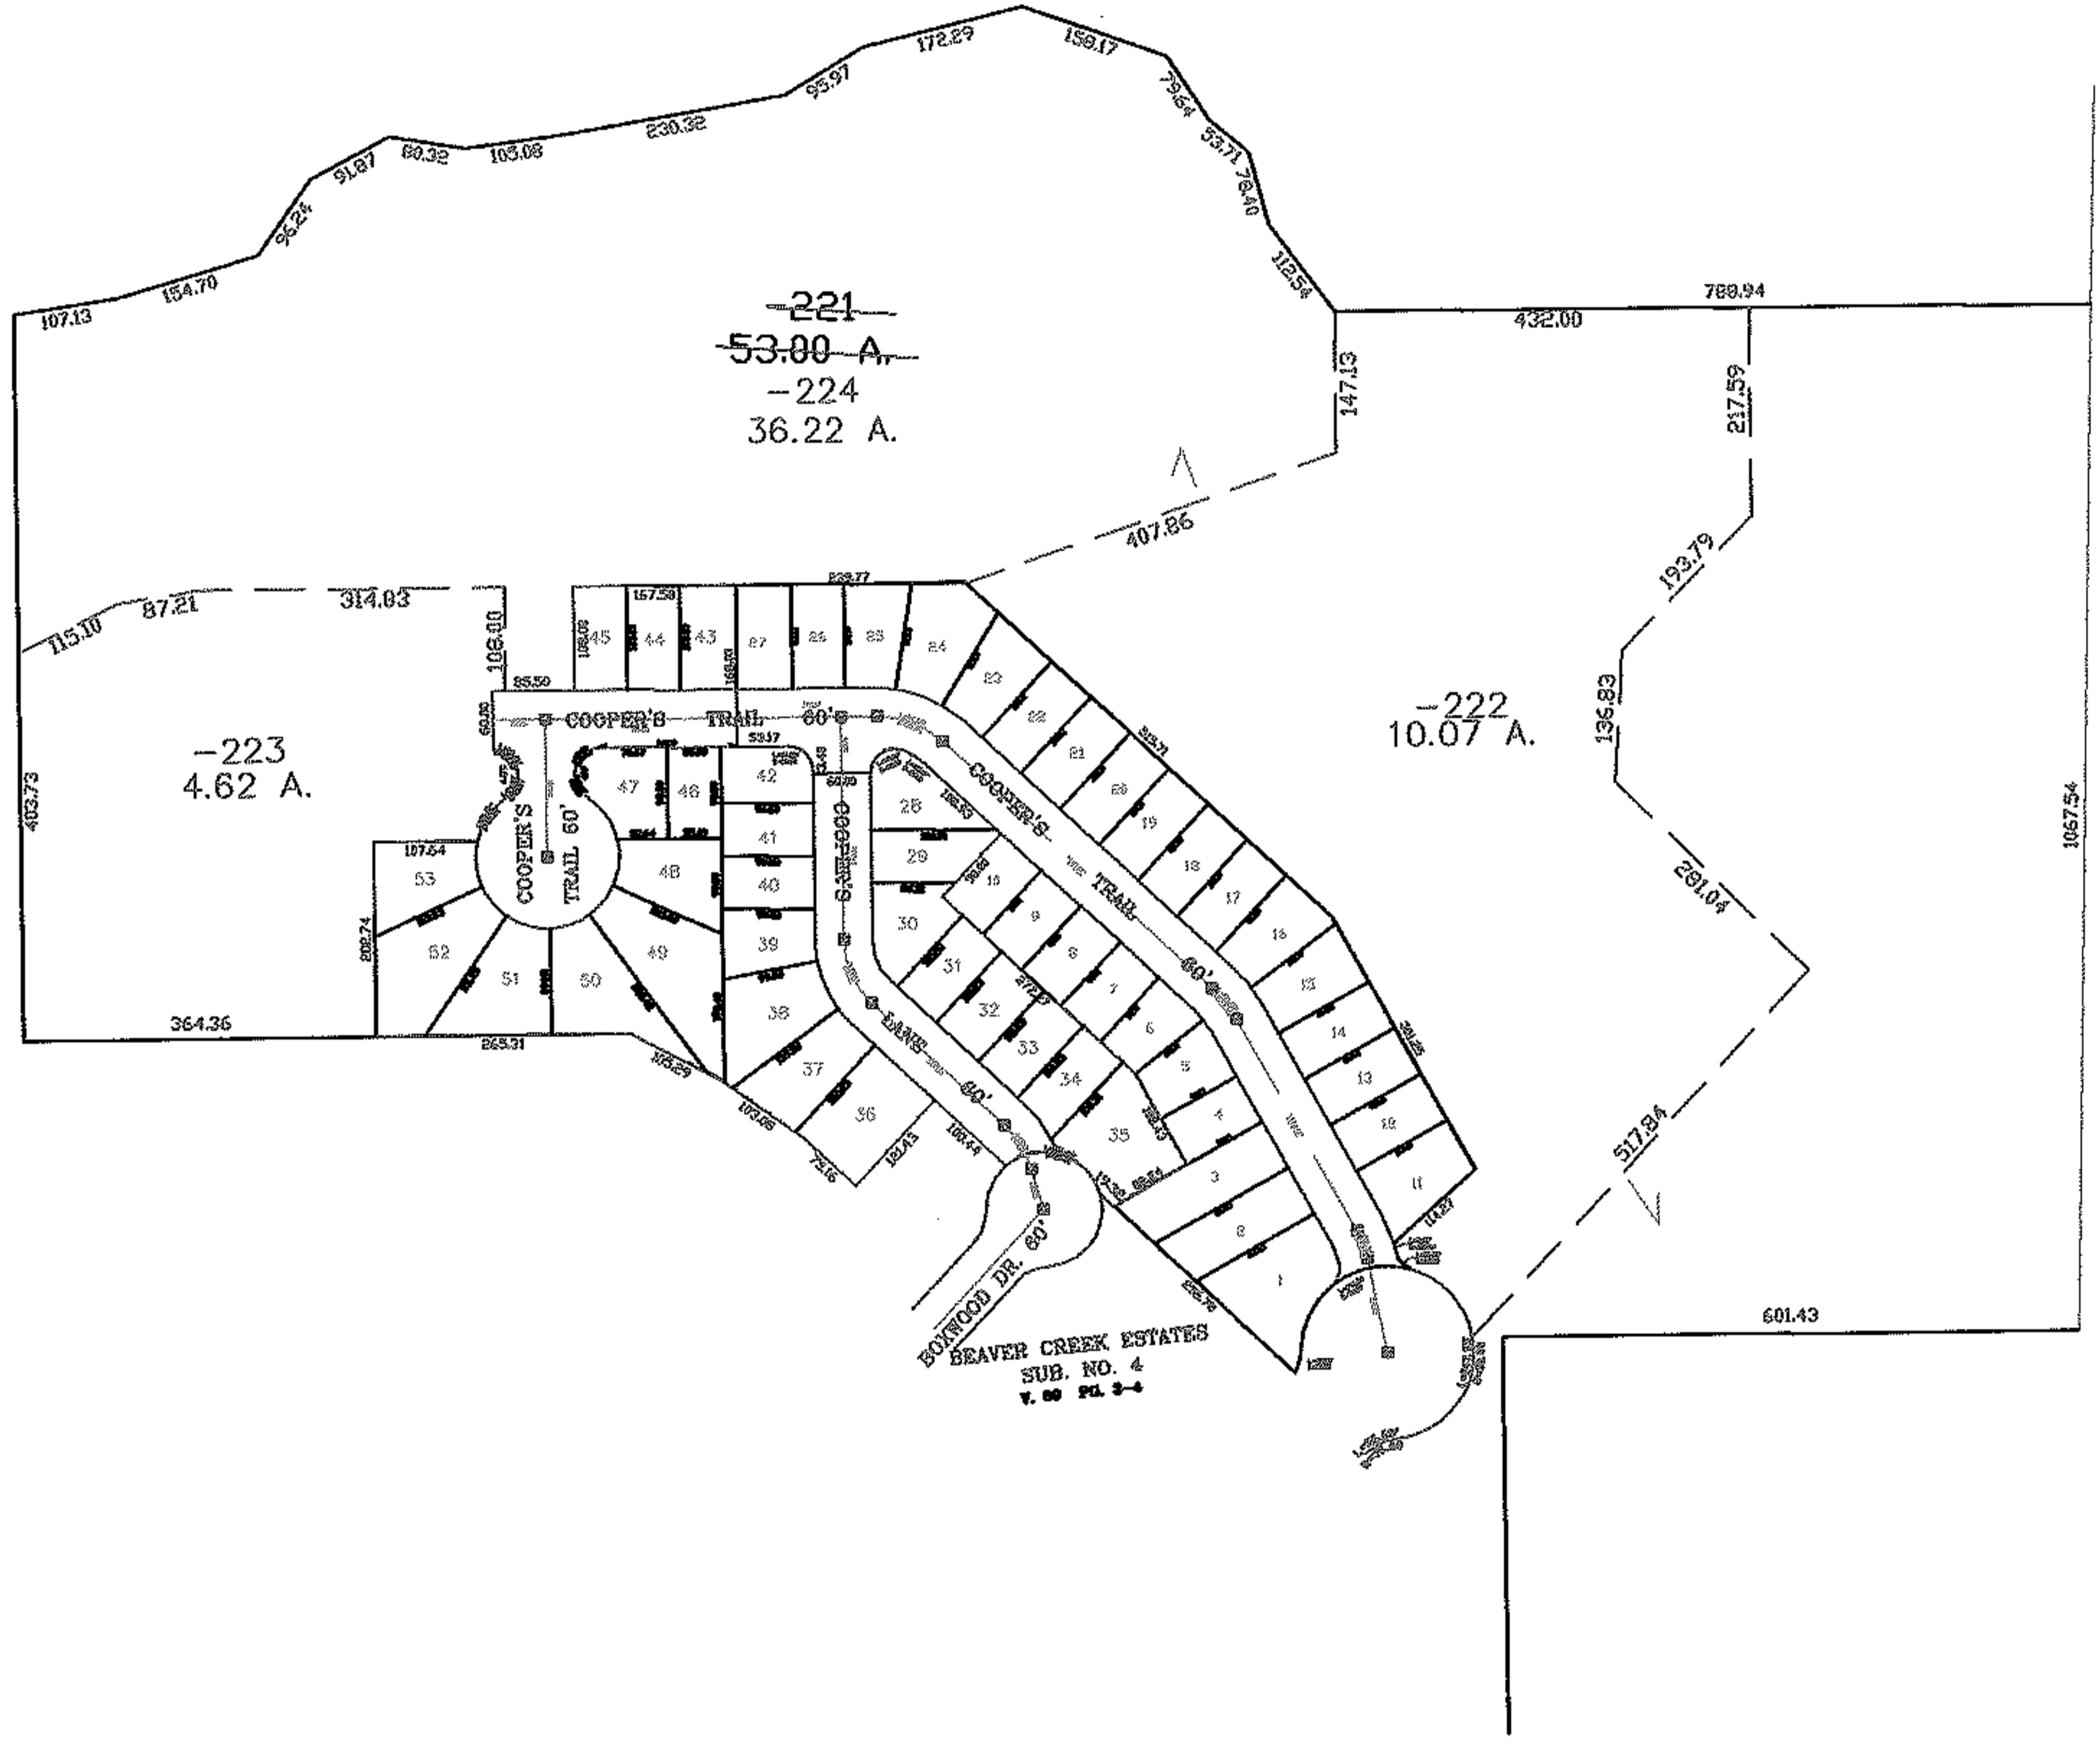


PARENT PARCEL: 02-02-002-000-221
 CHILD PARCEL: 02-02-002-000-222 THRU -224
 STARTING POINT: SOUTHERLY CORNER OF S/L 11 IN COOPER'S LANDING CLUSTER DEV NO 1

07-02324

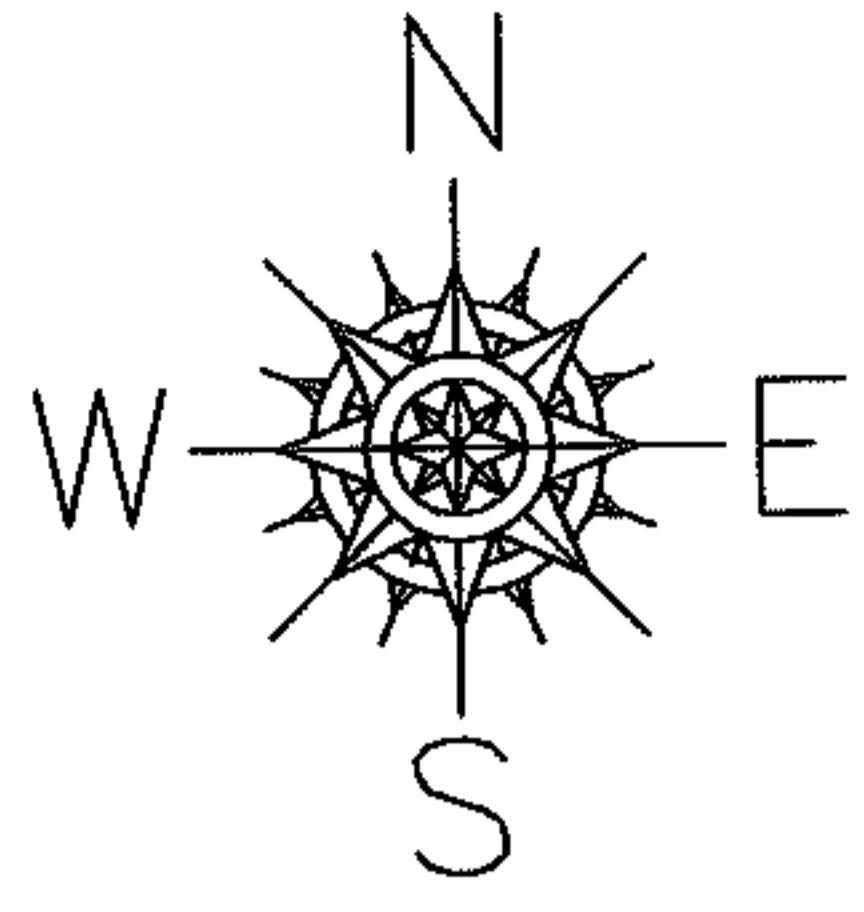

SPLITS/DEEDS PROCESSED
 LORAIN COUNTY TAX MAP DEPARTMENT
 226 MIDDLE AVE. ELYRIA, OHIO

SURVEYED BY: DAVID ELWELL
 CLOSURE: 0.00 : 10.000
 MAP PAGE(S): 02-02-002-B
 APPROVED BY: JAH DATE: 2-7-07
 SCALE: 1" = 300 PRIOR INSTRUMENT: PL VL 80/65