


PARENT PARCEL: 18-00-045-000-013

CHILD PARCEL: 18-00-045-000-037, -038

STARTING POINT: CENTERLINE OF QUARRY RD & MEDINA-NORWALK RD

07-02326

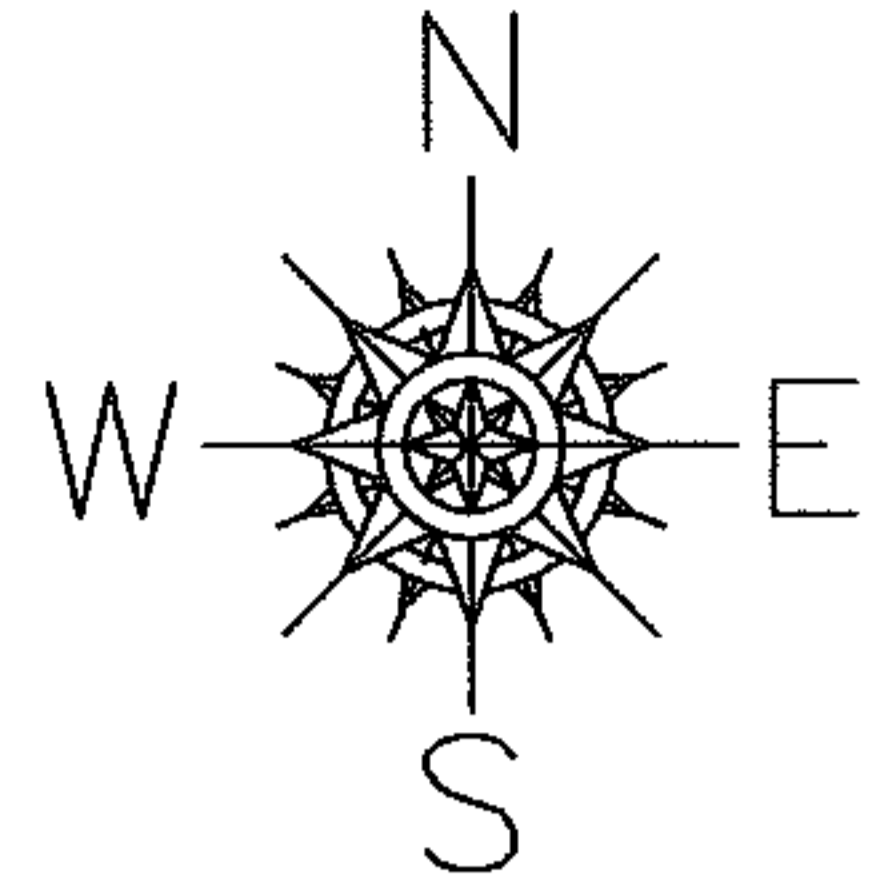

QUARRY RD

MEDINA-NORWALK RD

480.60

200.00


480.60

1911.22

200.00

-037
2.21 A.

~~-013~~
~~51.00 A.~~
~~-038~~
48.79 A.

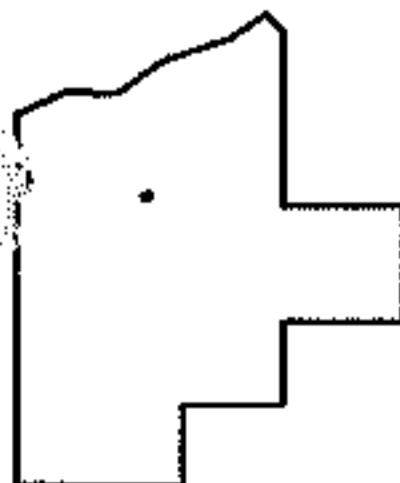

SPLITS/DEEDS PROCESSED

LORAIN COUNTY TAX MAP DEPARTMENT
226 MIDDLE AVE. ELYRIA, OHIO

SURVEYED BY: RICHARD CARLSON

CLOSURE: 0.00 : 10.000

MAP PAGE(S): 18-A

APPROVED BY: JAH DATE: 2-09-07

SCALE: 1" = 100 PRIOR INSTRUMENT: 20060134435