


PARENT PARCEL: 09-00-035-000-007



CHILD PARCEL: 09-00-035-000-008 THRU -010

STARTING POINT: CENTERLINE OF OBERLIN NORTH RD & O.L. 35

07-02328

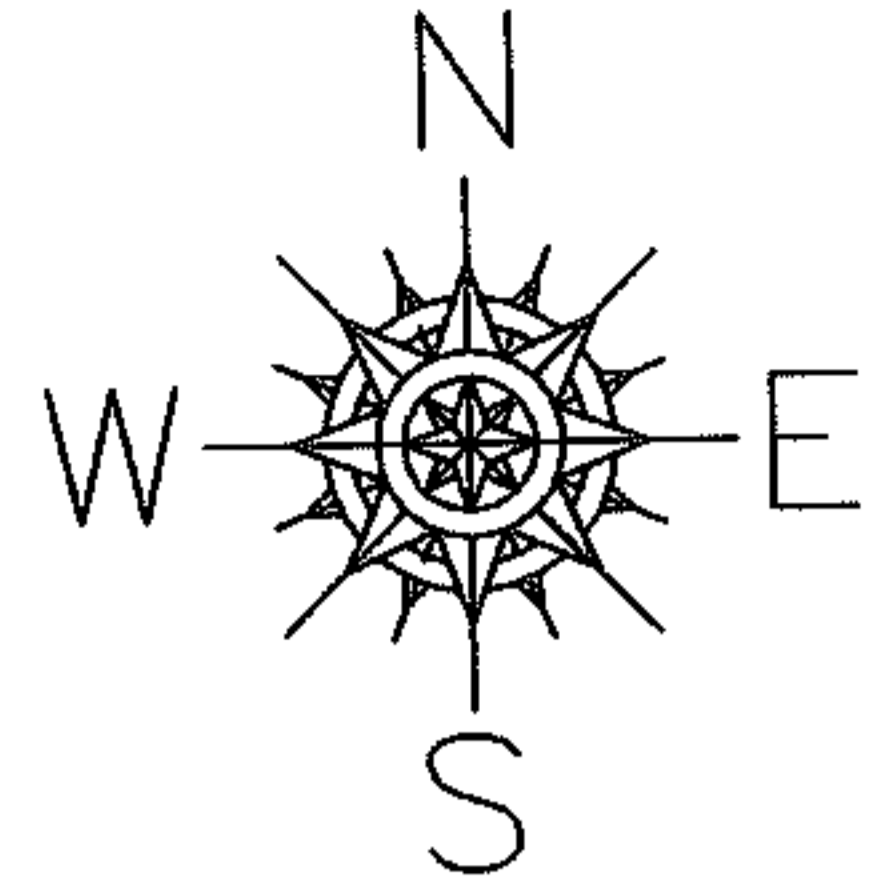

~~=007-~~  
~~64.62 A.~~  
-010  
59.62 A.

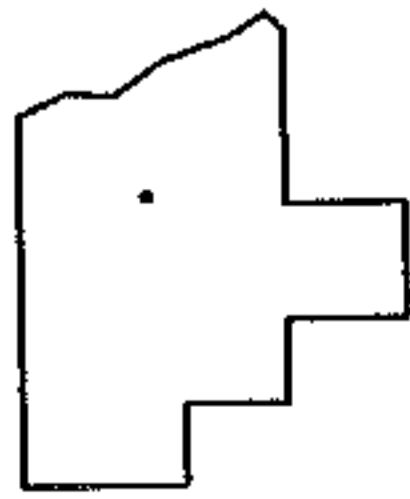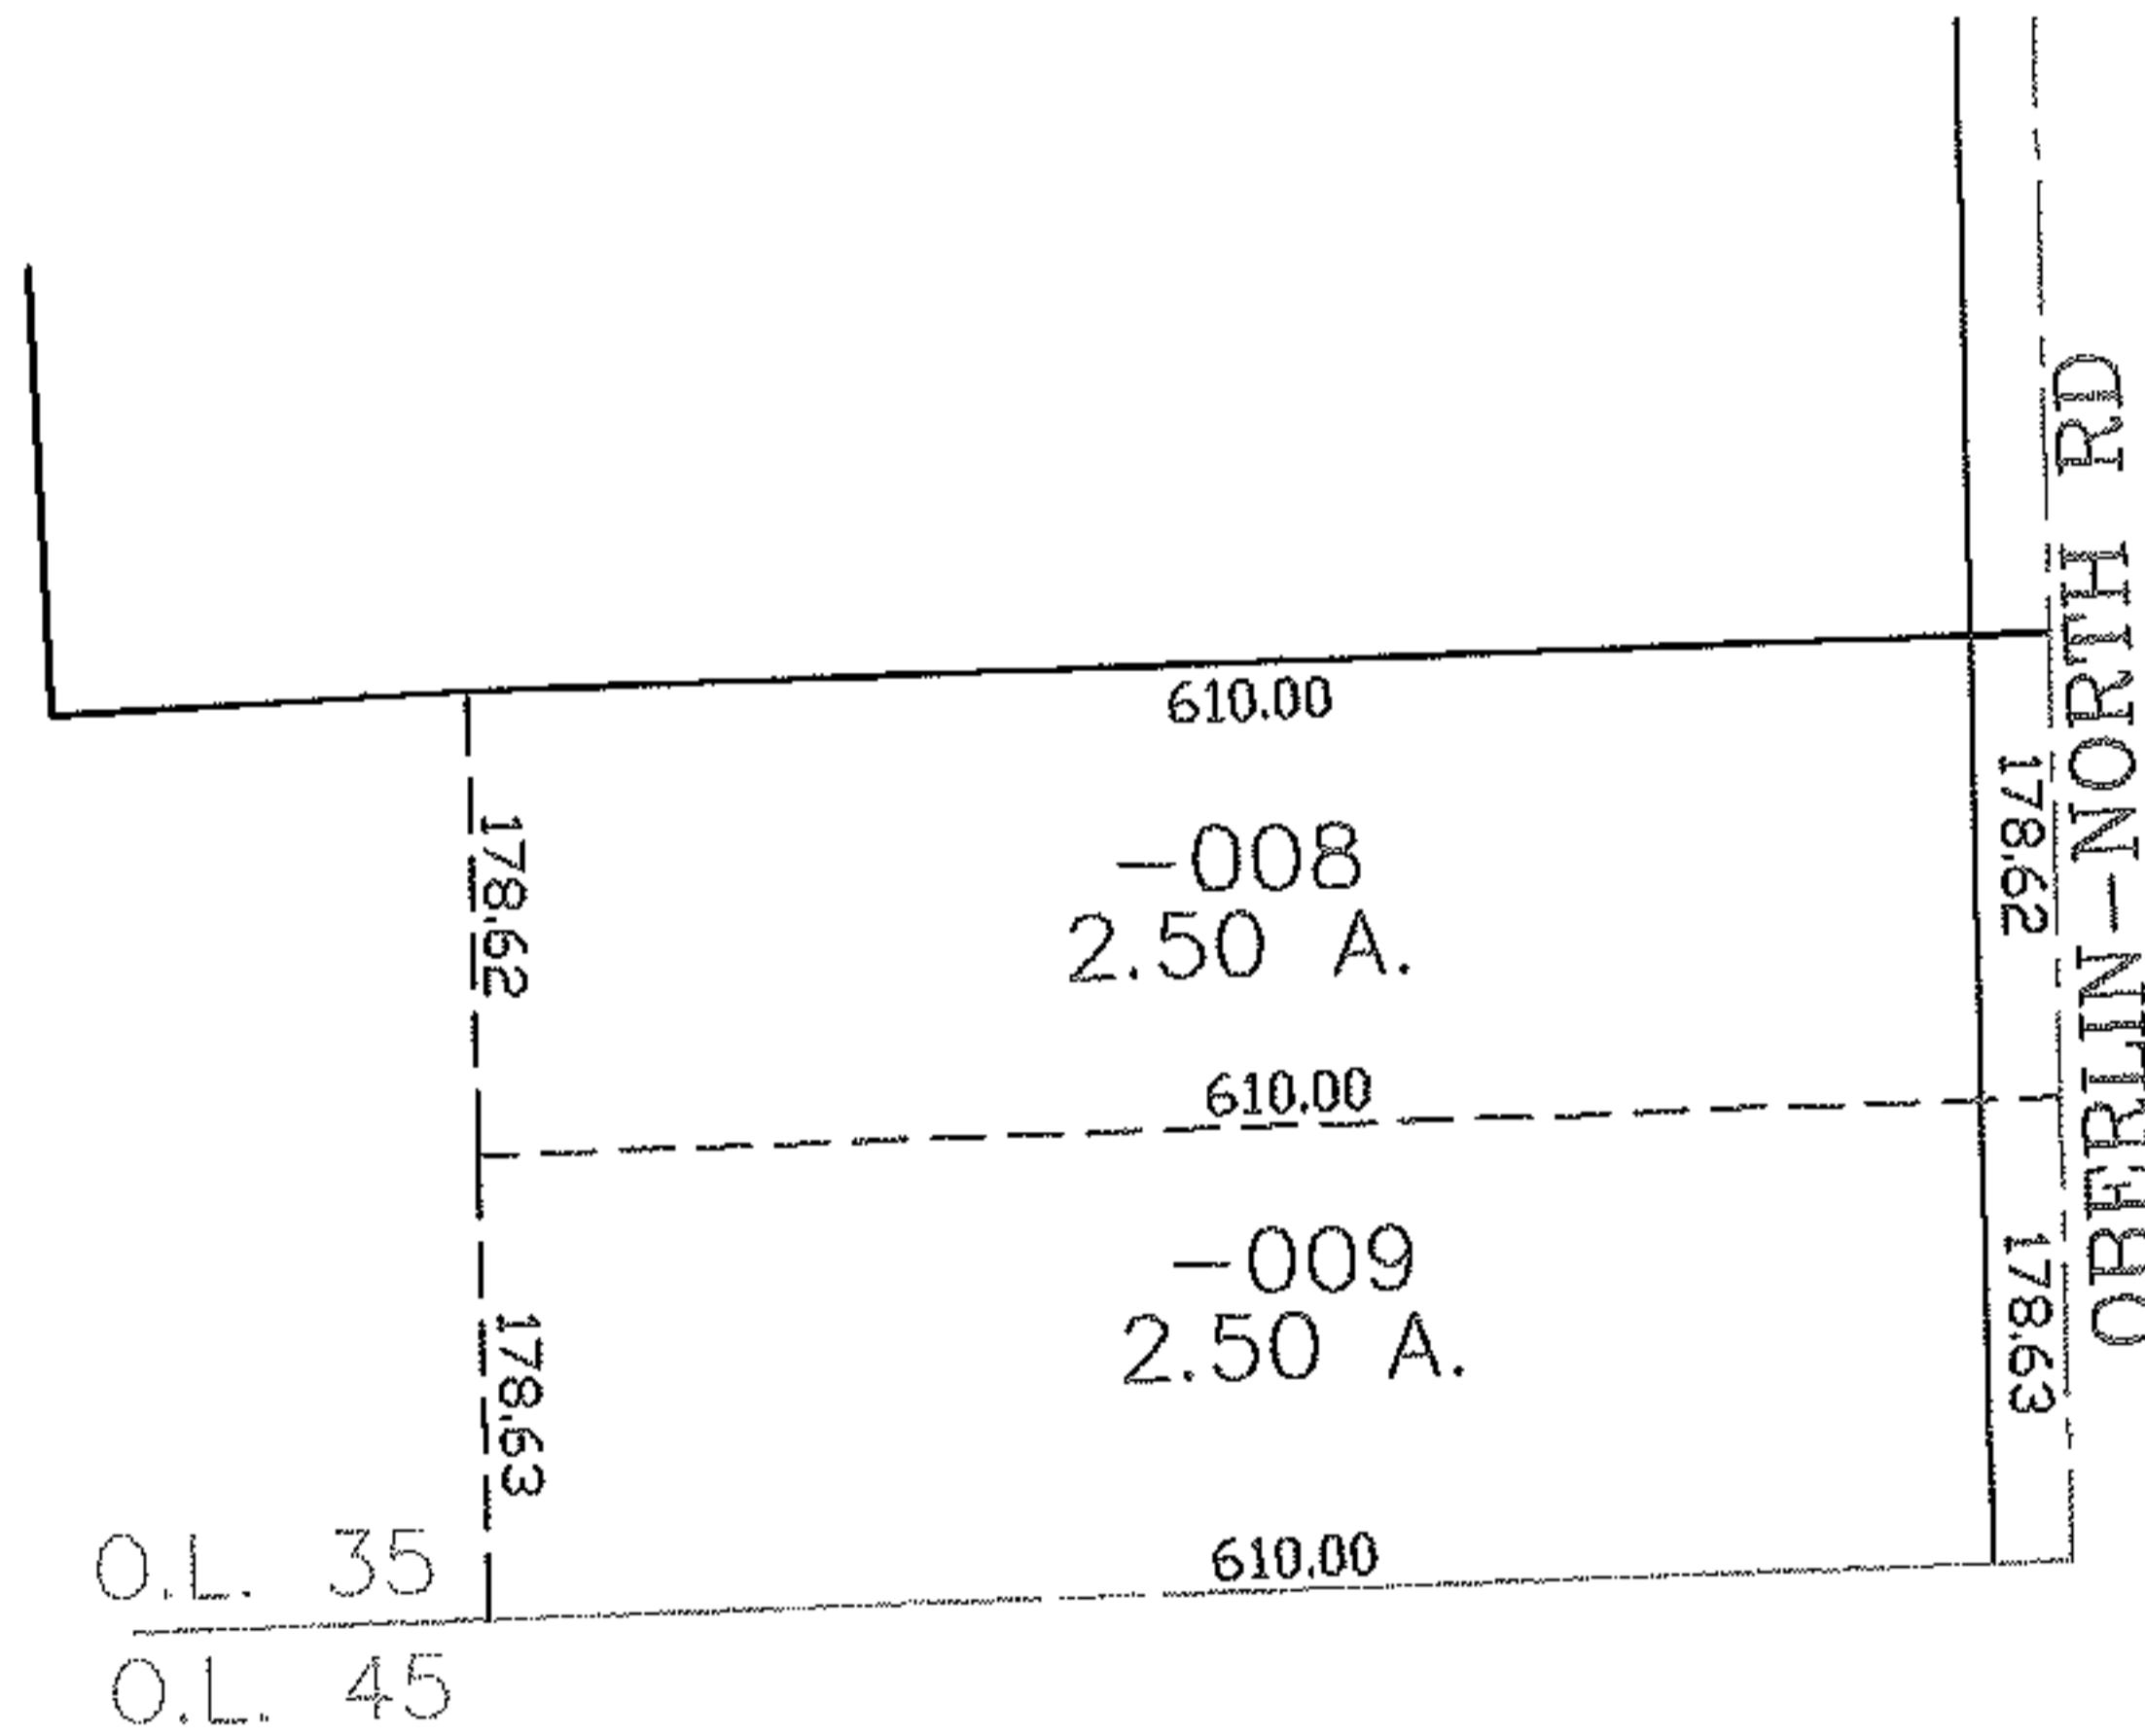

**SPLITS/DEEDS PROCESSED**

LORAIN COUNTY TAX MAP DEPARTMENT  
226 MIDDLE AVE. ELYRIA, OHIO

SURVEYED BY: THOMAS SIMON

CLOSURE: 0.00 : 10.000

MAP PAGE(S): 9-00-035-A

APPROVED BY: JAH DATE: 2-13-07

SCALE: 1" = 200 PRIOR INSTRUMENT: 20040046798