


PARENT PARCEL: 01-00-079-000-013, 01-00-078-028


CHILD PARCEL: 01-00-079-000-050, -051

STARTING POINT: CENTERLINE OF PORTMAN RD & O.L. 79

07-02330

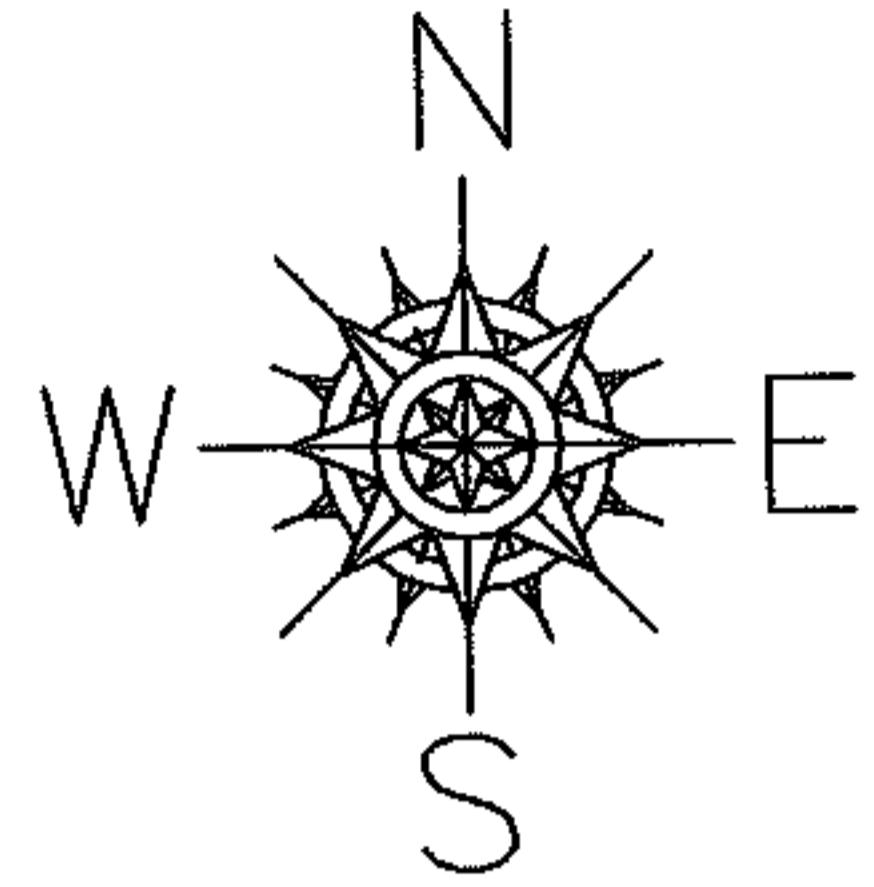

MANTEL ROCK EST SUB
VOL 67/25

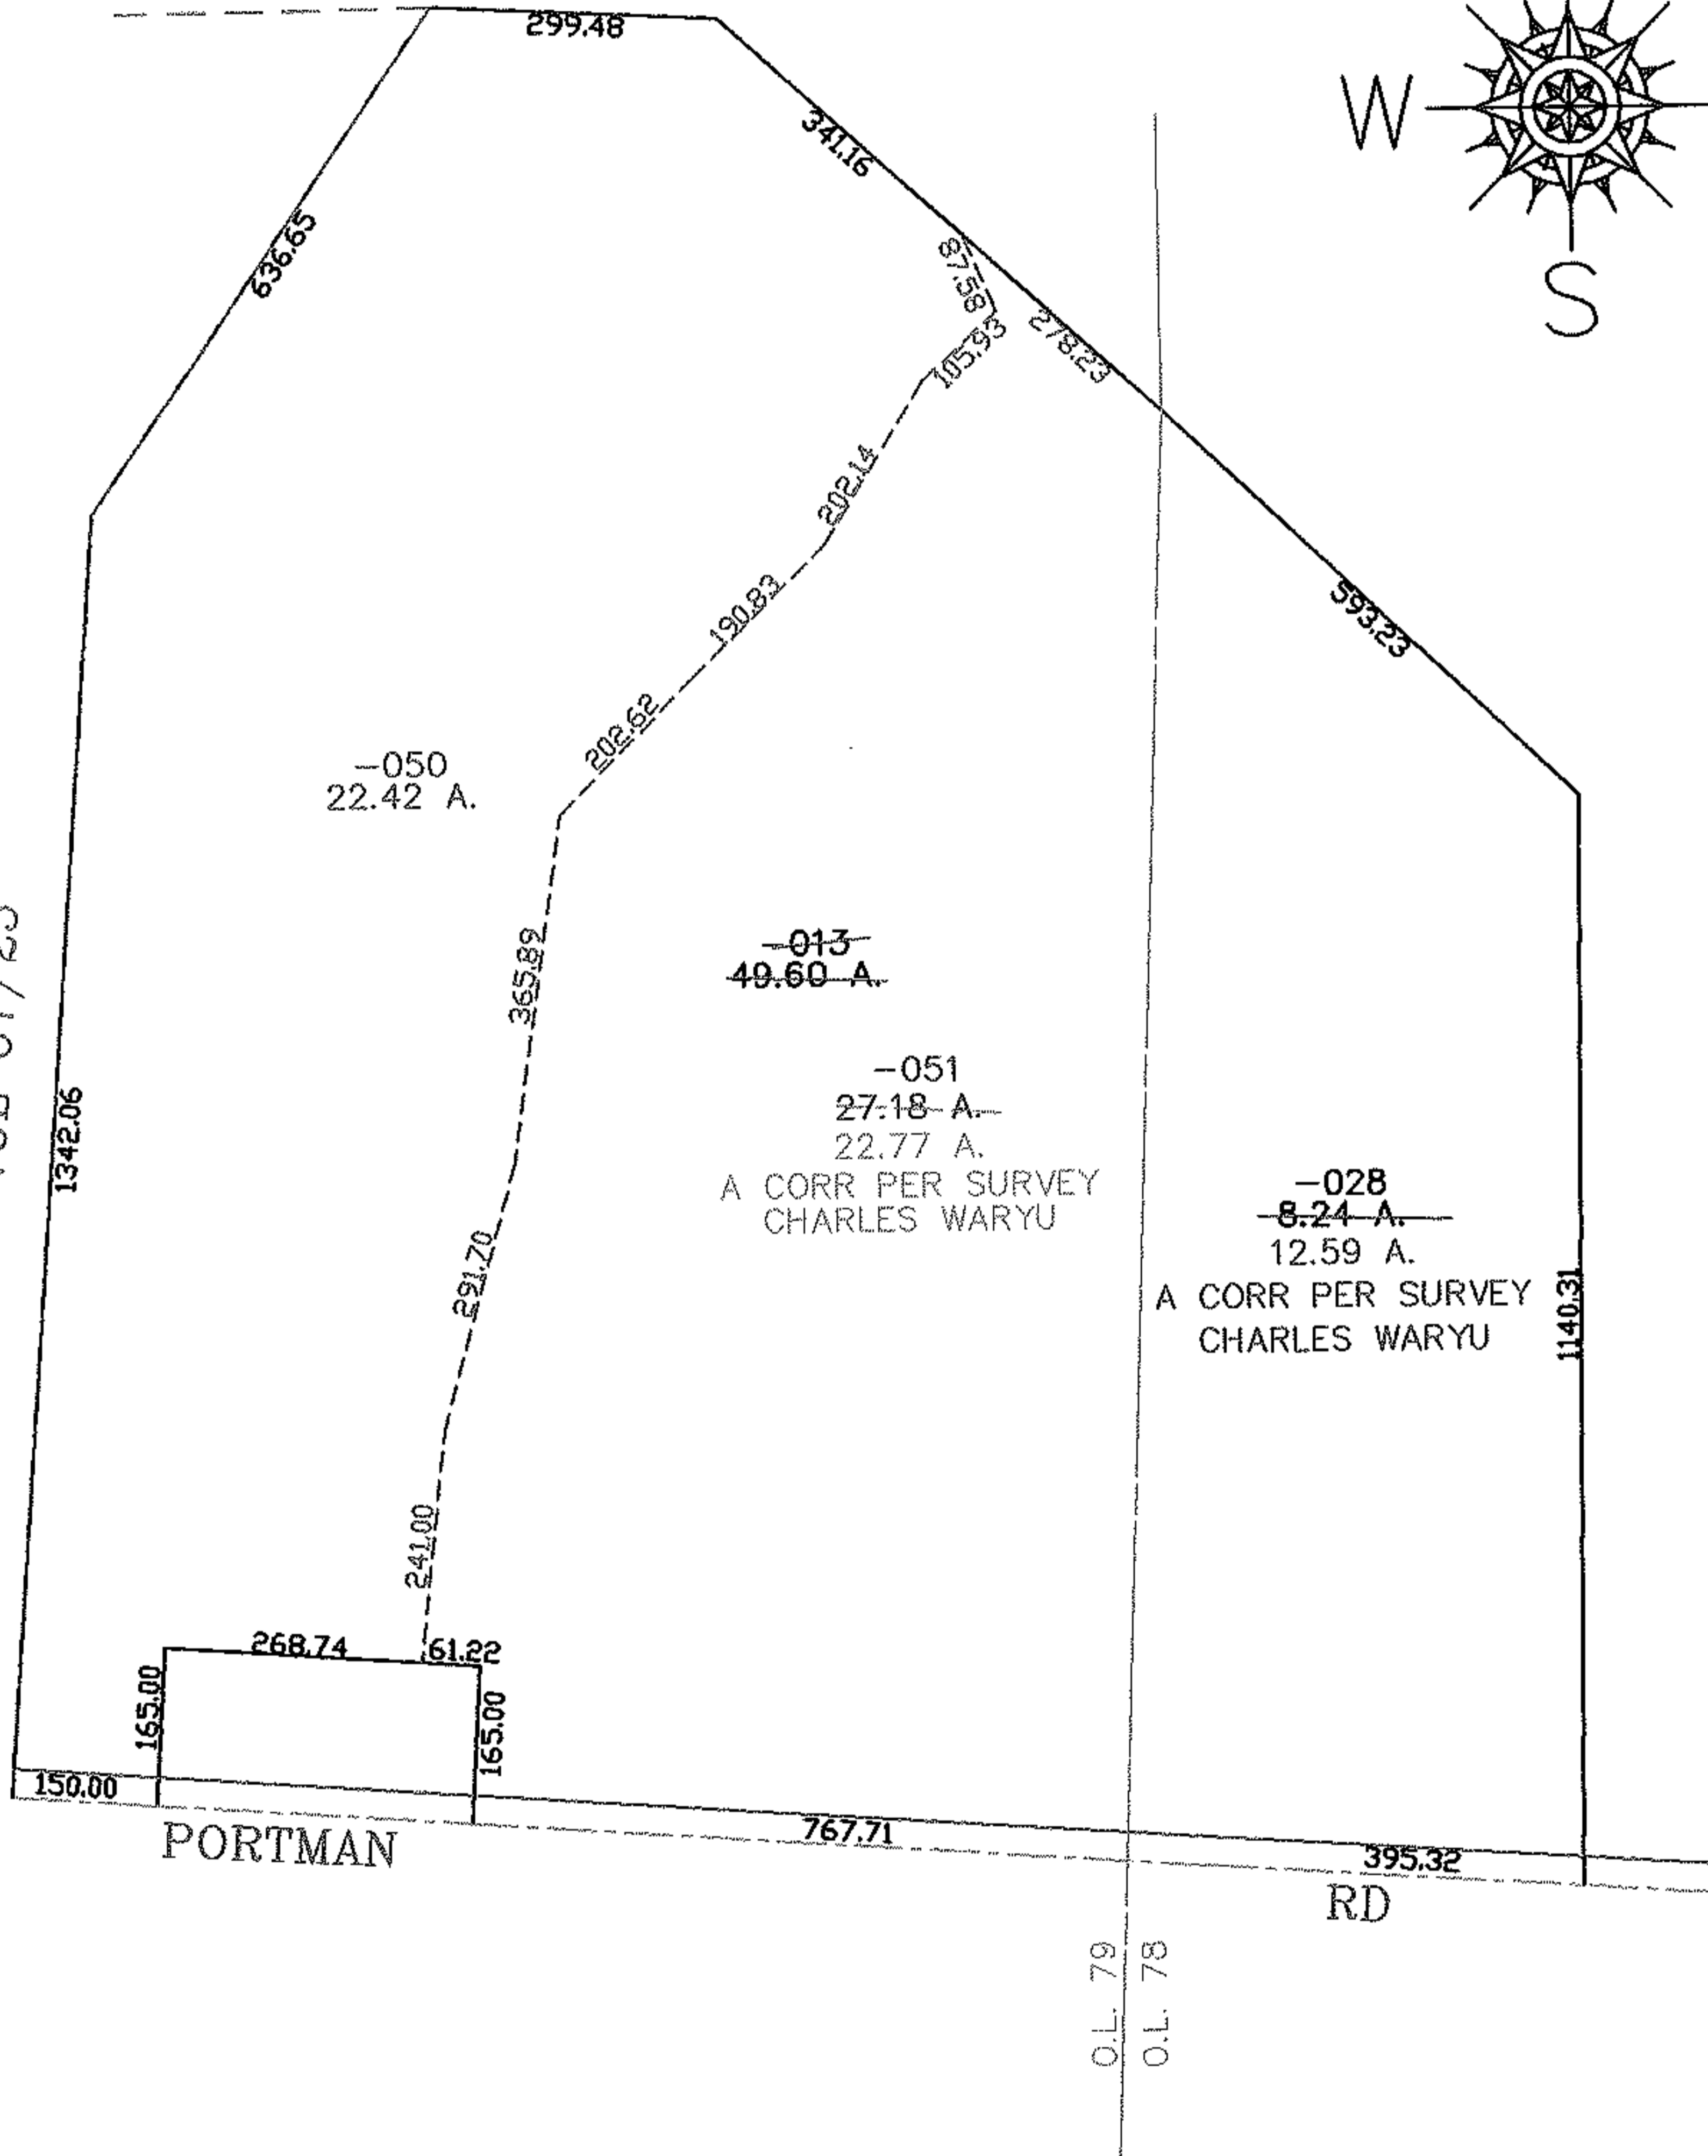

299.48

636.65

341.16

87.58

278.23

105.93

593.23

1342.06

202.62

190.83

202.14

202.14

365.89

291.70

241.00

61.22

268.74

165.00

165.00

150.00

767.71

395.32

1140.31

PORTMAN RD

O.L. 79


O.L. 78

-050
22.42 A.

-013
49.60 A.

-051
27.18 A.
22.77 A.
A CORR PER SURVEY
CHARLES WARYU

-028
~~8.24 A.~~
12.59 A.
A CORR PER SURVEY
CHARLES WARYU

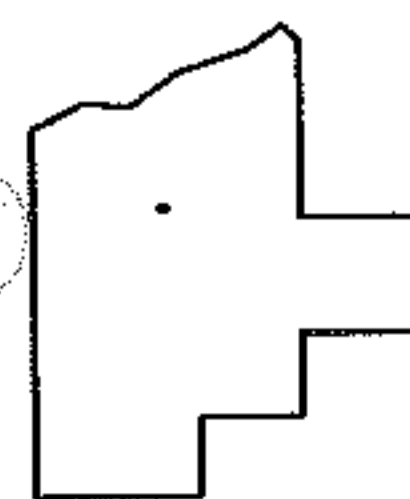

SPLITS/DEEDS PROCESSED

LORAIN COUNTY TAX MAP DEPARTMENT
226 MIDDLE AVE. ELYRIA, OHIO

SURVEYED BY: CHARLES WARYU

CLOSURE: 0.00 : 10.000

MAP PAGE(S): 01-00-079-A

APPROVED BY: JAH DATE: 2-15-07

SCALE: 1" = 300 PRIOR INSTRUMENT: 20060173114