
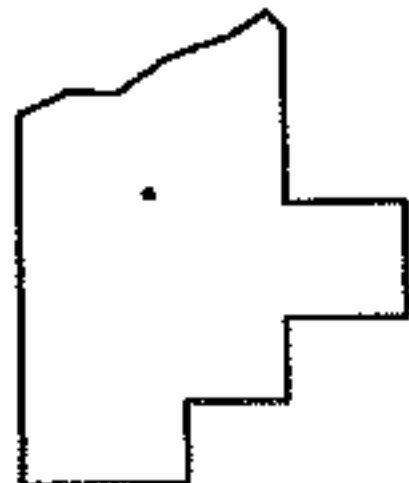
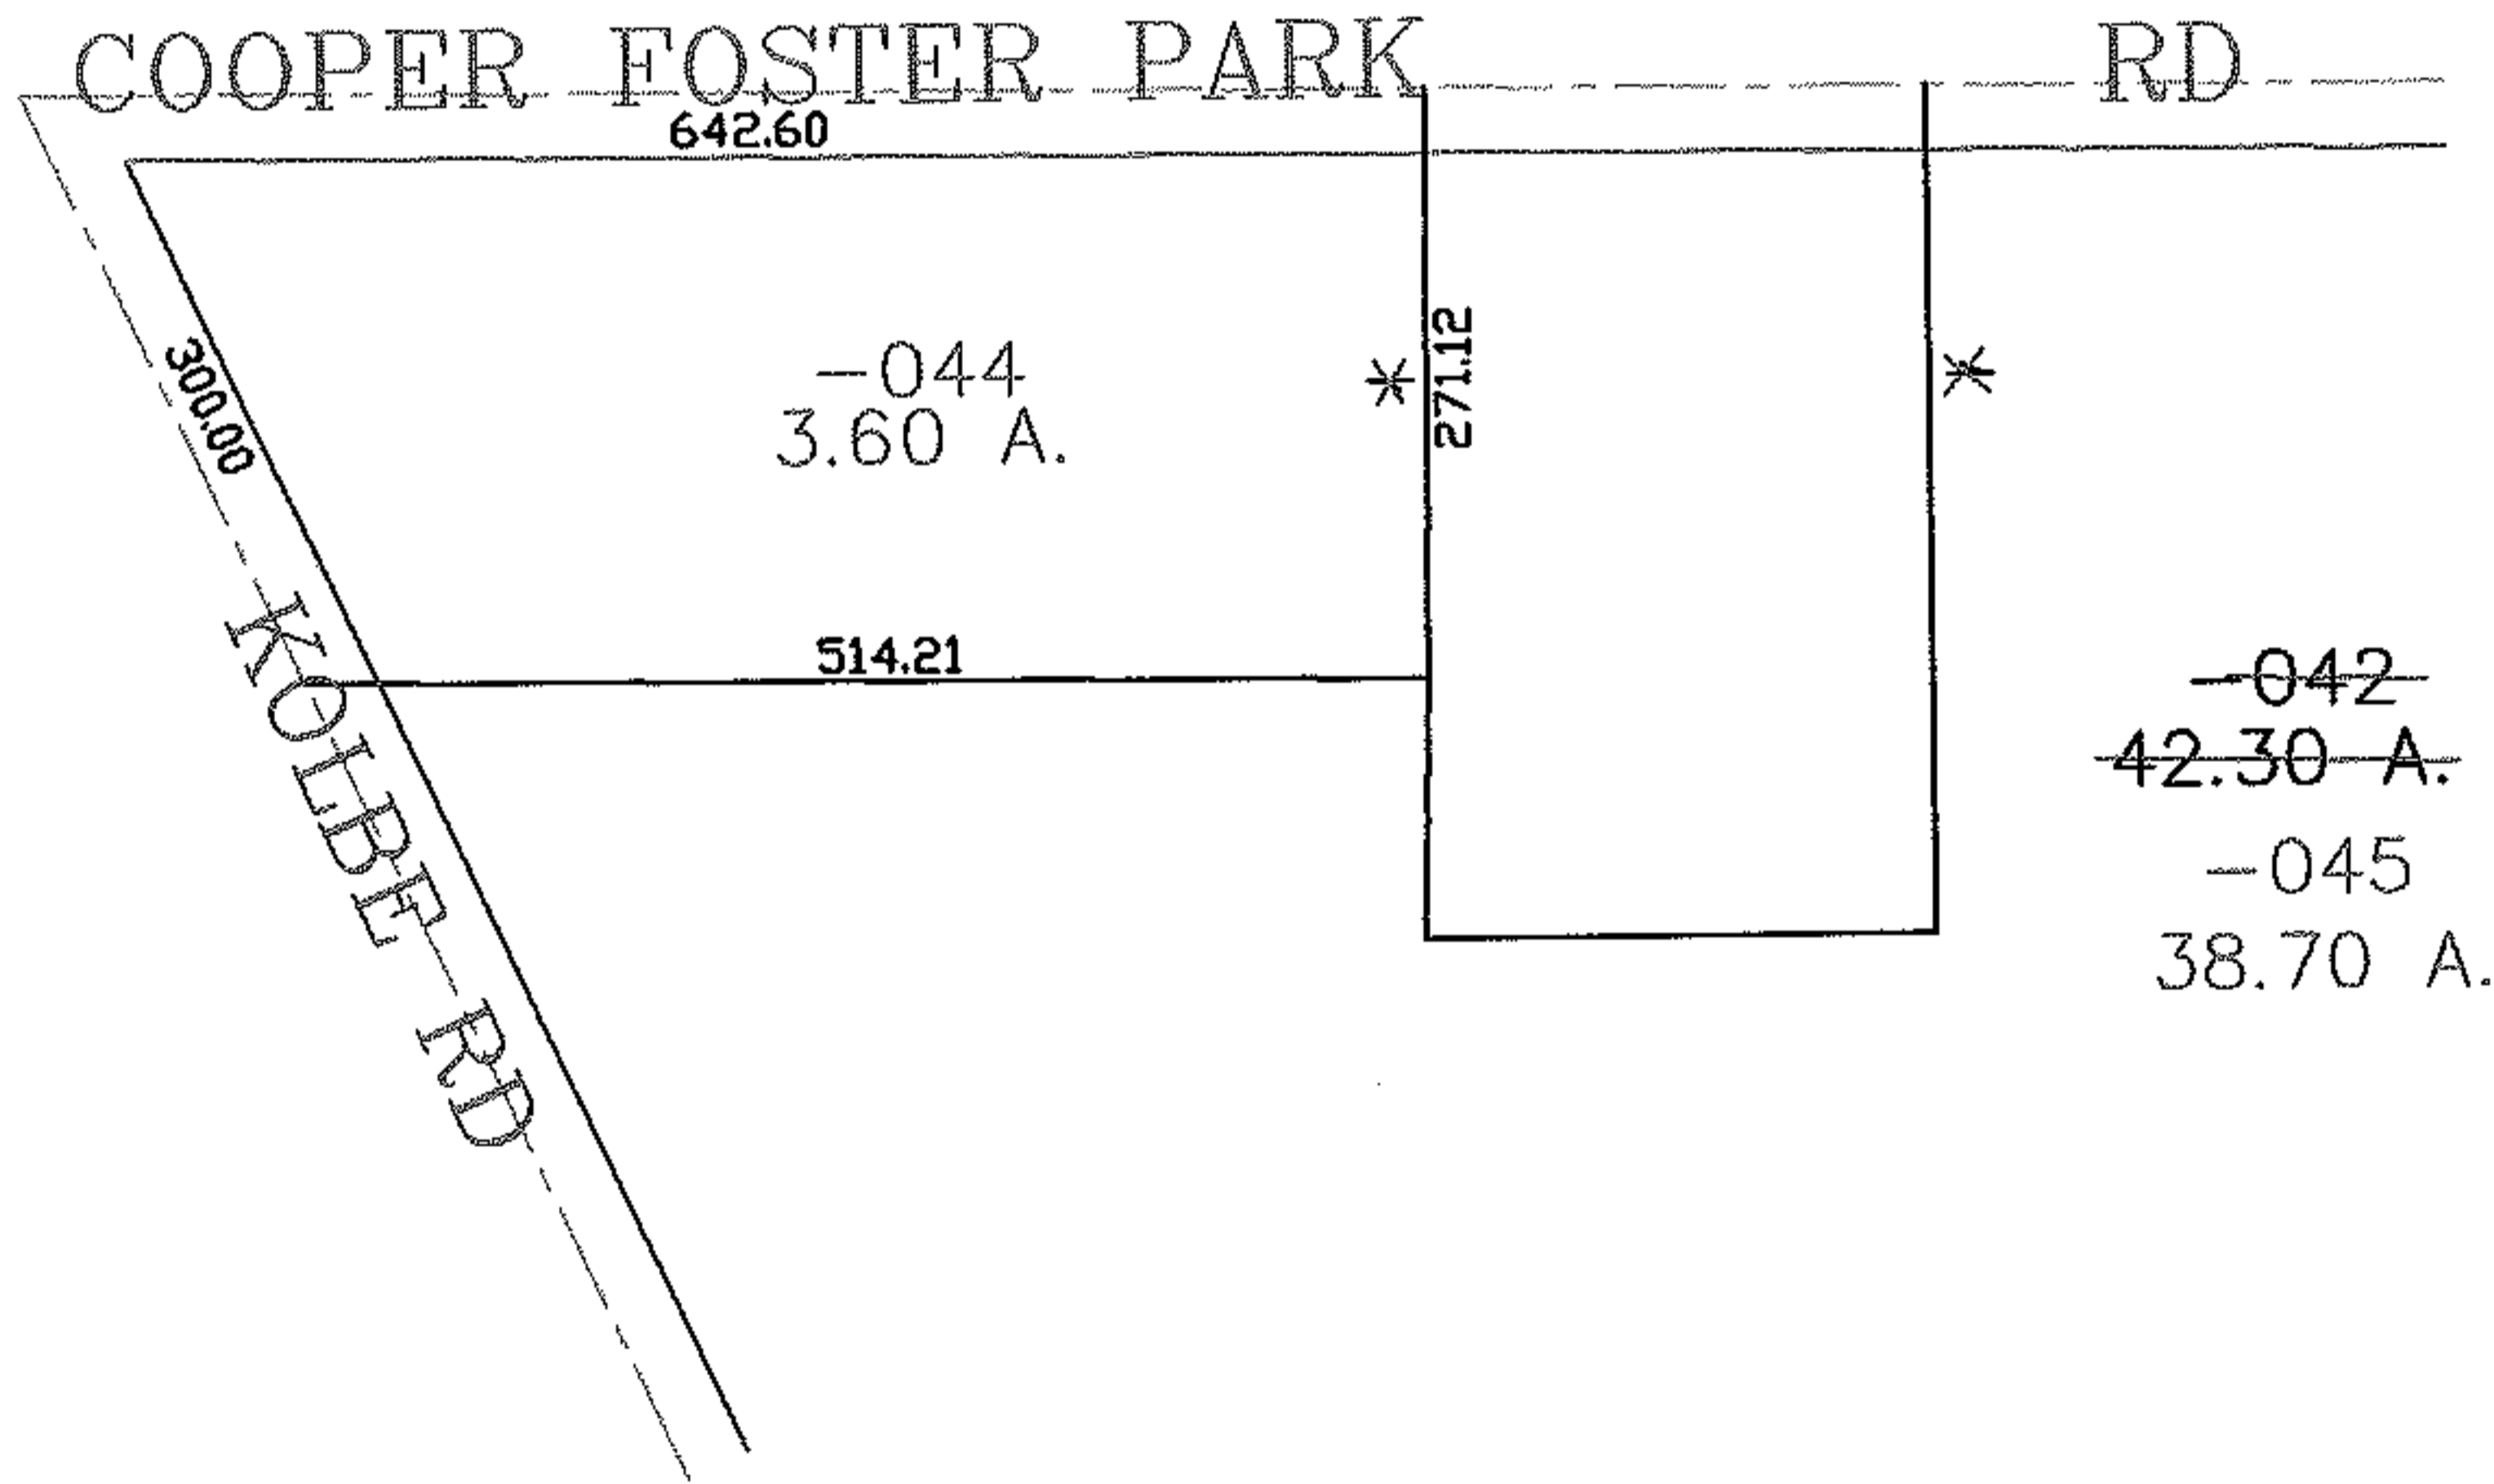


PARENT PARCEL: 05-00-021-103-042

CHILD PARCEL: 05-00-021-103-044, -045

STARTING POINT: CENTERLINE OF COOPER FOSTER PARK RD & KOLBE RD

07-02331

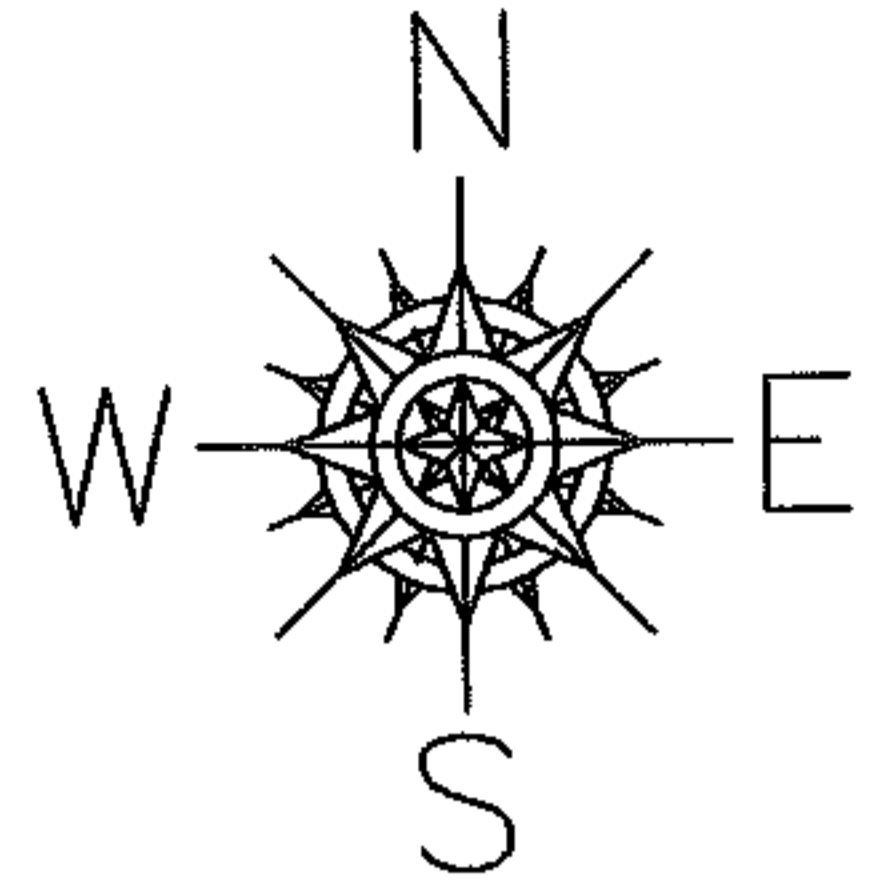

**SPLITS/DEEDS PROCESSED**  
 LORAIN COUNTY TAX MAP DEPARTMENT  
 226 MIDDLE AVE. ELYRIA, OHIO

SURVEYED BY: DALE HAYWOOD  
 CLOSURE: 0.00 : 10.000  
 MAP PAGE(S): 05-00-021-B  
 APPROVED BY: JAH DATE: 3-7-07  
 SCALE: 1" = 200' PRIOR INSTRUMENT: 20060121418